



ADDENDUM 04

Date: March 17, 2022

To: All Proposers

From: Schwarz Hanson Architects

Project Name: Gregg County Parking Garage and Office

SHA Project No.: 20011

03.17.2022



This notice shall be considered to be part of the contract documents for the project referenced above. Where provisions of the following supplemental information differ from that contained in the original contract documents, this notice shall govern and take precedence. Proposers are hereby notified to make any necessary adjustments in their estimate on account of this notice. It will be construed that each Proposer's proposal is submitted with full knowledge of all modifications and supplemental data specified therein.

Updated Items not related to specific questions:

- Sheet A1.1 was updated to revise the NE corner annotations related to the generator and power.
- For the sake of naming consistency and clarity, the date and the words "Addendum 01" located within the titleblock of all addendum sheets issued out on 03/09/2022, as a part of Addendum 03, were revised to read "Addendum 03" and re-dated to 03/09/22. We wanted to make sure it was clear that the revised sheets issued with addendum 03 were named properly in accordance with the naming structure observed on the public advertisement, here: <https://www.co.gregg.tx.us/construction-manager-risk-cmar-gregg-county-parking-facility-project>

NOTE: Sheets that were revised and re-issued/appended to Addendum 04 include:

(G0.1, A1.1, A2.1, A2.2, A2.3, A2.5, A2.6, A2.7, A2.8, A3.1, A3.2, A3.3, A4.2, A4.3, A5.0, A5.5, A6.1, A8.1)



Architecture RFI Questions and Responses (#s A1-A19):

Question #A1: (SUBSTITUTION REQUEST) Will the Architect allow Hager Co. to be substituted for all applicable exit device hardware?

Response #A1: We take no exception to the bidder(s) submitting Hager Co. as an alternative manufacturer substitution during the bidding phase, though final approval/rejection will be determined during construction phase.

Question #A2: (SUBSTITUTION REQUEST) Will the Architect allow Rocky Mountain Metals to be substituted for all applicable hollow metal doors, frames, and windows?

Response #A2: We take no exception to the bidder(s) submitting Rocky Mountain Metals as an alternative manufacturer substitution during the bidding phase, though final approval/rejection will be determined during construction phase.

Question #A3: (SUBSTITUTION REQUEST) Will the Architect allow Accurate Partitions to be substituted for all applicable toilet partitions?

Response #A3: We take no exception to the bidder(s) submitting Accurate Partitions as an alternative manufacturer substitution during the bidding phase, though final approval/rejection will be determined during construction phase.

Question #A4: (SUBSTITUTION REQUEST) Will the Architect allow OSHKOSH Door Co. to be substituted for all applicable wood doors?

Response #A4: We take no exception to the bidder(s) submitting OSHKOSH Door Co. as an alternative manufacturer substitution during the bidding phase, though final approval/rejection will be determined during construction phase.

Question #A5: (SUBSTITUTION REQUEST) Will the Architect allow JL Industries / Activar Inc. to be substituted for all applicable Fire Extinguishers?



Response #A5: We take no exception to the bidder(s) submitting JL Industries / Activar Inc. as an alternative manufacturer substitution during the bidding phase, though final approval/rejection will be determined during construction phase.

Question #A6: Please identify any items to be salvaged or retained for the Owner that are scheduled to be demoed.

Response #A6: Refer to Sheet A1.0

Question #A7: Door #'s 159A and 159B lists the door type as type 'G1', but I don't see a 'G1' door type/elevation on sheet A6.1. Please clarify.

Response #A7: We revised the door schedule and door type elevations on sheet A6.1 to include a Type D6 door elevation for the secured access pedestrian gates.

Please refer to the revised sheet(s) A6.1 issued/appended with Addendum 04.

Question #A8: Regarding door #123 on the door schedule, please provide all missing information.

Response #A8: We revised the door schedule on Sheet A6.1 to include the missing information regarding door 123. Storefront type W07 on Sheet A6.1 was revised to reflect the correct storefront elevation. The storefront frame associated with door # 102 was revised to type W09 on Sheet A2.6 & the door schedule on Sheet A6.1.

Please refer to the revised sheet(s) A6.1 issued/appended with Addendum 04.

Question #A9: If it's an A133 contract, how will the one line item, lump sum, dollar amount "base bid price" per the bid proposal be addressed in the contract? In short, will it be a standalone lump sum not subject to typical A133 conditions, OR will it in fact be structured as a typical A133 GMP on a cost & fee basis with additional considerations for components like general conditions?



Response #A9: Please refer to the A133 contract located at the link below:
<https://www.aiacontracts.org/contract-documents/6232027-owner-construction-manager-as-constructor-agreement>

Question #A10: Note H on sheet A3.1 provides sizes for aluminum louvers, but there are no specifications providing acceptable manufacturers and performance requirements. Please provide specifications for the aluminum louvers spanning the height of the structure between precast panels.

Response #A10: Please refer Sheets A2.1-A2.5 for opening width dimensions. Please refer to Sheets A3.1-A3.2 for height dimensions and note 'H' which provides the design criteria the extruded aluminum tube (vertical fins) need to meet.

We take no exception to the bidder(s) sourcing and submitting " [blank] " as an alternative manufacturer substitution during the bidding phase, though final approval/rejection will be determined during construction phase.

Question #A11: The plans show (2) security grilles in the Lobby/Retail area that are note on the door schedule. Can you provide door or opening sizes for these?

Response #A11: Sheets A2.1 & A2.6 have been revised to indicate the correct door type numbers and section detailing for these doors. The door elevations related to these two doors, on sheet A6.1, has been revised to read door type 'D8'. Additionally, wall section 10/A4.3 was added to the set.

Please refer to the revised sheet(s) A2.1, A2.6, A4.3 & A6.1 issued/appended with Addendum 04.

Question #A12: There appears to be a discrepancy regarding a masonry wall at NE stair #362. Per attached portion of sheet A2.3, you can see a masonry wall shown just inside the exterior precast panel. However, per enlarged stair plan 3/A4.8, this masonry wall is not shown at all. Please clarify.

Response #A12: Wall was removed on sheet A2.3. Plan view 3/A4.8 is correct.

Please refer to the revised sheet(s) A2.3 issued/appended with Addendum 04.

Question #A13: Please have Architect provide an elevation of the millwork located on the West wall of 'Copy/Print' room 126.

Response #A13: We have revised elevation 27/A8.1 to show the correct millwork/annotations. Additionally, elevation 41/A8.1 was added to the set.

Please refer to the revised sheet(s) A2.6 & A8.1 issued/appended with Addendum 04.

Question #A14: I do not see a specification section for the vertical aluminum louvers (note 'H' on sheet A3.1). Please clarify.

Response #A14: Please refer Sheets A2.1-A2.5 for opening width dimensions. Please refer to Sheets A3.1-A3.2 for height dimensions and note 'H' which provides the design criteria the extruded aluminum tube (vertical fins) need to meet.

We take no exception to the bidder(s) sourcing and submitting " [blank] " as an alternative manufacturer substitution during the bidding phase, though final approval/rejection will be determined during construction phase.

Question #A15: Please have the Architect provide more information for the clouded items on the attached garage entry plan.

Response #A15: Sheet A2.8 was revised to show more annotations regarding the clouded bollards and vehicle entry equipment. Also, refer to sheet(s) AG101, S101, & E401 for further clarification.

Please refer to the revised sheet(s) A2.8 issued/appended with Addendum 04.

Question #A16: On the North elevation on sheet A3.1, three of the six large windows are indicated to be window type 'W05'; however, 'W05' shown on sheet A6.1 is simply a transom door frame. These same three windows are also incorrectly marked on enlarged plan sheets A2.6 and A2.7. Please clarify

Response #A16: We revised sheet(s) A2.6, A2.7 & A3.1 to correct the storefronts in question to read type "W04".

Please refer to the revised sheet(s) A2.6, A2.7, A3.1 & A6.1 issued/appended with Addendum 04.

Question #A17: I believe the window on the South wall of 'Veterans Lobby 150' should be type 'W18', not type 'W13'

Response #A17: We revised sheet A6.1, for the window in question, to read type "W18".

Please refer to the revised sheet(s) A6.1 issued/appended with Addendum 04.

Question #A18: We recommend an allowance be identified to cover cost associated with the undefined scope to repair the existing building after removal of the canopy which is attached to the building.

Response #A18: Please refer to sheet(s) C-1 & A1.0. Note that all removal and repair work associated with the; canopy, teller window, cameras, drains, etc, which are attached to the adjacent building on the North side of our site, are to be coordinated by the general contractor with the adjacent property owner. All removal / repair work with the area in question are the responsibility of the adjacent property owner and to be on the adjacent owner's expense.

Please refer to the revised sheet(s) A6.1 issued/appended with Addendum 04.

Question #A19: With regard to the canopy at the NE corner of building, sheet A2.1 refers to this canopy as "Aluminum canopy (above)", however, the right-hand side of elevation 2 on sheet A3.1 refers to this canopy as "Steel canopy", then again on the left-hand side of elevation 1 on sheet A3.1, it shows a section cut 1/A5.2 through this canopy where this 'canopy' is shown as a modified bitumen roof system. Please clarify which of these locations is to be a prefinished aluminum (Avadek) canopy as specified in section 10 73 10.

Response #A19: The canopy over the vehicle entrance is a "Metal Canopy" with structure providing supports, reference the structural drawings. The canopy over the main NW entrance of the office is a "Pre-Manufactured Metal Canopy" intended to be similar to an Avadeck canopy and mounted to the face of precast panels. The canopy at the NE corner of the office is a "Metal Canopy with structure providing supports



and roofed with a mod-bit roof system, reference the structural drawings. The canopy over the elevator lobby room 460 is a "Metal Canopy" with structure providing supports and roofed with a mod-bit roof system. The last and final canopy, located over door #440 is a "Pre-Manufactured Metal Canopy" intended to be similar to an Avadeck canopy and mounted to the face of precast panels.

Please refer to the revised sheet(s) A2.1 – A5.0 issued/appended with Addendum 04.



MEP RFI Questions and Responses (#s M1-M20):

Question #M1: (SUBSTITUTION REQUEST) Specs calls for a Simplex 4004 Conventional Fire Alarm Panel. Requesting that Notifier N16 Inspire Fire Alarm System be accepted as an equal. See attached data sheet.

Response #M1: Notifier is an acceptable substitution.

Question #M2: The specs on this project limit you to Simplex on the fire alarm system. Will there be any opportunity to substitute a different product line for this?

Response #M2: Notifier is an acceptable substitution.

Question #M3: Specification Section 26 02 00 – 2.2 – A says that “EMT conduit shall not be used in any location”. Please advise if this applies to the office area also. Above ceiling and in wall conduit systems are not specifically addressed in this regard.

Response #M3: EMT is allowed in the office area.

Question #M4: Please confirm the following as these specs are not typical to what we normally see: Smallest wire size for power to be #10

Response #M4: Confirmed

Question #M5: Please confirm the following as these specs are not typical to what we normally see: One hole straps to be stainless. Can we use minerlac straps or strut straps? If so do they have to be stainless also?

Response #M5: Use minerlac straps or strut straps in the office area. Use galvanized one hole strap in the parking garage where needed. Most of the conduits will be concealed.

Question #M6: Please confirm the following as these specs are not typical to what we normally see: All connections to panels, boxes, fixtures, and other equipment must have gasketed threaded hubs. Does this apply to NEMA 1 rated panels?

Response #M6: Use gasketed threaded hubs for exposed rigid conduit.

Question #M7: General Note 4 on Page E-001 says that "all above ground conduit shall be schedule 80 PVC. The electrical specs under "conduit 2.2 says that "exposed conduit is to be rigid hot-dipped galvanized steel with threaded fittings." What kind of conduit are we to use for exposed above ground conduits in the garage? Can we use aluminum rigid conduit for exposed above ground conduits in the garage? Can we use schedule 40 pvc conduit for exposed above ground conduits in the garage? Can we use aluminum EMT conduit for exposed above ground conduits in the garage; aluminum EMT is rust and weather resistant? Can we use fiberglass conduit for exposed above ground conduits in the garage; fiberglass conduit is rust and weather resistant?

Response #M7: For all concealed conduit use PVC Schedule 40. For exposed conduit in the parking garage use galvanized rigid conduit.

Question #M8: Are we allowed to use EMT conduit in the office area, which is typical?

Response #M8: Yes

Question #M9: The electrical contractor should not be furnishing or installing the Oil Detection Panel as shown as Sheet Note 9 on Page E-420.

Response #M9: Confirmed

Question #M10: All of the Panel Schedule shown on Pages E-603 and E-604 are missing the Interrupting Ratings (AIC's), which impairs the ability of the switchgear manufacturers' to properly quote the switchgear package. We need the panel schedules to list the (AIC) interrupting ratings?

Response #M10: Please see note on Sheet 'E-605' . EQUIPMENT SUPPLIER SHALL PERFORM A COMPLETE SYSTEM SHORT CIRCUIT COORDINATION STUDY AND SUPPLY EQUIPMENT THAT IS PROPERLY RATED TO MEET THE CALCULATED VALUES.

Question #M11: Page E-420 has notes 14 and 15 saying that the elevator manufacture will provide the the required elevator disconnects. The electrical specs call for the electrical contractor to provide the required elevator disconnects. Who is supposed to provide the elevator disconnects?

Response #M11: Disconnects to be provided by elevator manufacturer.

Question #M12: There are mechanical units on the electrical plans that show a non-fused disconnect for the corresponding mechanical unit. We just want to verify that these are to be non-fused disconnects?

Response #M12: Correct, use non fused disconnect.

Question #M13: The one line diagram shows the wrong size breaker feeding Transformer TR-2.

Response #M13: Please change breaker to 125/3P breaker, and change secondary side to 4#250M & 1#4GRD, 2-1/2"C

Question #M14: On Specification page 25 05 00-6 it is noted that EMT is not allowed in any location. However, in the office areas, would EMT be acceptable?

Response #M14: Please see note above

Question #M15: On Specification page 25 05 00-6 it states no power wiring smaller than #10. Will #12 be acceptable in the office areas?

Response #M15: #12 is not acceptable

Question #M16: Is MC acceptable for the office area?

Response #M16: MC is not allowed

Question #M17: E-101 shows generator to be 130kw, E-402 says generator to be 150kw, Spec section 26 32 13-6 says generator is to be 180kw, Which of these is correct?

Response #M17: 130Kw is the correct size.

Question #M18: The panel schedule for Panel IT does not have the required breakers to feed Heat Pumps HP-2 and HP-3

Response #M18: Move AC-2/CU-02 and AC-3/CU-03 from panel 'ML1' to panel IT. AC-2/CU-02 to circuits 'IT-13,15' and AC-3/CU-03 to circuits 'IT-17,19'. Connect HP-3 from circuit 'ML1-10,12, and HP-2 from circuit

Question #M19: There is a General Note 18 on Page E-001 says that the "electrical contractor to hire an FCC licensed contractor for the emergency radio system (ERS). The sub-contractor shall visit the deck and verify signal strength of 450- 500 and 800 MHz radio signals for first responders. The sub-contractor to provide amplifiers where required. The main system to be installed in data room." This sub-contractor should be picked up by someone other than the electrical contractor. Electrical contractors have nothing to do with an FCC licensed contractor. This is much more likely to be known by a fire alarm contractor.

Response #M19: Electrical contractor to hire an FCC licensed contractor.



Question #M20: Also, would MC be allowed in the office area?

Response #M20: MC is not allowed


End of Response

ABBREVIATIONS			
ACOUST.	ACOUSTICAL	K/S	KNEE SPACE
ADA	AMERICAN'S WITH DISABILITIES ACT	LT.	LIGHT
AFF	ABOVE FINISH FLOOR	MAX.	MAXIMUM
ALUM.	ALUMINIUM	MATL.	MATERIAL
ANOD.	ALUMINIUM ANODIZED	MFR.	MANUFACTURER
B.O.	BOTTOM OF	MIN.	MINIMUM
CF	CUBIC FOOT	MTL.	METAL
CABT.	CABINET	NTS.	NOT TO SCALE
C.I.P	CAST IN PLACE	O.C.	ON CENTER
C.J.	CONTROL JOINT/ CONSTRUCTION JOINT	O.F.C.I	OWNER FURNISHED/CONTRACTOR INSTALLED
C.L.	CENTER LINE	O.H.	OPPOSITE HAND
CLG.	CEILING	OSB	ORIENTED STRAND BOARD
CMU	CONCRETE MASONARY UNIT	P.LAM.	PLASTIC LAMINATE
COL.	COLUMN	REF.	REFERENCE
COMM.	COMMUNICATIONS	REQ.	REQUIRED
CONC.	CONCRETE	ROGMTS.	REQUIREMENTS
CONT.	CONTINUOUS	RM.	ROOM
COORD.	COORDINATE	R.O.	ROUGH OPENING
COORR.	CORRIDOR	SCHED.	SCHEDULED
DBL.	DOUBLE	SHWR	SHOWER
DR.	DOOR	STF	STOREFRONT
DS.	DOWNSPOUT	STN.	STAIN
EA.	EACH	S.F.	SQUARE FOOT
EQ.	EQUAL	SHT.	SHEET
E.I.F.S	EXTERIOR INSULATED FINISH SYSTEM	STOR.	STORAGE
E.J.	EXPANSION JOINT	SUSP.	SUSPENDED
EWV	ELECTRIC WATER COOLER	TAS	TEXAS ACCESSIBILITY STANDARDS
EXIST	EXISTING	T.B.T & P.T	TAPE, BED, TEXTURE, & PAINT
F.A.C.P.	FIRE ALARM CONTROL PANEL	TELE.	TELEPHONE
F.D.	FLOOR DRAIN	T.H.	THRESHOLD
F.DWN	FURR, DOWN	T.O.	TOP OF
F.D.C.	FIRE DEPARTMENT CONNECTION	T&G	TONGUE AND GROOVE
F.E.	FIRE EXTINGUISHER	TYP.	TYPICAL
F.E.C.	FIRE EXTINGUISHER CABINET	U.N.O.	UNLESS NOTED OTHERWISE
FRP	FIREGLASS REINFORCED PANELS	VCT	VINYL COMPOSITION TILE
F.F.	FINISH FLOOR	W	WITH
GYP. BD.	GYPNUM BOARD	WD.	WOOD
H.C.H.	HANDICAP ACCESSIBLE	WP	WATER PROOF
CAP.		WSCT.	WAINSCOT
H.B.	HOSE BIB		
H.D. HT.	HEAD HEIGHT		
HM	HOLLOW METAL		
HT.AHGT.	HEIGHT		
WH	WATER HEATER		
JT.	JOINT		

NOTE: THE ABOVE LIST DOES NOT CONTAIN ALL ABBREVIATIONS USED IN THE DRAWINGS.

SHEET INDEX			
GENERAL			
G0.0	COVER	X	
G0.1	SHEET INDEX	X	X
G0.2	TEXAS ACCESSIBILITY STANDARDS	X	
G0.3	TEXAS ACCESSIBILITY STANDARDS	X	
G0.4	TEXAS ACCESSIBILITY STANDARDS	X	
G0.5	FRAMING DETAILS	X	
G0.6	MOUNTING HEIGHTS	X	
G0.7	FIRE PENETRATION DETAILS	X	
CIVIL			
C-1	DEMOLITION PLAN	X	
C-2	STORM WATER POLLUTION PREVENTION PLAN	X	
C-3	SITE PLAN	X	
C-4	GRADING PLAN	X	
C-5	UTILITY PLAN	X	
C-6	STANDARD DETAILS	X	
C-7	CITY OF LONGVIEW STANDARD DETAILS	X	
ARCHITECTURAL			
A0.0	CODE REVIEW	X	
A0.1	LIFE SAFETY PLAN - OFFICE LEVEL & GARAGE TIER 1	X	
A0.2	LIFE SAFETY PLAN - GARAGE TIER 2	X	
A0.3	LIFE SAFETY PLAN - GARAGE TIER 3	X	
A0.4	LIFE SAFETY PLAN - GARAGE TIER 4	X	
A1.0	DEMOLITION SITE PLAN	X	
A1.1	ARCHITECTURAL SITE PLAN	X	X
A2.1	FLOOR PLAN - OFFICE LEVEL & GARAGE TIER G	X	X
A2.2	FLOOR PLAN - GARAGE TIER 2	X	X
A2.3	FLOOR PLAN - GARAGE TIER 3	X	X
A2.4	FLOOR PLAN - GARAGE TIER 4	X	
A2.5	ROOF PLAN	X	X
A2.6	ENLARGED PLAN - NW - OFFICE LEVEL & GARAGE TIER G	X	X
A2.7	ENLARGED PLAN - NE - OFFICE LEVEL & GARAGE TIER G	X	X
A2.8	ENLARGED PLAN - SW - OFFICE LEVEL & GARAGE TIER G & RESTROOMS	X	X
A3.1	EXTERIOR ELEVATIONS	X	X
A3.2	EXTERIOR ELEVATIONS	X	X
A3.3	PARTIAL BUILDING SECTIONS	X	X
A4.1	BUILDING SECTIONS	X	
A4.2	BUILDING SECTIONS	X	X
A4.3	WALL SECTIONS	X	X
A4.4	WALL SECTIONS	X	
A4.5	WALL SECTIONS	X	
A4.6	WALL SECTIONS	X	
A4.8	VERTICAL CIRCULATION N.E. STAIR PLANS	X	
A4.9	VERTICAL CIRCULATION S.W. STAIR PLANS	X	
A5.0	SECTION DETAILS	X	X
A5.1	SECTION DETAILS	X	
A5.2	SECTION DETAILS	X	
A5.3	SECTION DETAILS	X	
A5.5	PLAN DETAILS	X	X
A6.1	STOREFRONT DOOR & WINDOW ELEVATIONS & SCHEDULES	X	X
A6.2	PARTITION TYPES	X	
A7.1	REFLECTED CEILING PLAN & CEILING DETAILS	X	
INTERIORS			
A8.1	INTERIOR ELEVATIONS	X	X
A8.2	MILLWORK DETAILS	X	
A9.1	FINISH SCHEDULE AND NOTES	X	
A9.2	FINISH PLAN	X	
SIGNAGE & STRIPING			
AG101	GROUND TIER STRIPING AND SIGNAGE PLAN	X	
AG102	SECOND TIER STRIPING AND SIGNAGE PLAN	X	
AG103	THIRD TIER STRIPING AND SIGNAGE PLAN	X	
AG104	TOP TIER STRIPING AND SIGNAGE PLAN	X	
AG601	SIGN SCHEDULE AND DETAILS	X	
AG701	SIGN MOUNTING DETAILS	X	

SHEET INDEX			
STRUCTURAL			
S-001	STRUCTURAL GENERAL NOTES	X	
S-002	ABBREVIATIONS AND LEGENDS	X	
S-003	POST-TENSION POUR SEQUENCE	X	
S-100	FOUNDATION PLAN	X	
S-101	GROUND TIER PLAN	X	
S-102	SECOND TIER PLAN	X	
S-103	THIRD TIER PLAN	X	
S-104	FOURTH TIER PLAN	X	
S-105	ROOF PLAN	X	
S-410	ENLARGED STAIR/ELEVATOR PLANS	X	
S-420	ENLARGED STAIR PLANS	X	
S-501	TYPICAL DETAILS	X	
S-510	FOUNDATION DETAILS	X	
S-511	FOUNDATION WALL DETAILS	X	
S-512	FOUNDATION DETAILS	X	
S-520	STRUCTURAL DETAILS	X	
S-530	CIP BEAM SCHEDULE AND DETAILS	X	
S-535	POST-TENSION SLAB DETAILS	X	
S-640	WALL DETAILS	X	
S-541	STRUCTURAL DETAILS	X	
S-542	STRUCTURAL DETAILS	X	
S-543	STRUCTURAL DETAILS	X	
S-550	CIP COLUMN SCHEDULE & DETAILS	X	
S-570	STAIR AND ELEVATOR DETAILS	X	
S-650	LAP SLICE SCHEDULES	X	
MECHANICAL			
M-001	MECHANICAL EQUIPMENT SCHEDULE, GENERAL NOTES, SYMBOLS & ABBREVIATIONS	X	
M-002	DETAILS	X	
M-101	GROUND TIER PLAN	X	
M-102	SECOND TIER PLAN	X	
M-103	THIRD TIER PLAN	X	
M-104	TOP TIER PLAN	X	
PLUMBING			
P-001	GENERAL NOTES, SYMBOLS & ABBREVIATIONS	X	
P-101	GROUND TIER PLAN	X	
P-102	SECOND TIER PLAN	X	
P-103	THIRD TIER PLAN	X	
P-104	TOP TIER PLAN	X	
P-400	GENERAL OFFICE PLUMBING INFORMATION	X	
P-401	FOUNDATION OFFICE PLUMBING PLAN	X	
P-402	OFFICE PLUMBING PLAN	X	
P-403	ENLARGED OFFICE PLUMBING PLANS	X	
P-601	RISER DIAGRAMS	X	
FIRE PROTECTION			
F-001	GENERAL NOTES, SYMBOLS & ABBREVIATIONS	X	
F-101	FIRE PROTECTION PLANS	X	
F-201	PARTIAL FIRE PROTECTION PLAN	X	
F-301	FIRE STANDPIPE RISER DIAGRAM	X	
ELECTRICAL			
E-001	LIGHT FIXTURE SCHEDULE, GENERAL NOTES, SYMBOLS & ABBREVIATIONS	X	
E-101	GROUND TIER PLAN	X	
E-102	SECOND TIER PLAN	X	
E-103	THIRD TIER PLAN	X	
E-104	TOP TIER PLAN	X	
E-401	ENTRY/EXIT PLANS	X	
E-402	ELECTRICAL ROOM PLAN	X	
E-403	OFFICE AREA - ENLARGED POWER & LIGHTING PLAN	X	
E-410	SW STAIR TOWER	X	
E-420	NE STAIR / ELEVATOR TOWER	X	
E-501	DETAILS	X	
E-601	RISER DIAGRAMS	X	
E-602	LIGHTING CONTROL	X	
E-603	NORMAL POWER PANEL SCHEDULES	X	
E-604	EMERGENCY AND STANDBY POWER PANEL SCHEDULES	X	
E-605	POWER ONE LINE DIAGRAM	X	

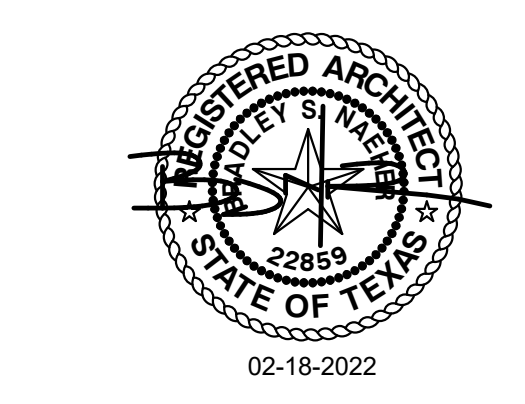

PROJECT NO.: 20011
DATE: 03/03/2022

REVISION SCHEDULE		
Δ	Description	Date
T	ADDENDUM 04	03-17-2022

SHEET NAME


SHEET INDEX

SHEET NO.

G0.1


- GENERAL NOTES:**
1. THE CITY OF 'X' CONSTRUCTION STANDARDS APPLY, WHETHER INDICATED ON THESE PLANS OR NOT.
 2. CONTRACTOR SHALL BE RESPONSIBLE FOR PRODUCING ANY REQUIRED TRENCH SAFETY PLAN OR TRAFFIC CONTROL PLAN.
 3. PRIOR TO STARTING CONSTRUCTION, THE CONTRACTOR SHALL MAKE CERTAIN THAT ALL REQUIRED PERMITS AND APPROVALS HAVE BEEN OBTAINED.
 4. EROSION CONTROLS SHALL BE IN PLACE PRIOR TO THE DISTURBANCE OF ANY EXISTING SURFACE.
 5. IT IS THE RESPONSIBILITY OF THE CONTRACTOR TO PROTECT ALL PUBLIC UTILITIES IN THE CONSTRUCTION OF THIS PROJECT. ALL MANHOLES, CLEANOUTS, VALVE BOXES, FIRE HYDRANTS, ETC. MUST BE ADJUSTED TO PROPER LINE AND GRADE BY THE CONTRACTOR PRIOR TO AND AFTER THE PLACING OF PERMANENT PAVING. UTILITIES MUST BE MAINTAINED TO PROPER LINE AND GRADE DURING CONSTRUCTION OF THIS PROJECT.
 6. ALL UNDERGROUND UTILITIES AND SLEEVES (IRRIGATION AND SITE LIGHTING) MUST BE INSTALLED BEFORE PAVING.
 7. ALL PAVEMENT REPAIR WORK REQUIRES FULL PANEL REPLACEMENT.
 8. ALL RETAINING/DETAINING WALLS, TURN-DOWN CURBS, TREE RETAINING WALLS SHALL BE CLAD IN A MATERIAL TO COMPLEMENT THE MATERIALS AND COLORS WITHIN THIS DEVELOPMENT.
 9. ALL GROUND BASED HVAC SHALL BE SCREENED WITH LIVE SCREENING OR MASONRY ENCLOSURE. MASONRY ENCLOSURE SHALL BE CLAD IN THE SAME MATERIAL AS THE MAIN BUILDING.
 10. ALL ROOF-MOUNTED MECHANICAL UNITS AND/OR EQUIPMENT SHALL BE SCREENED FROM VIEW.
 11. DUMPSTER SCREENING WALL SHALL BE CLAD IN A MATERIAL TO MATCH THE MATERIALS ON THE MAIN BUILDING.
 12. DUMPSTER SCREENING WALL REQUIRES A SEPARATE BUILDING PERMIT.
 13. SIGNS REQUIRE A SEPARATE BUILDING PERMIT. ANY SIGNS DEPICTED ON THE SUBJECT SITE PLANE/ELEVATIONS ARE NOT APPROVED AS A PART OF THIS REVIEW AND MUST COMPLY WITH ALL APPLICABLE TOWN REGULATIONS.
 14. REFERENCE CIVIL, LANDSCAPE, AND ELECTRICAL DRAWINGS FOR ADDITIONAL INFORMATION.

A NEW FACILITY FOR
GREGG COUNTY - PARKING GARAGE & OFFICE
 100 E. METHVIN ST.
 LONGVIEW, TX 75601

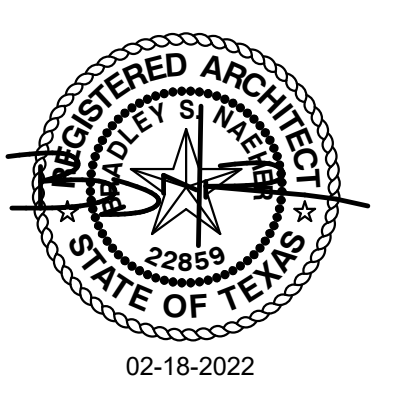

PROJECT NO.: 20011
 DATE: 02-18-2022

REVISION SCHEDULE	
Δ Description	Date
1. ADDENDUM 04	03-17-2022

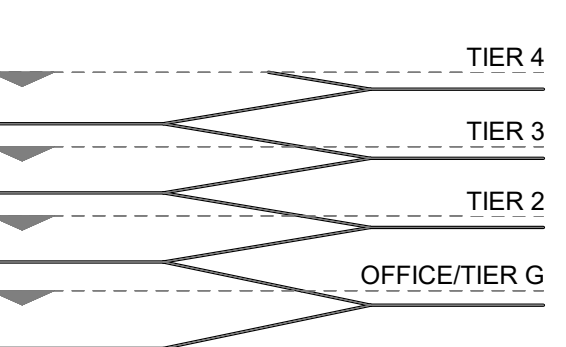


SHEET NAME

ARCHITECTURAL SITE PLAN

SHEET NO.

A1.1

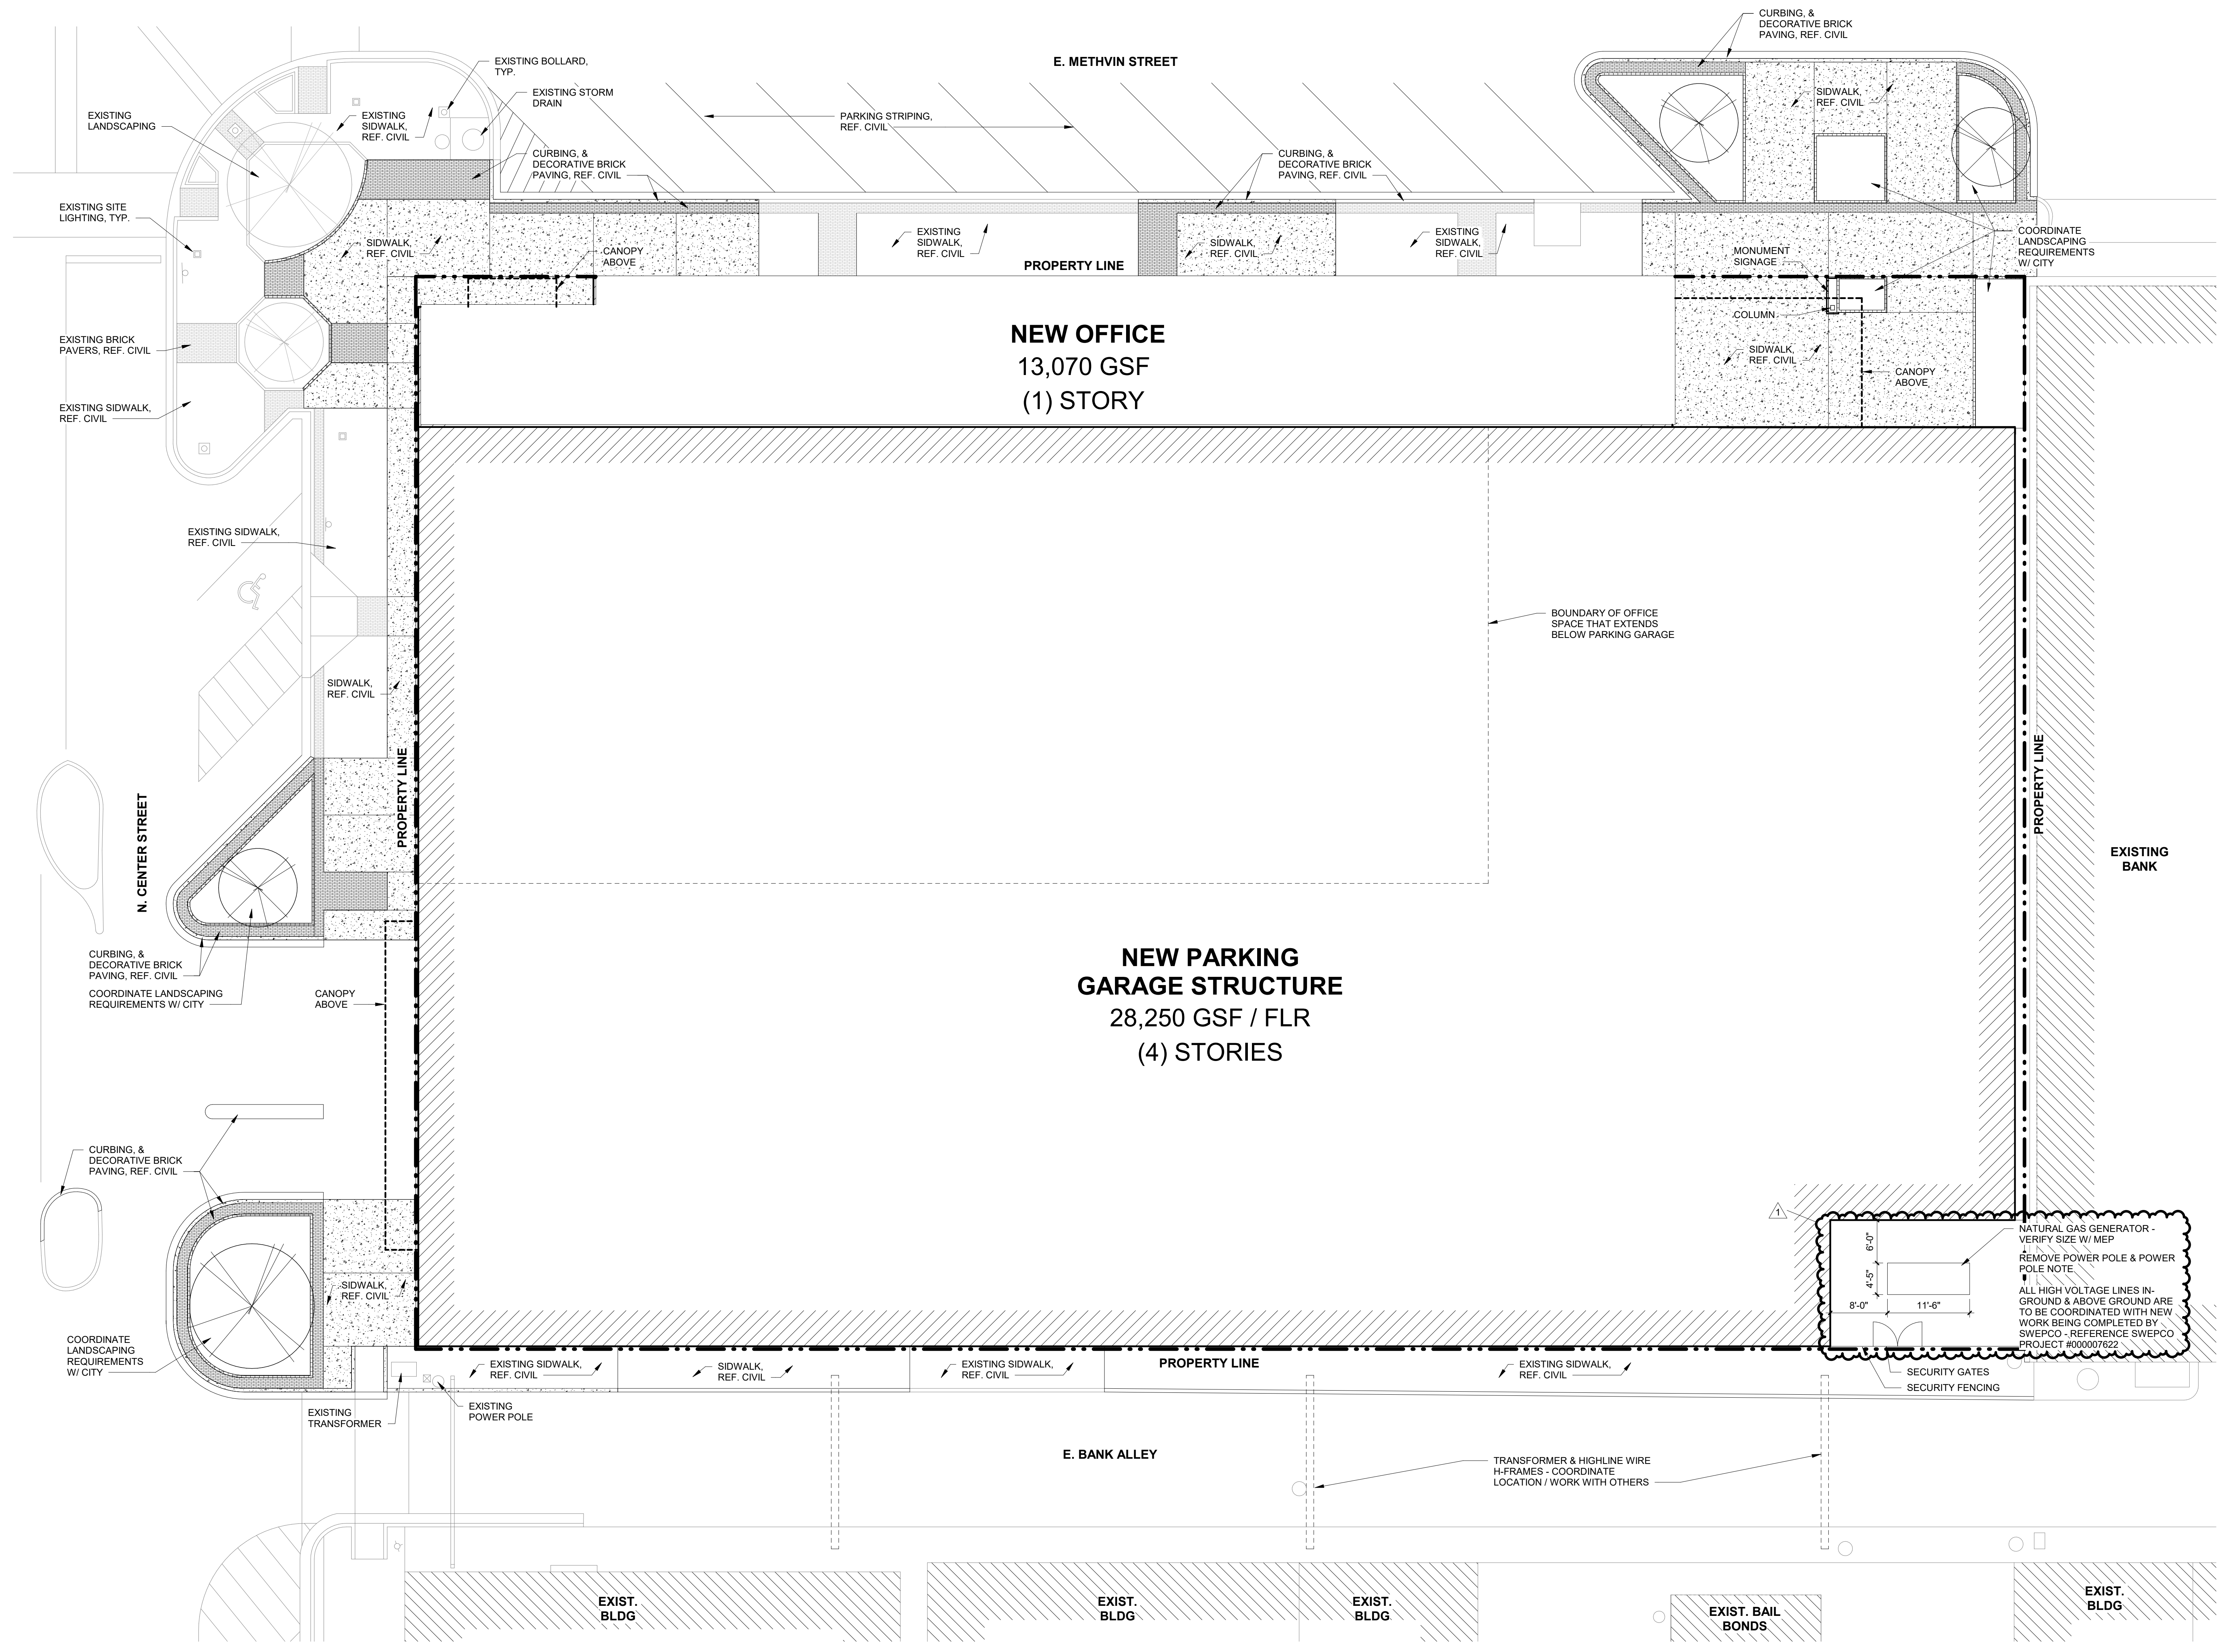

PROPOSED SITE PLAN | 1
 SCALE: 1" = 10'-0" A1.1

FLOOR PLAN LEGEND:


	BUILDING SECTION
	WALL SECTION
	ENLARGED DETAIL REFERENCE
	ELEVATION
	ROOM TAG
	DOOR SYMBOL
	WALL TYPE
	STOREFRONT SYMBOL

GENERAL NOTES


GENERAL NOTES ARE APPLICABLE TO ALL DRAWINGS - ITEMS AND CONDITIONS DETAILED, NOTED OR OTHERWISE IDENTIFIED ON ONE OF THE SECTIONS OR DETAILS ARE APPLICABLE AND BINDING TO ALL OTHER SECTIONS AND DETAILS FOR IDENTICAL OR SIMILAR CONDITIONS.

- ALL DIMENSIONS ARE FROM STUD TO CMU FACE, UNLESS NOTED OTHERWISE.
- CONTRACTOR SHALL VISIT THE CONSTRUCTION SITE PRIOR TO BIDDING AND BECOME FAMILIAR WITH EXISTING CONDITIONS.
- CONTRACTOR SHALL REVIEW THE DRAWINGS AND SPECIFICATIONS AND REPORT ANY DISCREPANCIES TO THE ARCHITECT IMMEDIATELY.
- LOCATE ALL DOORS 4" FROM THE NEAREST CORNER TO OUTSIDE EDGE OF FRAME UNLESS NOTED OTHERWISE.
- G.C. TO VERIFY ROUGH OPENING DIMENSION REQUIREMENTS OF ALL DOORS AND WINDOWS.
- PROVIDE ALL NECESSARY WOOD FRAMING, BRACING, BLOCKING, NAILERS AND SHIMS REQUIRED TO INSTALL ALL DOOR FRAMES, MEP WORK, MILLWORK, ACCESSORIES AND MISCELLANEOUS FIXTURES AND FITTINGS. FIRE TREATED PER CODE.
- CONTRACTOR SHALL INSTALL DOORS, FRAMES AND FINISH HARDWARE. ALL DOORS TO HAVE HANDICAP ACCESSIBLE LEVER HANDLES, U.N.O. ALL HARDWARE TO BE INSTALLED IN ACCORDANCE WITH T.A.S. GUIDELINES.
- ANY BUILDING WALL OR ROOF PENETRATIONS TO BE WARRANTED AND WEATHERTIGHT/WEATHERPROOF. ALL ROOFING PENETRATIONS (EQUIPMENT, STACKS, ETC.) TO BE FLASHED AND RE-ROOFED PER ROOFING MANUFACTURER'S SPECIFICATIONS AND WARRANTIES.
- CONTRACTOR TO PROVIDE EXIT LIGHTS, SMOKE DETECTORS, EMERGENCY LIGHTING, FIRE EXTINGUISHERS, ETC. PER CODE AND AS DIRECTED BY FIRE MARSHAL HAVING JURISDICTION.
- CONTRACTOR TO COORDINATE INSTALLATION OF ALL OWNER-PROVIDED ITEMS/SYSTEMS WITH OWNER AND OTHER CONTRACTORS.
- PARTITION RATINGS: (REFER WALL TYPES SCHEDULE FOR DETAILED INFORMATION), STAIRS, VERTICAL SHAFTS/CHASES, ELEVATOR HOISTWAYS - 1 HOUR.
- PARTITION RATINGS: (REFER WALL TYPES SCHEDULE FOR DETAILED INFORMATION).
- PROVIDE ALL FIRE PROOFING & FIRE STOPPING AT STRUCTURAL MEMBERS, RATED ASSEMBLIES, ETC. AS REQUIRED. PROVIDE SYSTEMS AND ASSEMBLIES THAT MEET UL LABELS.
- CONTRACTOR(S) SHALL FIELD VERIFY CONDITIONS AND DIMENSIONS PRIOR TO COMMENCING WORK. ENSURE MINIMUM DIMENSION CLEARANCES ARE MAINTAINED FOR MEP SYSTEMS, FIRE PROOFING, ACCESSIBILITY, EGRESS, ETC. VERIFY LAYOUT VERTICALLY AND HORIZONTALLY FOR (DUCTS, PIPING, CONDUIT, ETC.). COORDINATE ANY DISCREPANCIES WITH OWNER AND ARCHITECT.
- ALL CONTRACTORS ARE TO COORDINATE THEIR SYSTEMS WITH OTHER SYSTEMS AND CONSTRUCTION THAT MAY BE ADJOINING OR AFFECTED BY WORK TO BE DONE.
- CONTRACTOR(S) ARE RESPONSIBLE TO VERIFY THAT ALL WORK CONFORMS TO APPLICABLE BUILDING AND LIFE SAFETY, ACCESSIBILITY, ENERGY, AND LOCAL CODES AND ORDINANCES.

- DO NOT SCALE FROM DRAWINGS FOR CONSTRUCTION PURPOSES.
- ALL SYSTEMS, PRODUCT, FIXTURES, EQUIPMENT, SPECIALTIES, AND FINISHES TO BE INSTALLED PER CODE AND AS SPECIFIED, AS WELL AS PER INDUSTRY STANDARDS AND MANUFACTURER'S INSTRUCTIONS/RECOMMENDATION - WHETHER NOTED IN THE DOCUMENTS OR NOT.
- HARDWARE IS GENERALLY SPECIFIED. A DETAILED DOOR AND HARDWARE SCHEDULE SHALL BE SUBMITTED CLEARLY INDICATING ALL COMPONENTS NEEDED FOR EGRESS, ACCESSIBILITY, SECURITY, DURABILITY, AND EASE OF OPERATION. PROVIDE SAMPLES/CUT SHEETS OF EACH COMPONENT.
- ALL WORK SHALL COMPLY WITH THE AMERICANS WITH DISABILITIES ACT (ADA) AND THE CURRENT TEXAS ACCESSIBILITY STANDARDS (TAS). THE CONTRACTOR SHALL CALL FOR THE SITE INSPECTION BY THE RAS ONCE CONSTRUCTION IS COMPLETED. ANY NON-COMPLYING WORK SHALL BE REMEDIATED AS REQUIRED WITHOUT ADDITIONAL EXPENSE.
- ALL MATERIAL USED IN THE PROJECT SHALL MEET THE FLAME SPREAD INDEX AND SMOKE DEVELOPED INDEX PER CODE. ALL FIRE BLOCKING, FIRE STOPPING, FIRE RATED ASSEMBLIES, FIRE SAFING, FIRE PROOFING, DRAFT STOPPING SHALL BE MAINTAINED AS REQUIRED BY CODE WHETHER SPECIFICALLY DETAILED OR SPECIFIED OR NOT.
- NO MATERIAL CONTAINING HAZARDOUS MATERIALS SHALL BE UTILIZED ON THE PROJECT. IF CONTRACTOR SUSPECTS ANY HAZARDOUS MATERIALS PRESENT AT THE PROJECT SITE, WORK SHALL STOP AND THE OWNER NOTIFIED IMMEDIATELY.
- ALL FLOOR SURFACES SHALL BE BROUGHT TO A LEVEL, SMOOTH SURFACE AT EACH FINISH FLOOR ELEVATION READY TO RECEIVE FUTURE OR SCHEDULED FINISHES SO THAT THE FINAL FLOORING WILL MEET THE ADAPTAS REQUIREMENTS.
- ALL MATERIAL LOCATED IN THE FIRE RATED PARTITIONS SHALL BE FIRE RATED PER CODE REQUIREMENTS.
- REFER TO CIVIL DRAWINGS FOR EXTERIOR GRADE ELEVATIONS.
- REFER TO STRUCTURAL DRAWINGS FOR RAMP AND SLAB ELEVATIONS.
- UNLESS NOTED OTHERWISE, WALLS SHALL EXTEND TO THE UNDERSIDE OF ROOF, FLOOR SLAB OR STRUCTURAL FRAMING ABOVE AND BE SEALED IN ACCORDANCE WITH THE WALL TERMINATION DETAILS ON SHEET G0.05. FIRE STOP WALLS IN ACCORDANCE WITH THE SPECIFICATION SECTION 078400 FIRESTOPPING TO SEAL THE TOPS OF FIRE BARRIERS AND WALL WHICH ARE REQUIRED TO RESIST THE PASSAGE OF SMOKE. REFER TO THE LIFE SAFETY PLANS FOR IDENTIFICATION OF ALL SMOKE AND FIRE WALL CONDITIONS.
- COLUMNS GRIDS ARE FOR REFERENCE ONLY. REFER TO STRUCTURAL DRAWINGS FOR COLUMN LOCATIONS.
- UNLESS NOTED OTHERWISE, THE SAME WALL TYPE NEXT TO A DOOR OR OPENING SHALL CONTINUE OVER THE DOOR OR OPENING.
- ALL CEILING HEIGHTS SHALL BE AS INDICATED ON THE PLANS UNLESS MECHANICAL, ELECTRICAL OR STRUCTURAL COMPONENTS PREVENT FULL HEIGHT. THE CONTRACTOR SHALL NOTIFY THE ARCHITECT IN THE EVENT OF A CONFLICT.
- ALL EXPOSED CMU SHALL BE PAINTED. COLOR TO BE SELECTED BY ARCHITECT.
- ALL REFERENCES TO AHJ CAN BE DISREGARDED. ALL BUILDING ELEMENTS SHALL MEET STATE MINIMUM CODE STANDARDS.

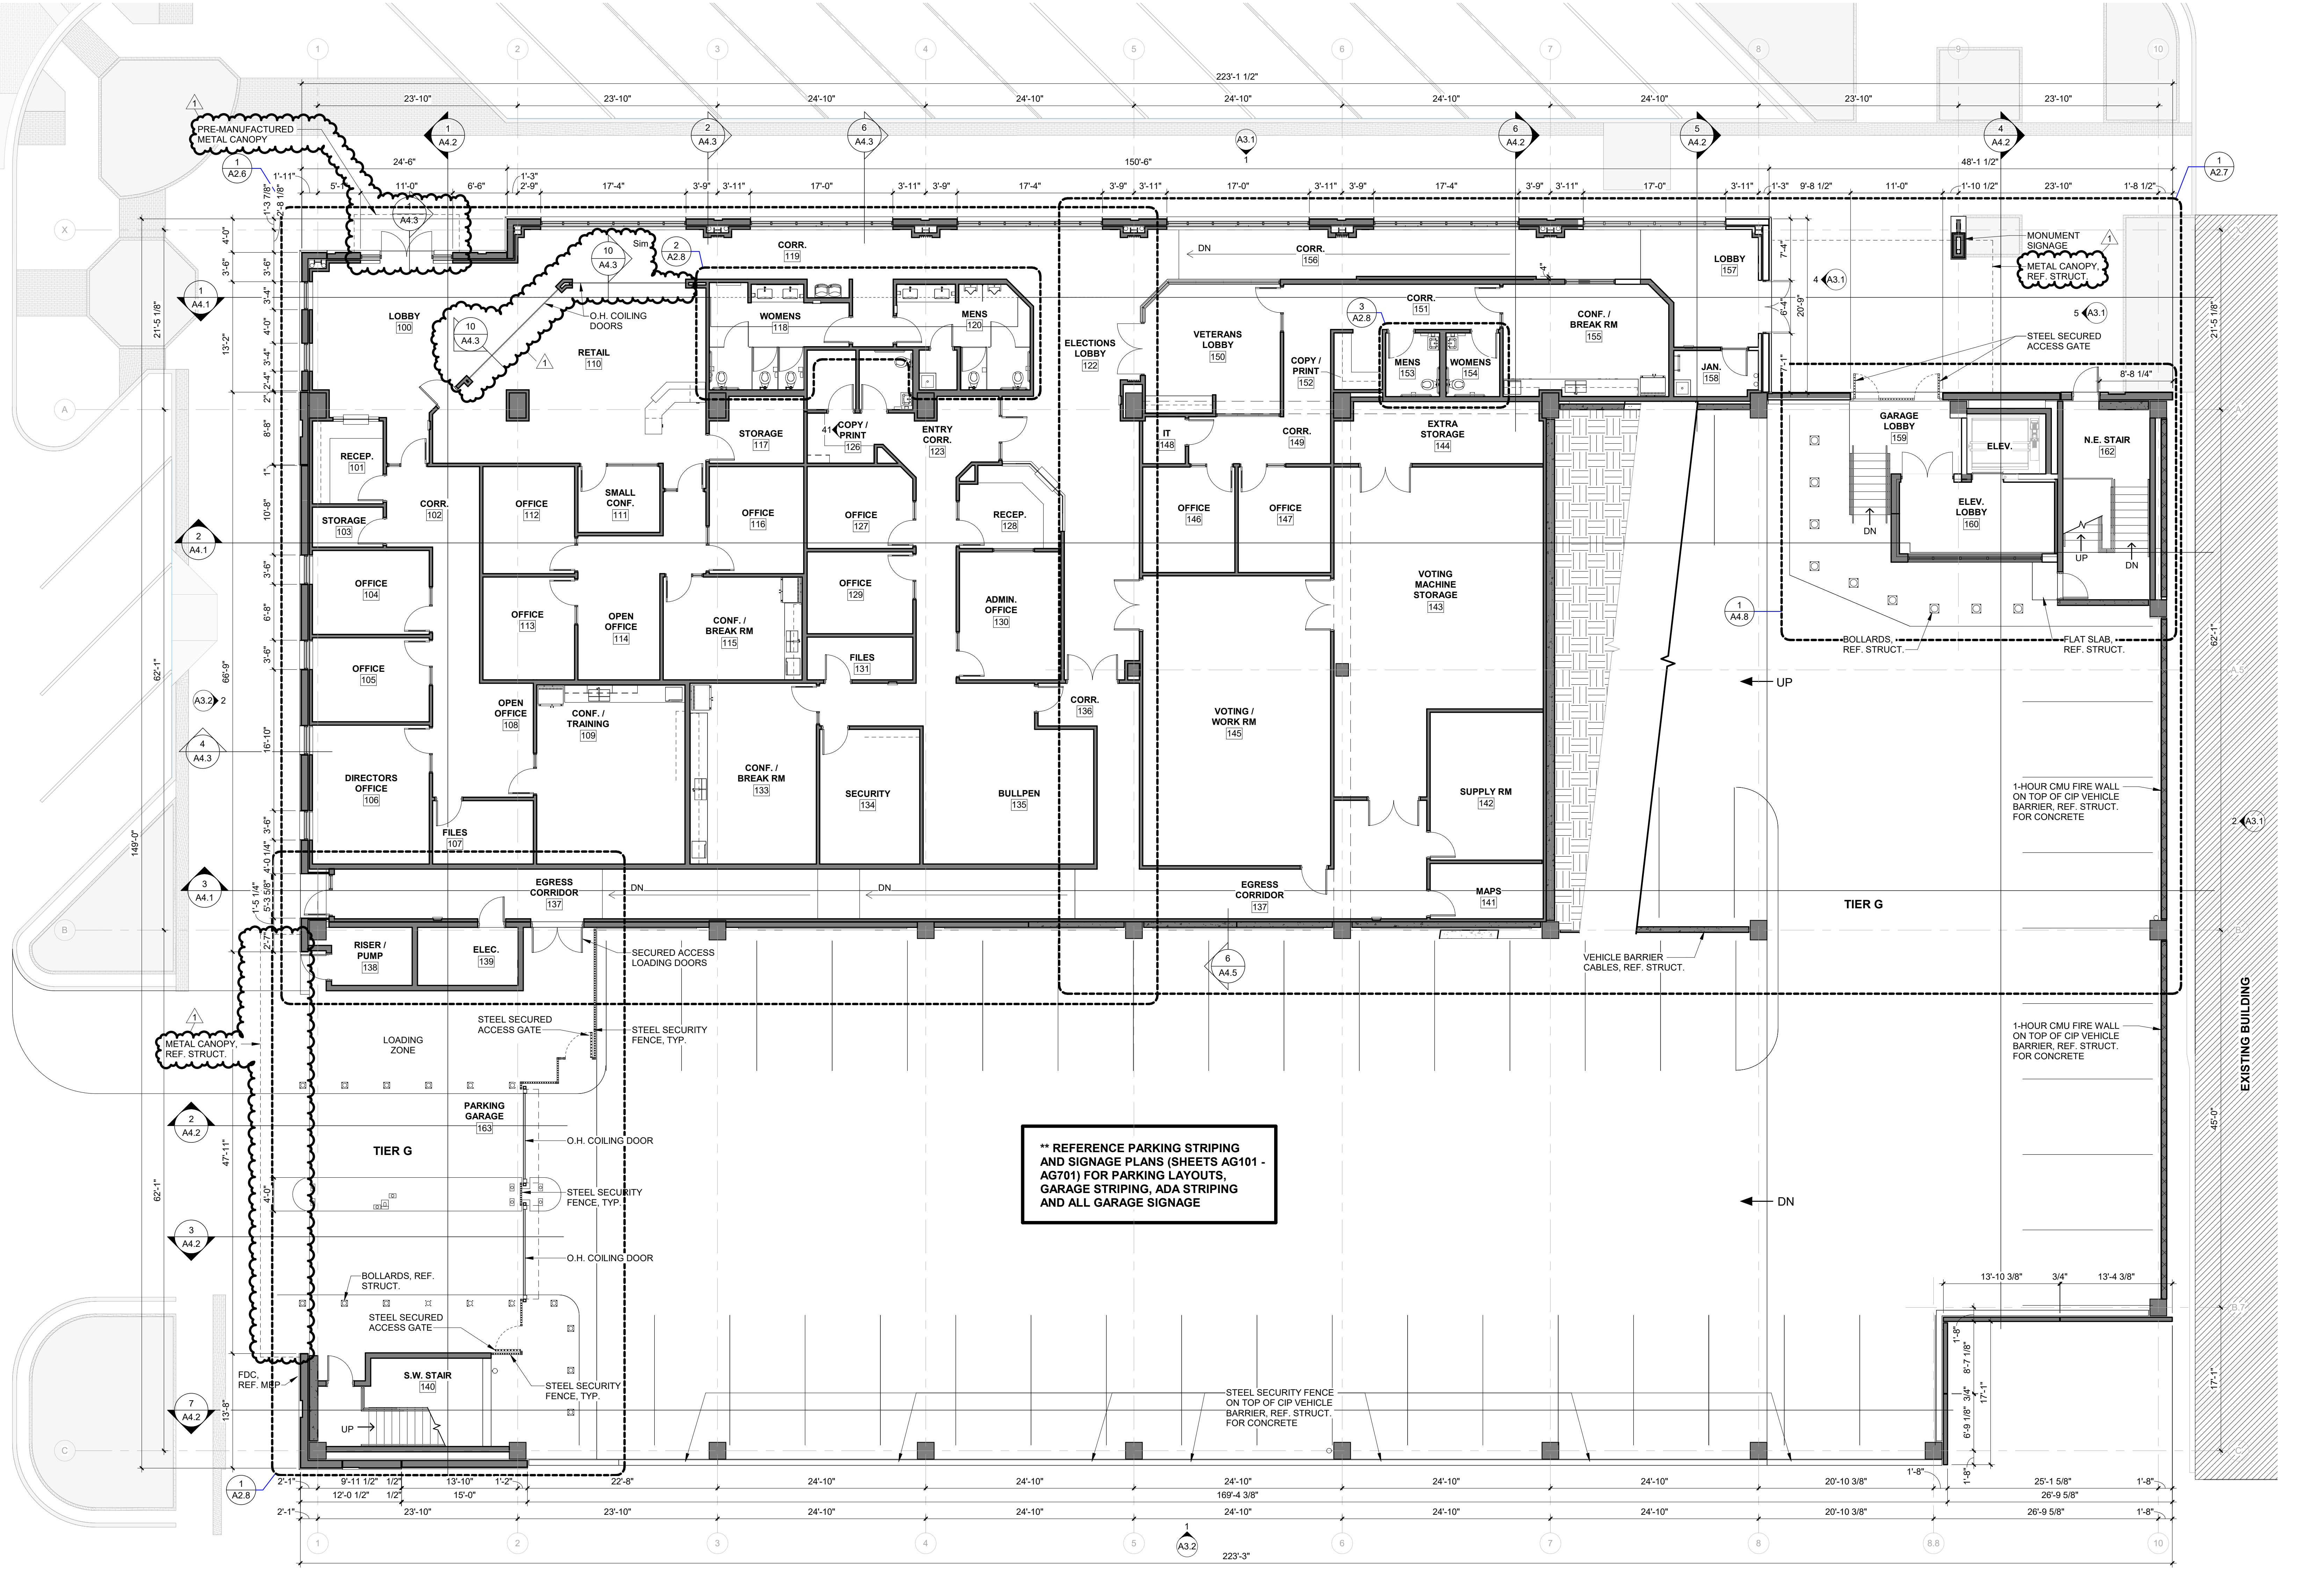

A NEW FACILITY FOR
**GREGG COUNTY - PARKING
GARAGE & OFFICE**
100 E. METHUEN ST.
LONGVIEW, TX 75601

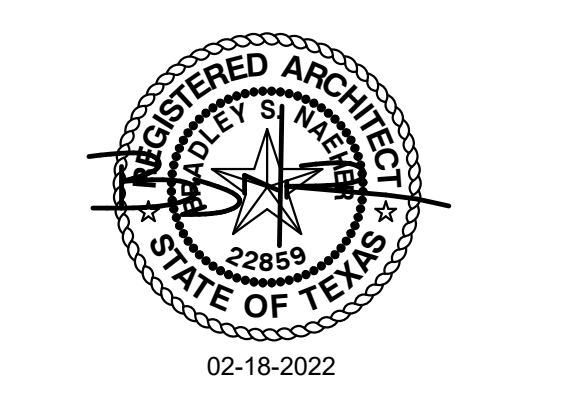

PROJECT NO.: 20011
DATE: 03/03/2022

REVISION SCHEDULE

A	Description	Date
1	ADDENDUM 04	03-17-2022

TIER 4
TIER 3
TIER 2
OFFICE/TIER G


SHEET NAME

FLOOR PLAN - OFFICE LEVEL & GARAGE TIER G

SHEET NO.




A NEW FACILITY FOR
**GREGG COUNTY - PARKING
GARAGE & OFFICE**
100 E. METHUEN ST.
LONGVIEW, TX 75601

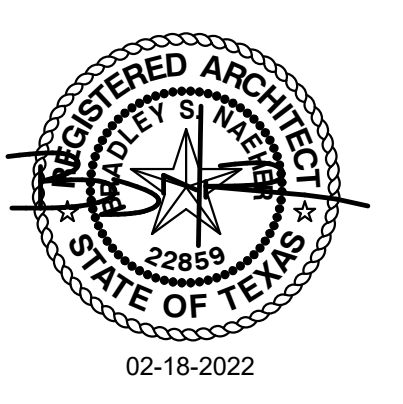


02-18-2022
PROJECT NO.: 20011
DATE: 03/03/2022

REVISION SCHEDULE	
A. Description	Date
1. ADDENDUM 04	03-17-2022

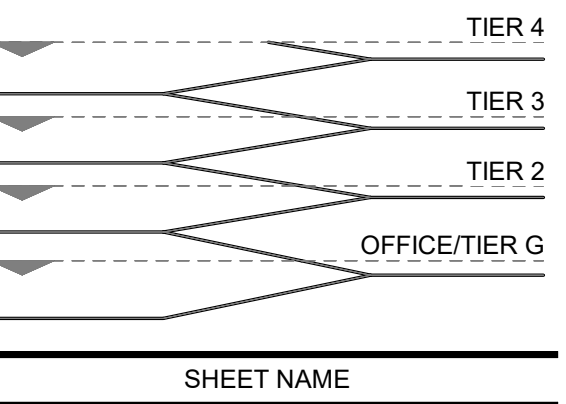


A NEW FACILITY FOR
GREGG COUNTY - PARKING GARAGE & OFFICE
100 E. METHUEN ST.
LONGVIEW, TX 75601

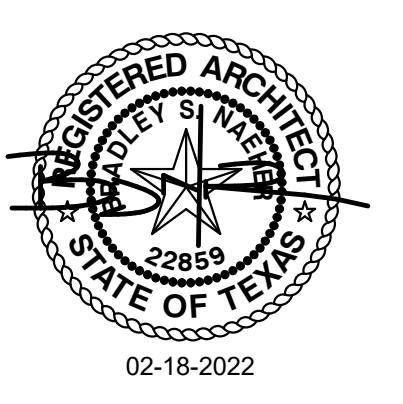

PROJECT NO.: 20011
DATE: 03/03/2022

REVISION SCHEDULE	
A. Description	Date
1. ADDENDUM 04	03-17-2022


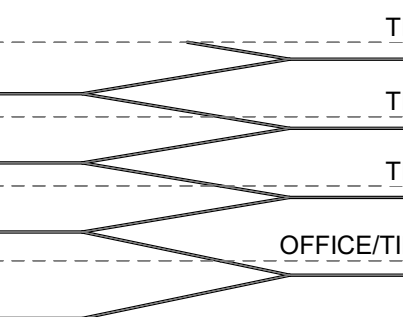


SHEET NAME


ENLARGED PLAN - NE - OFFICE LEVEL & GARAGE TIER G

SHEET NO.


A2.7

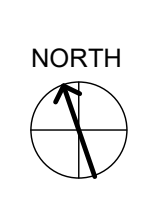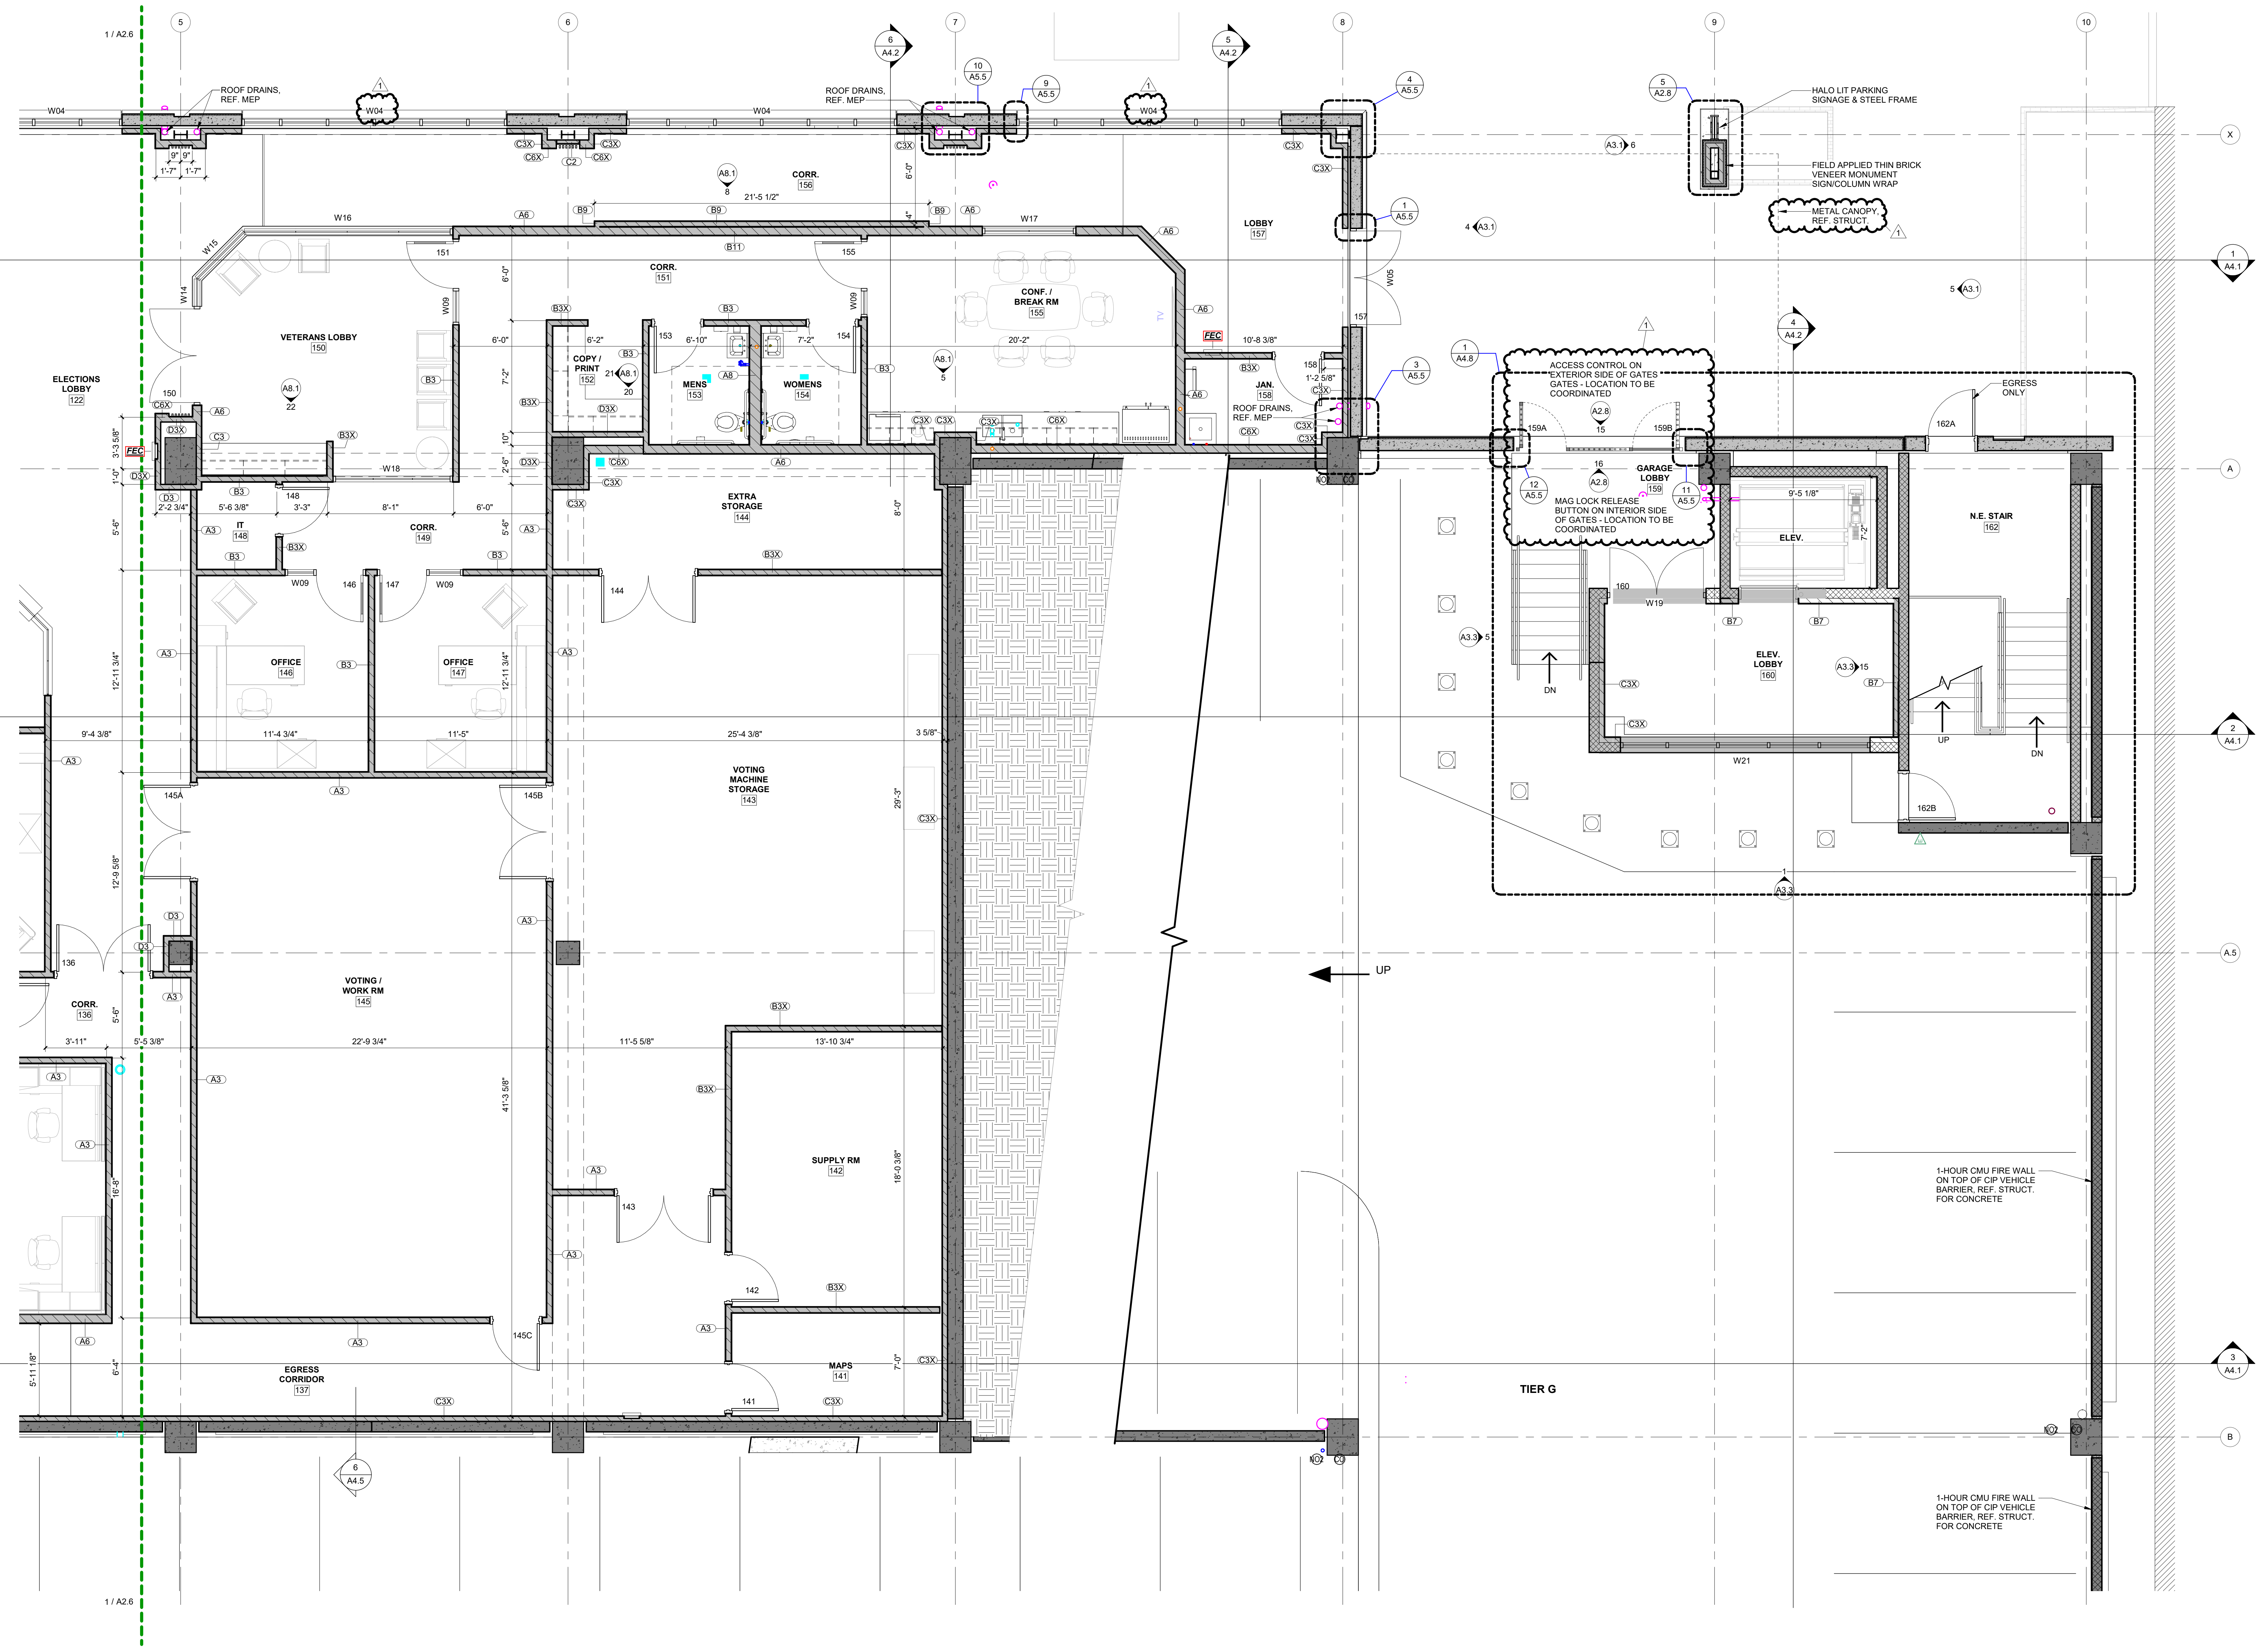


ENLARGED PLAN - NE - OFFICE LEVEL & GARAGE TIER G | 1
SCALE: 1/4" = 1'-0" | A2.7

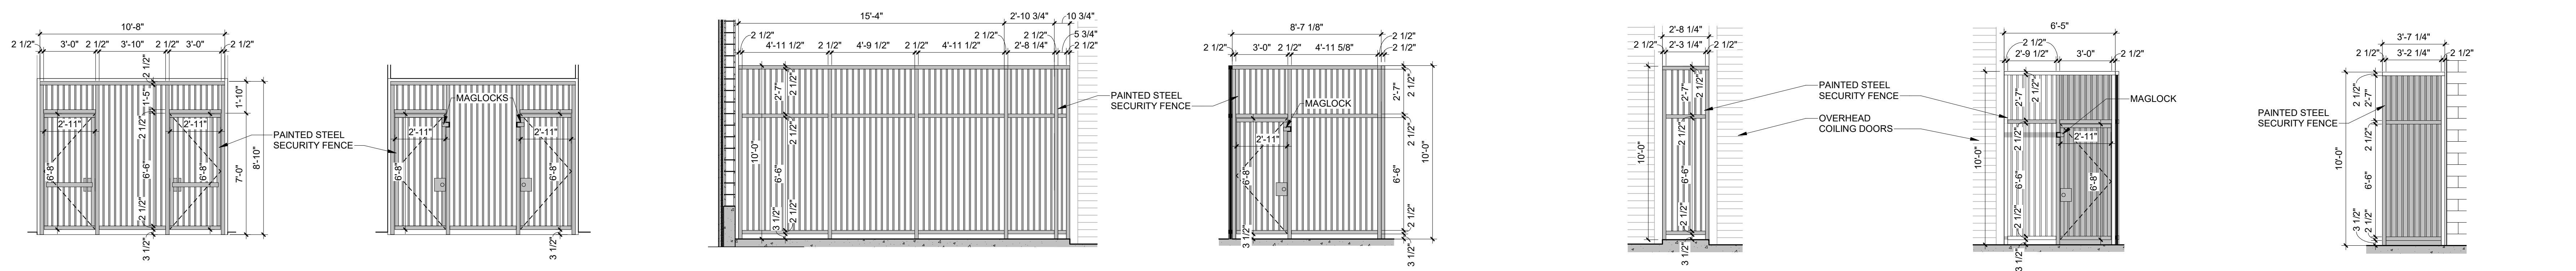


ELEVATION @ SECURITY GATE 16 SCALE: 1/4" = 1'-0" A2.8
ELEVATION @ SECURITY GATE 15 SCALE: 1/4" = 1'-0" A2.8
ELEVATION @ SECURITY GATE 14 SCALE: 1/4" = 1'-0" A2.8
ELEVATION @ SECURITY GATE 13 SCALE: 1/4" = 1'-0" A2.8
ELEVATION @ SECURITY GATE 12 SCALE: 1/4" = 1'-0" A2.8
ELEVATION @ SECURITY GATE 11 SCALE: 1/4" = 1'-0" A2.8
ELEVATION @ SECURITY GATE 10 SCALE: 1/4" = 1'-0" A2.8

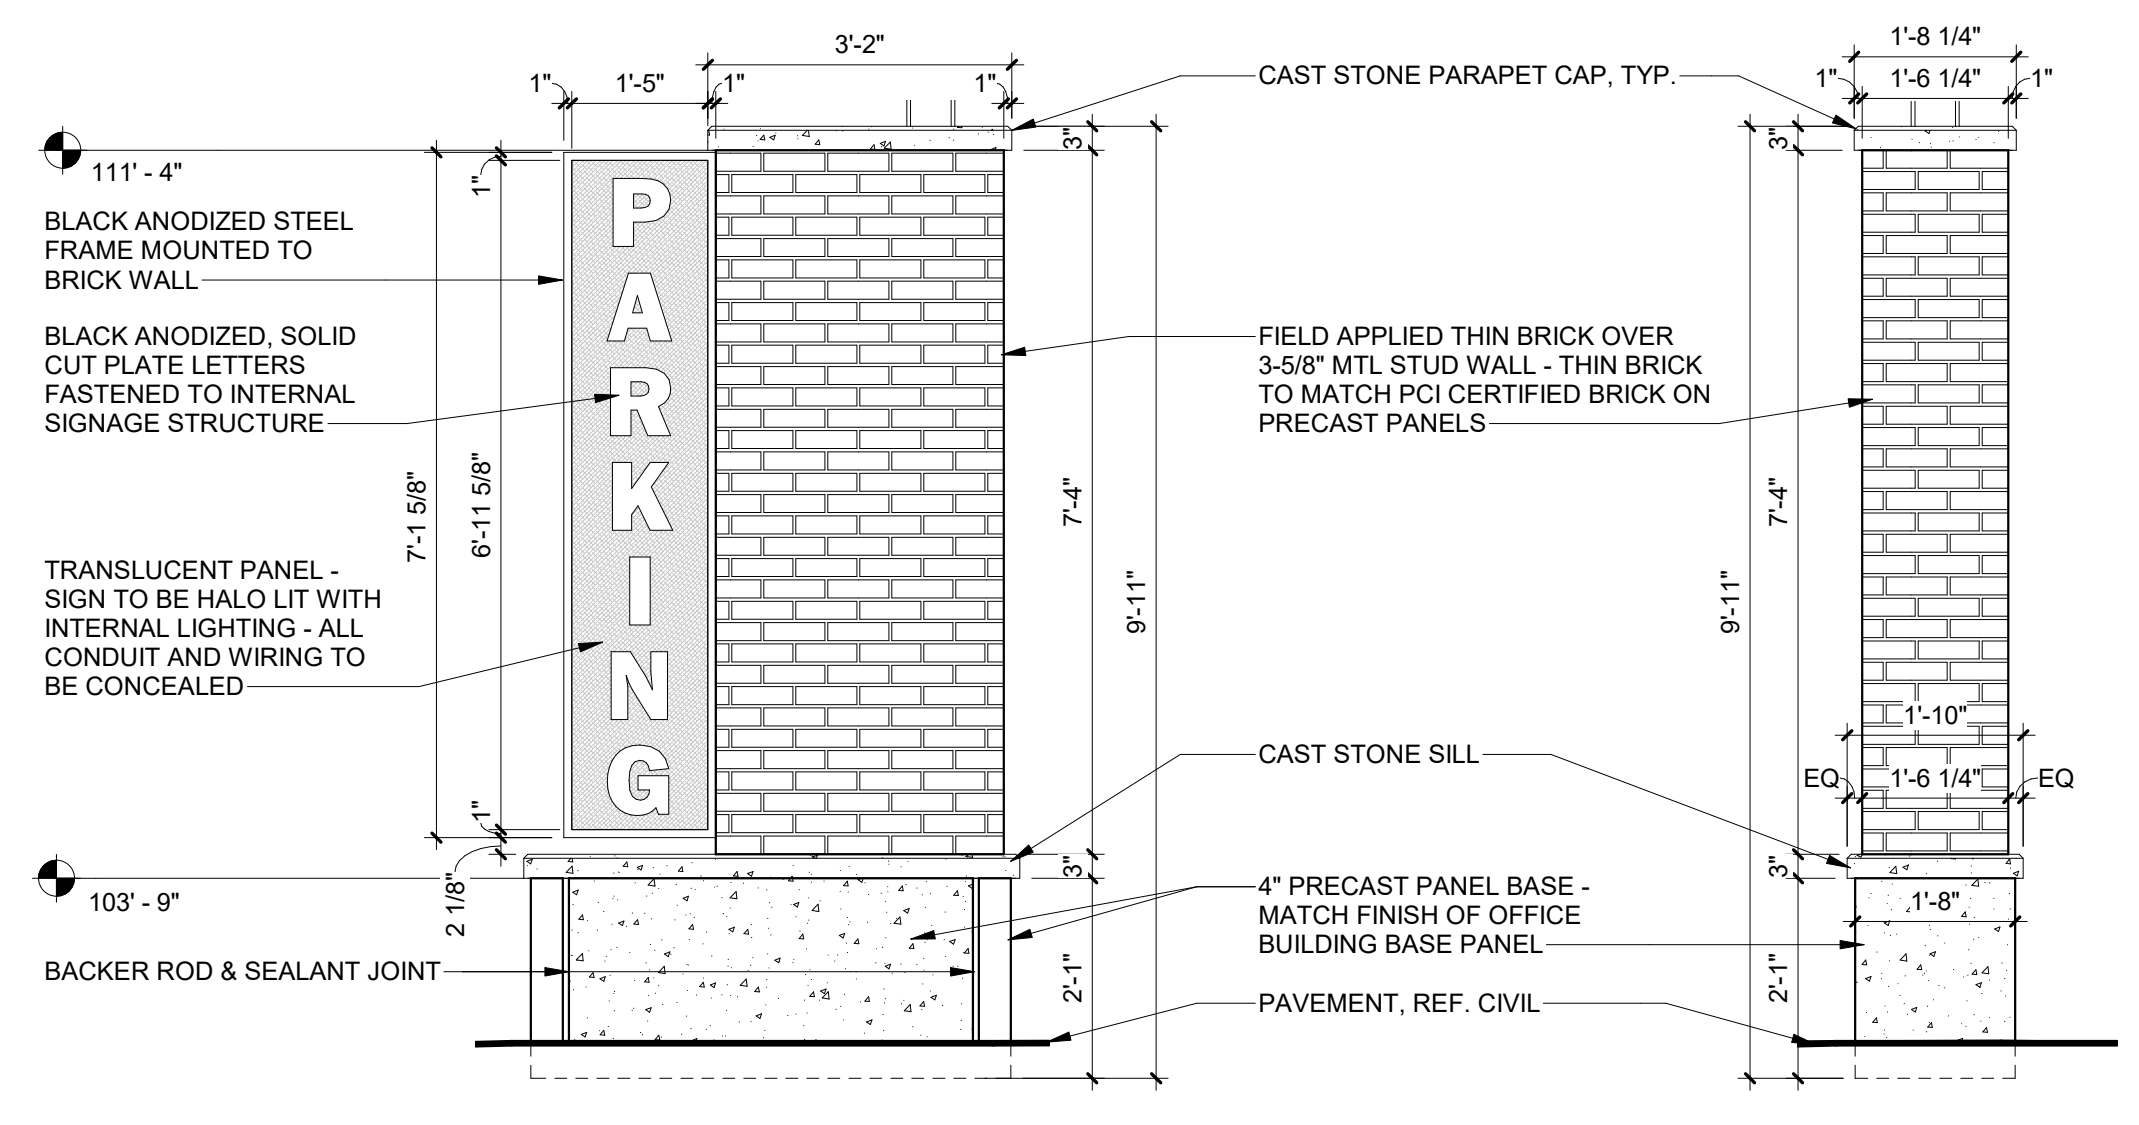


WEST ELEVATION 9 SCALE: 1/2" = 1'-0" A2.8
SOUTH ELEVATION 8 SCALE: 1/2" = 1'-0" A2.8

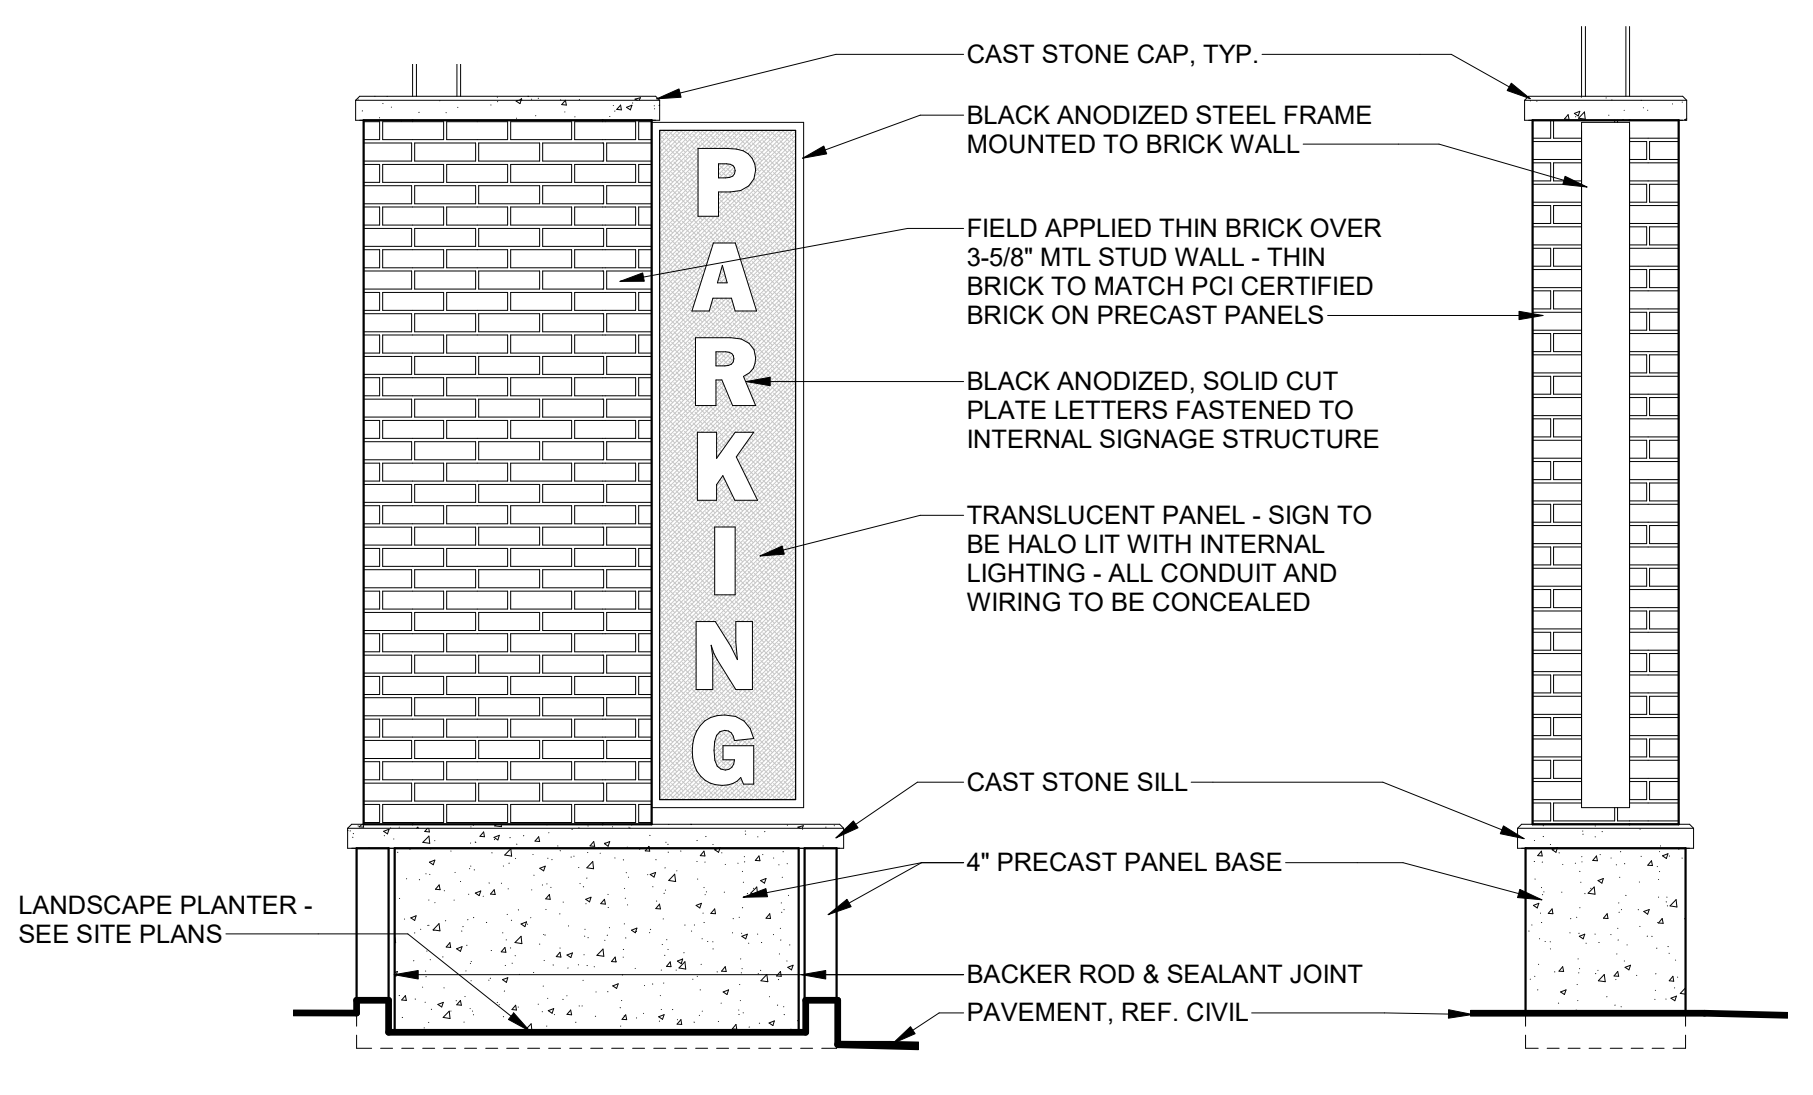


EAST ELEVATION 7 SCALE: 1/2" = 1'-0" A2.8
NORTH ELEVATION 6 SCALE: 1/2" = 1'-0" A2.8

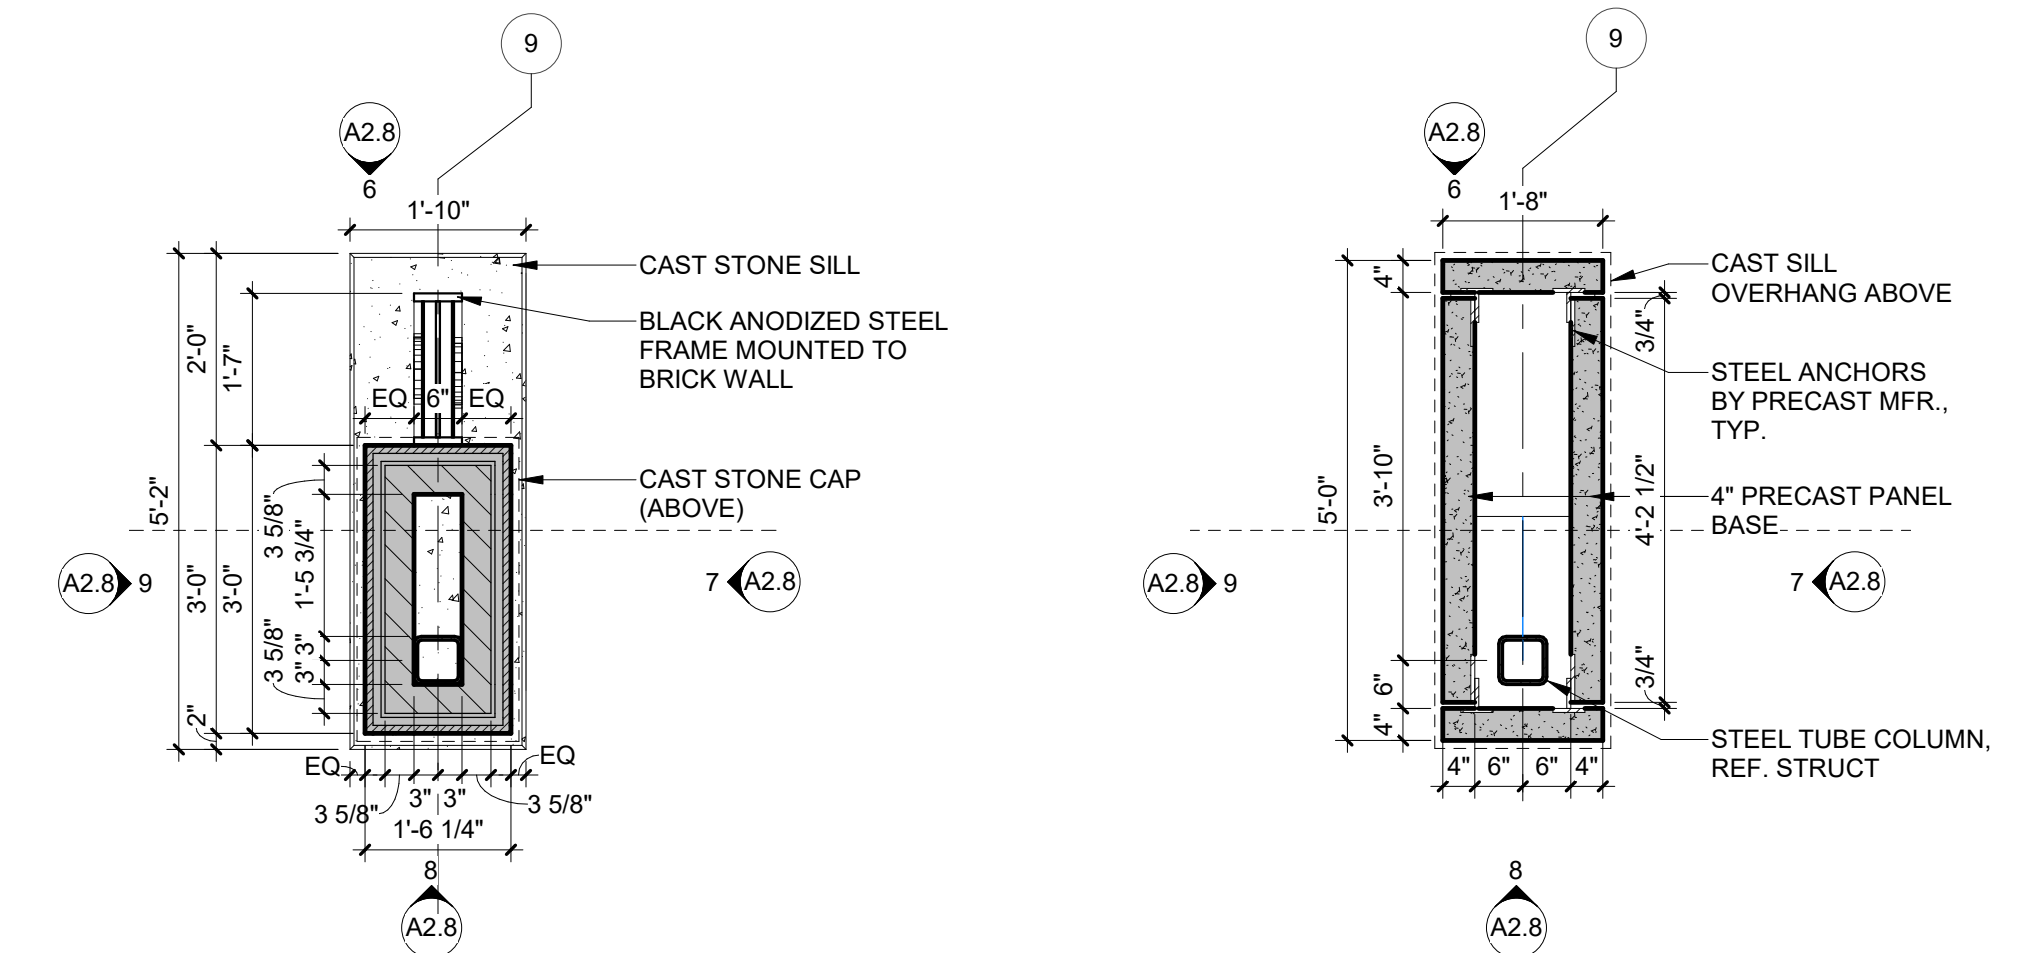


ENLARGED PLAN - MONUMENT SIGN 5 SCALE: 1/2" = 1'-0" A2.8
ENLARGED PLAN - MONUMENT SIGN 4 SCALE: 1/2" = 1'-0" A2.8

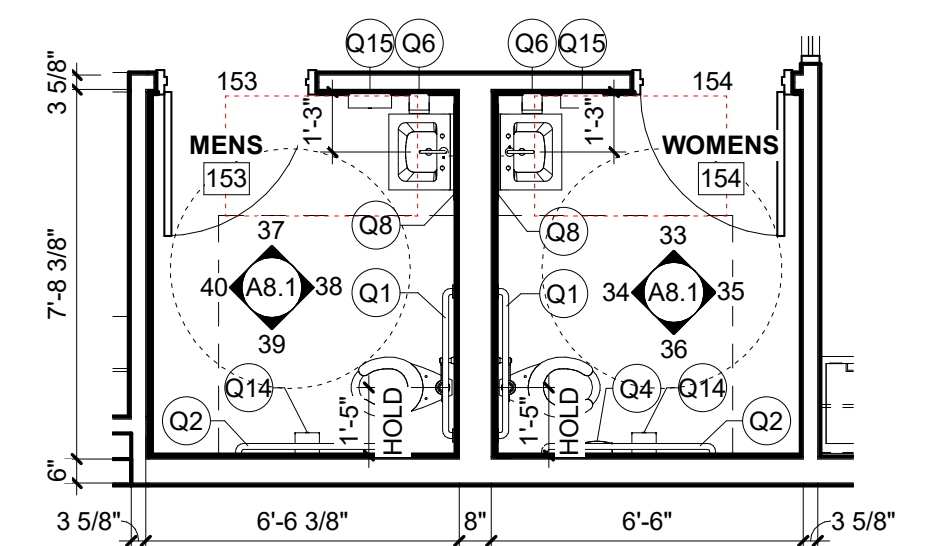

ENLARGED PLAN - VETERANS RESTROOM 3 SCALE: 1/4" = 1'-0" A2.8

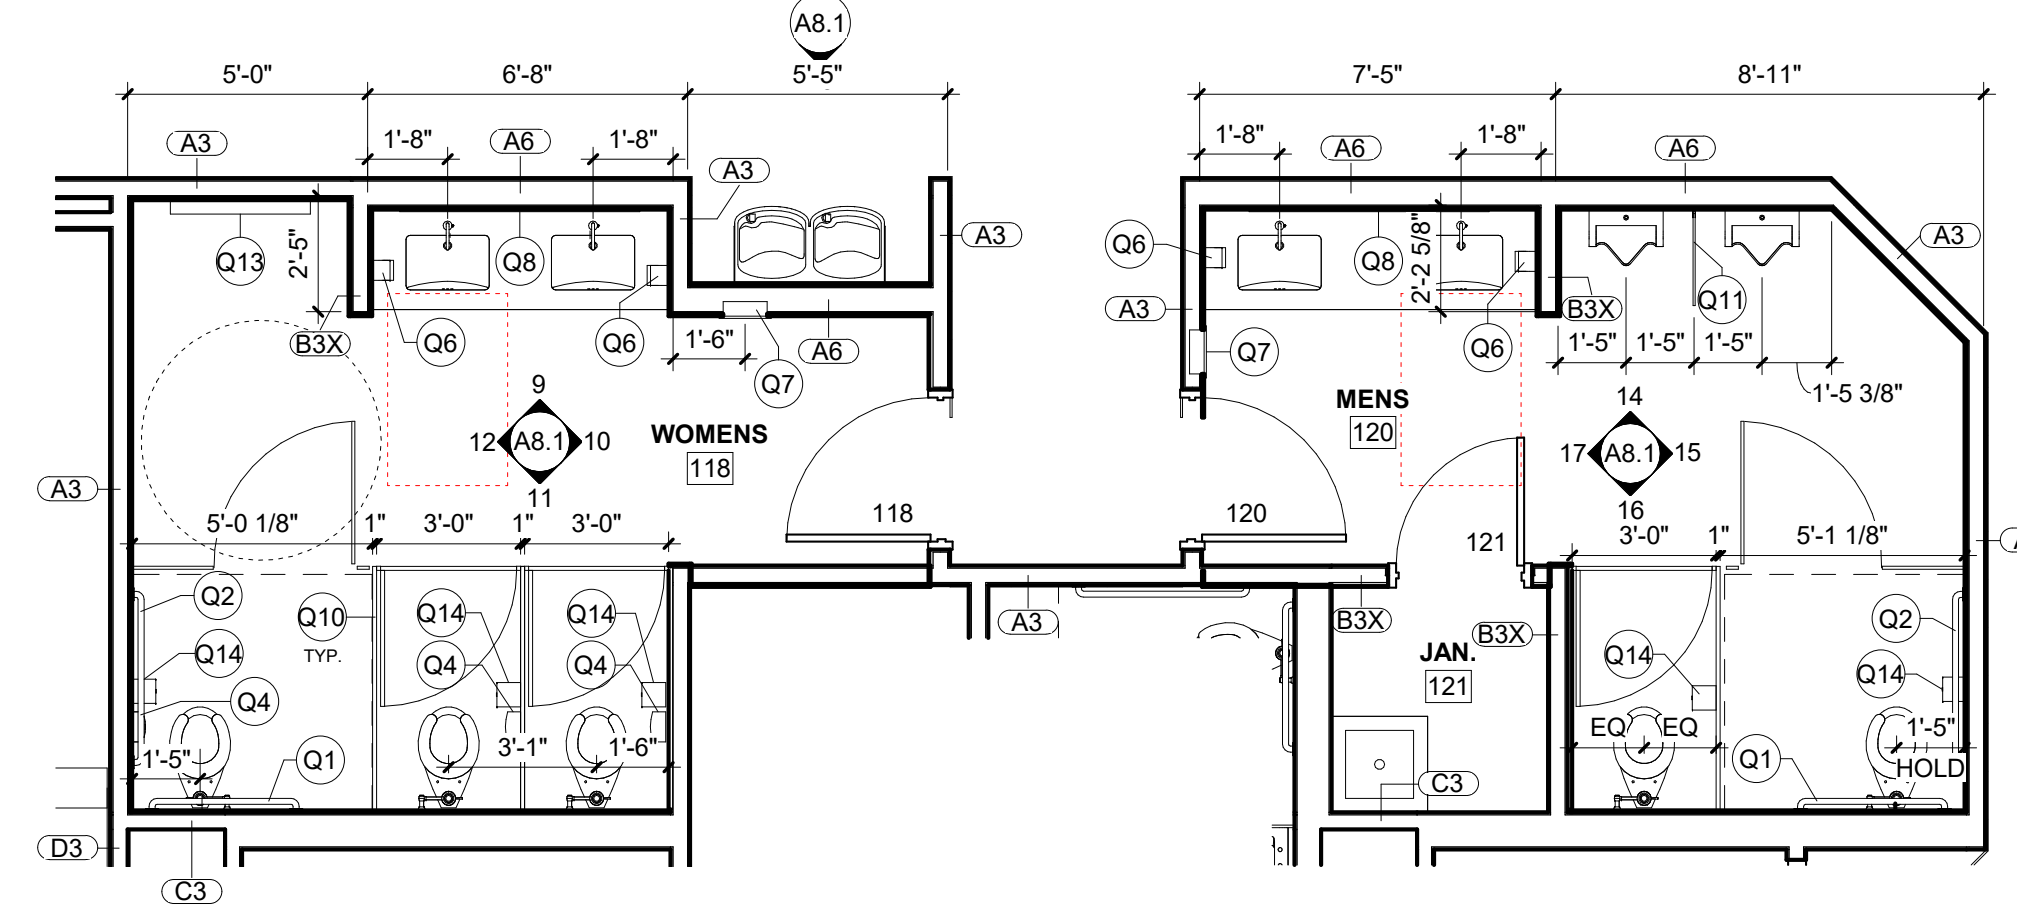

ENLARGED PLAN - PUBLIC RESTROOMS 2 SCALE: 1/4" = 1'-0" A2.8

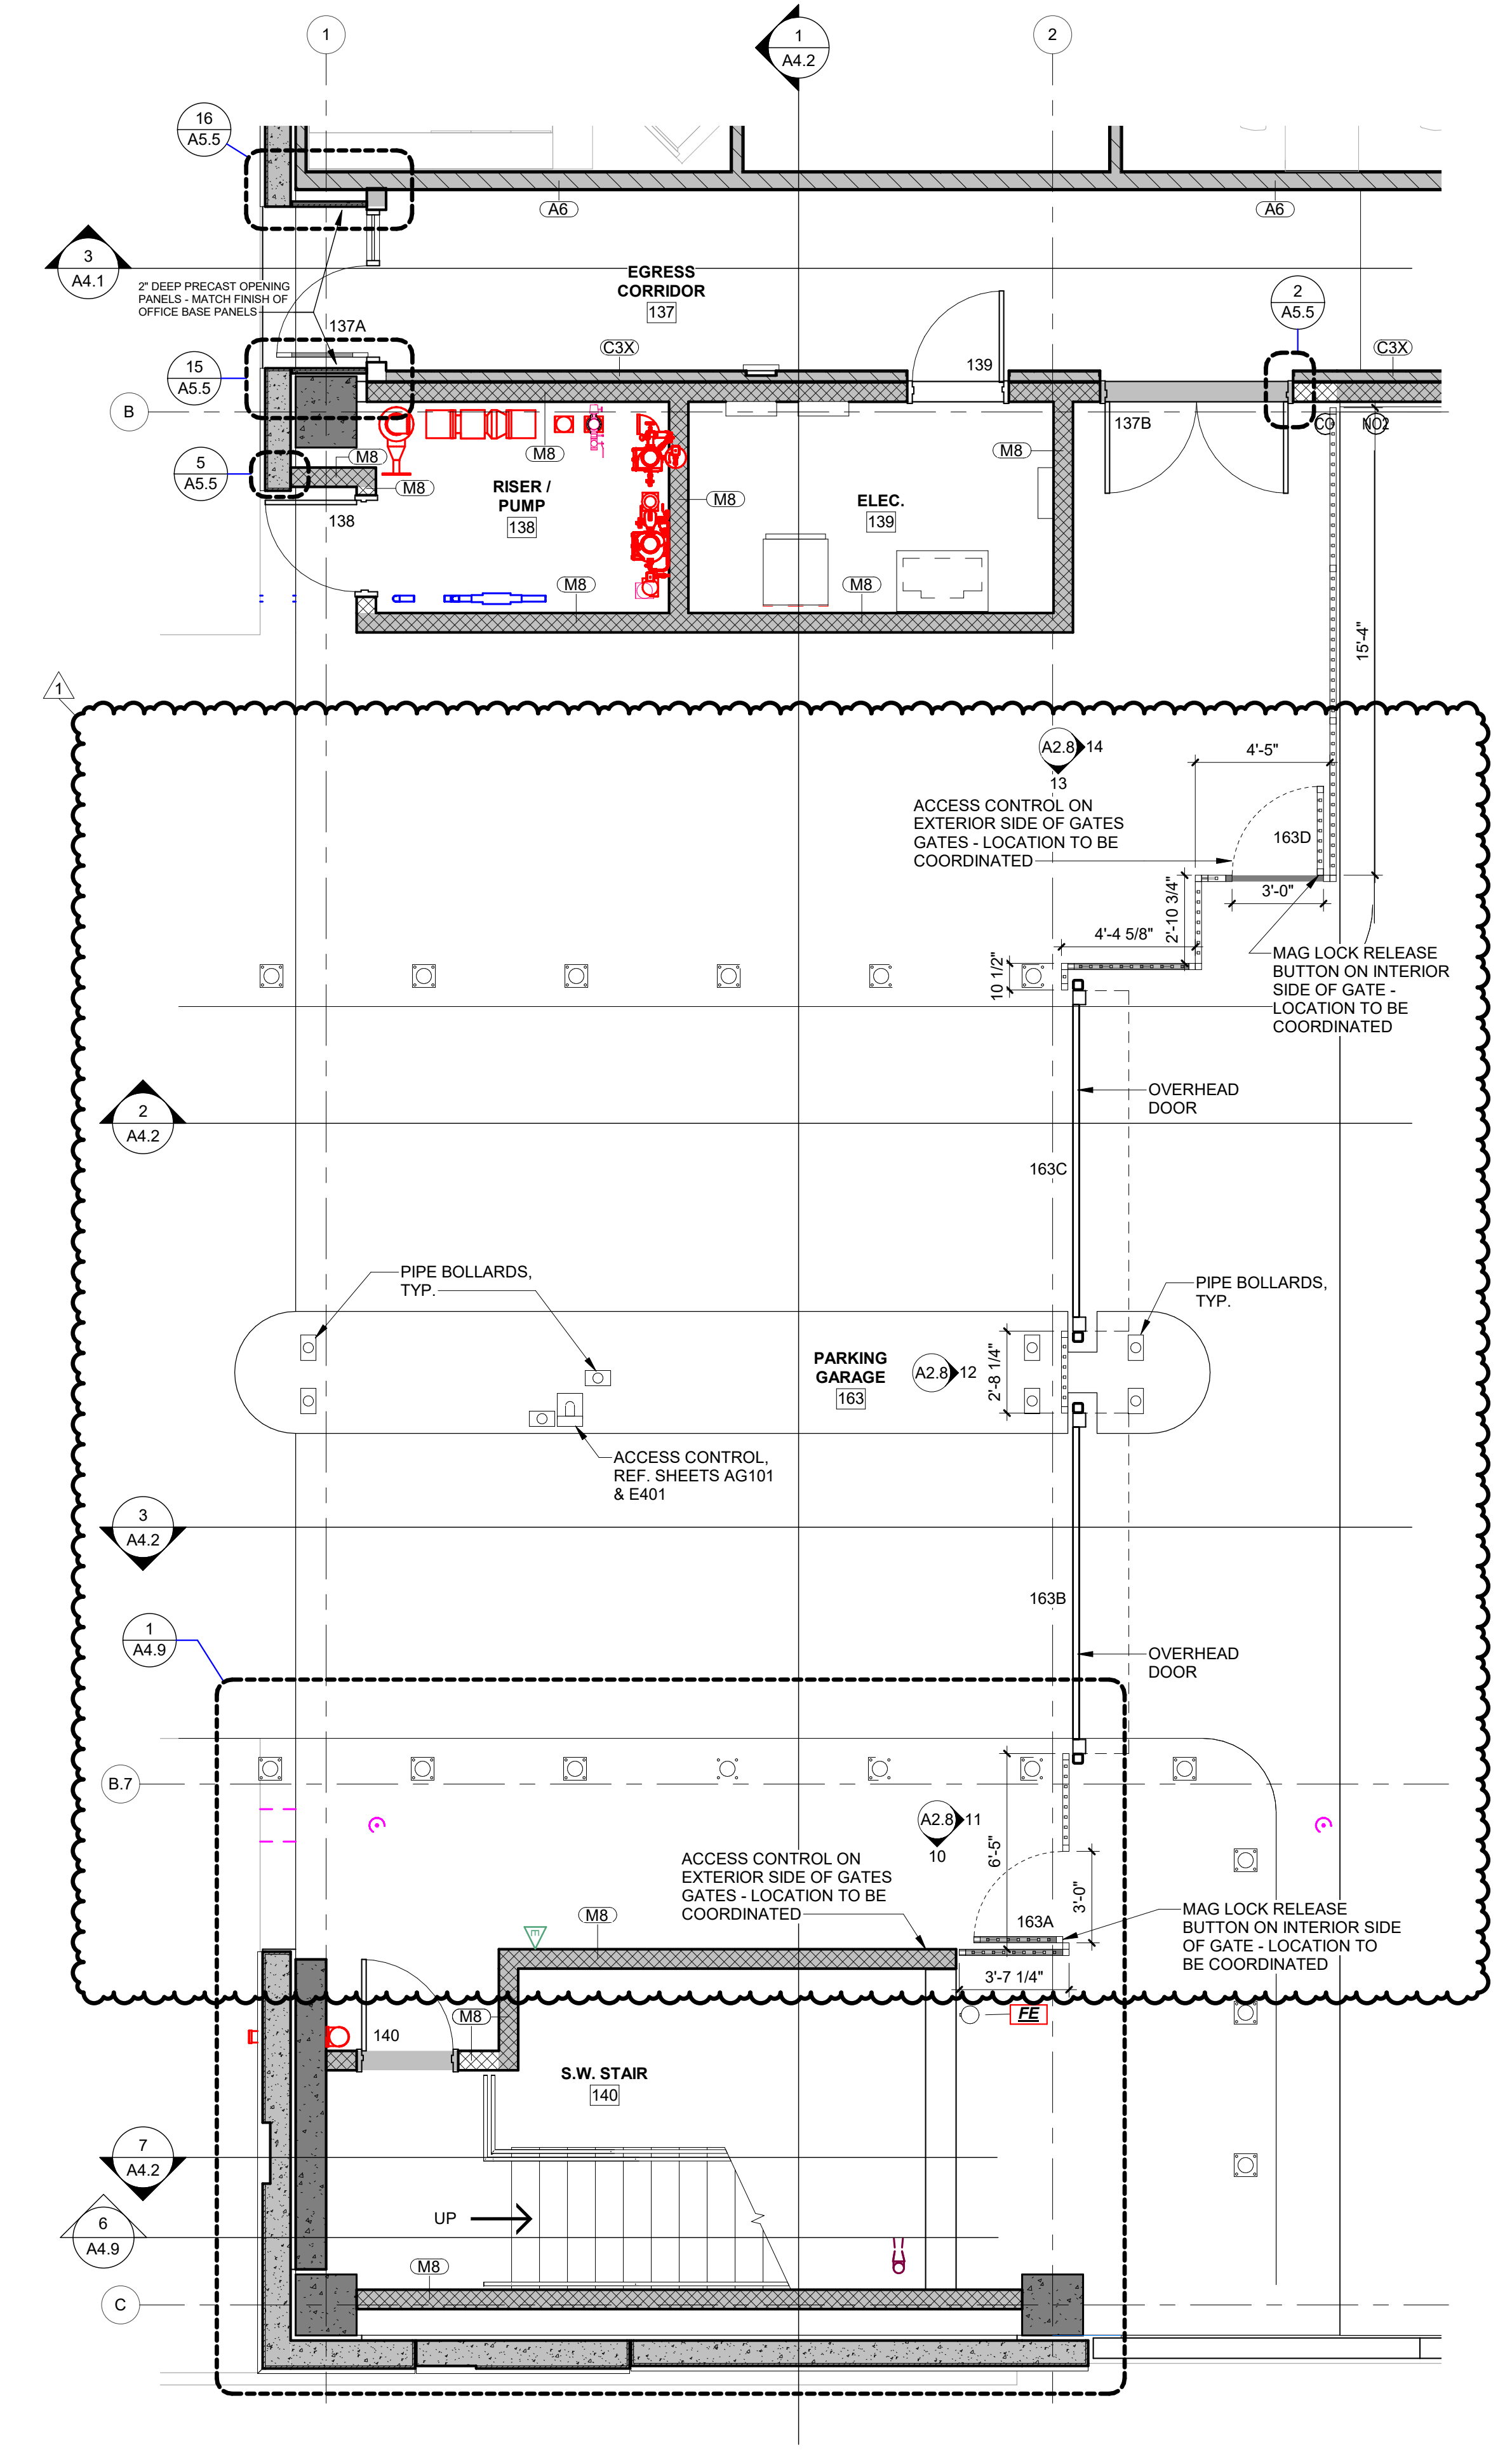


ENLARGED PLAN - SW - OFFICE LEVEL & GARAGE TIER G & RESTROOMS 1 SCALE: 1/4" = 1'-0" A2.8

Q#	ACCESSORY SCHEDULE	TAG	DESCRIPTION	MANUF.	MODEL #
Q1	36" W STRAIGHT 1-1/2" DIA ADA GRAB BAR			BOBRICK	B-6806 X 36
Q2	42" W STRAIGHT 1-1/2" DIA ADA GRAB BAR			BOBRICK	B-6806 X 42
Q3	DOUBLE-ROLL TOILET TISSUE DISPENSER			KC IN-SIGHT	09551
Q4	SURFACE-MOUNT SANITARY NAPKIN DISPOSAL			BOBRICK	B-254
Q5	RECESSED TOILET SEAT COVER DISPENSER			KC IN-SIGHT	09506
Q6	MANUAL WALL-MOUNTED SOAP DISPENSER			KC PROFESSIONAL	92145
Q7	RECESSED PAPER TOWEL DISPENSER/WASTE			BOBRICK	B-38034
Q8	FRAMELESS CLEAR GLASS MIRROR			TO SUBMIT	SIZE AS DRAWN
Q9	WELDED FRAME MIRROR			BOBRICK	B-290 2472
Q10	HDPE FLOOR MOUNTED TOILET PARTITIONS - HINY HIDERS			SCRANTON PROD.	STANDARD HEIGHT, COLOR GREY
Q11	18" URINAL SCREEN - TO MATCH Q10			SCRANTON PROD.	
Q12	RECESSED SANITARY PRODUCT VENDOR (NO COIN OPERATION)			BOBRICK	B-37063C
Q13	WALL MOUNTED BABY CHANGING TABLE			KOALAKARE	KB110-SSWM
Q14	SURFACE MOUNTED TOILET PAPER DISPENSER			BOBRICK	B-2888
Q15	WALL MOUNTED PAPER TOWEL DISPENSER			BOBRICK	B-262


NOTES:
1. CONTRACTOR TO COORDINATE MISC. BLOCKING IN WALLS AS REQUIRED FOR TOILET ACCESSORIES.
2. ALL MOUNTING HEIGHTS AND CLEARANCES SHALL MEET TAS REQUIREMENTS.
3. SUBSTITUTIONS MUST BE SUBMITTED TO ARCHITECT FOR APPROVAL PRIOR TO ORDERING.
4. SLOPE FLOOR TO DRAINS AT LOCATIONS AS SHOWN. TOTAL SLOPE OF FLOORS SHALL NOT EXCEED SLOPE OF 1:50 IN ANY DIRECTION.
5. ALL ACCESSIBLE 'CLEAR' AND 'HOLD' DIMENSIONS ARE FROM FINISHED FACE TO FINISHED FACE OF MATERIAL.

A NEW FACILITY FOR
GREGG COUNTY - PARKING GARAGE & OFFICE
100 E. METHAVIN ST.
LONGVIEW, TX 75601

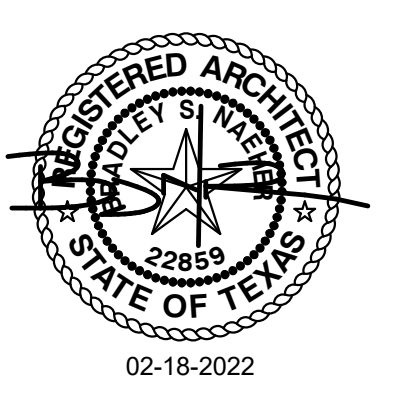

PROJECT NO.: 20011
DATE: 03/03/2022

REVISION SCHEDULE	
A. Description	Date
1. ADDENDUM 04	03-17-2022

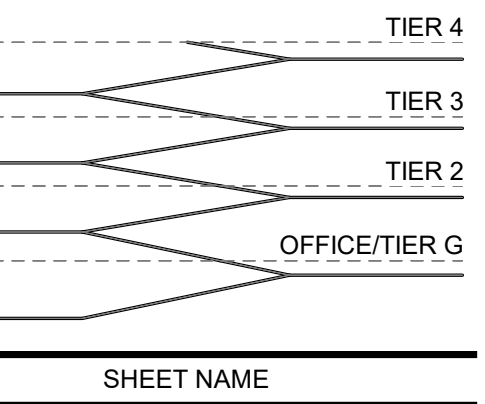


ENLARGED PLAN - SW - OFFICE LEVEL & GARAGE TIER G & RESTROOMS


SHEET NO.

A2.8


- GENERAL DOOR NOTES:**
- A. 1'-4" WIDE X 3" DEEP RECESS
 - B. 1'-4" WIDE X 2" DEEP RECESS
 - C. 1'-4" WIDE X 1" DEEP RECESS - RECESS TO BE VENEERED WITH MATCHING THIN BRICK
 - D. 2" WIDE X 3" DEEP RECESS
 - E. 2" WIDE X 2" DEEP RECESS
 - F. 2" WIDE X 3" DEEP RECESS - RECESS TO BE VENEERED WITH MATCHING THIN BRICK
 - G. 1" WIDE X 2" DEEP RECESS - RECESS TO BE VENEERED WITH MATCHING THIN BRICK
 - H. 6" DEEP X 2" WIDE VERTICAL ALUMINUM LOUVERS @ 5'-14" MAX O.C. - LOUVERS PREFINISHED CLEAR ANODIZED - MUST MEET 200LB PEDESTRIAN GUARDRAIL STANDARDS
 - I. 1" WIDE X 3" DEEP RECESS
 - J. 1" WIDE X 2" DEEP RECESS
 - K. 1" WIDE X 1" DEEP RECESS - RECESS TO BE VENEERED WITH MATCHING THIN BRICK
- NOTE: "PJ" = PANEL JOINT (AKA EXPANSION JOINT)
"CJ" = STANDARD CONTROL JOINT
"ES" = EXTERIOR SCOTCH, REF. ELECT.

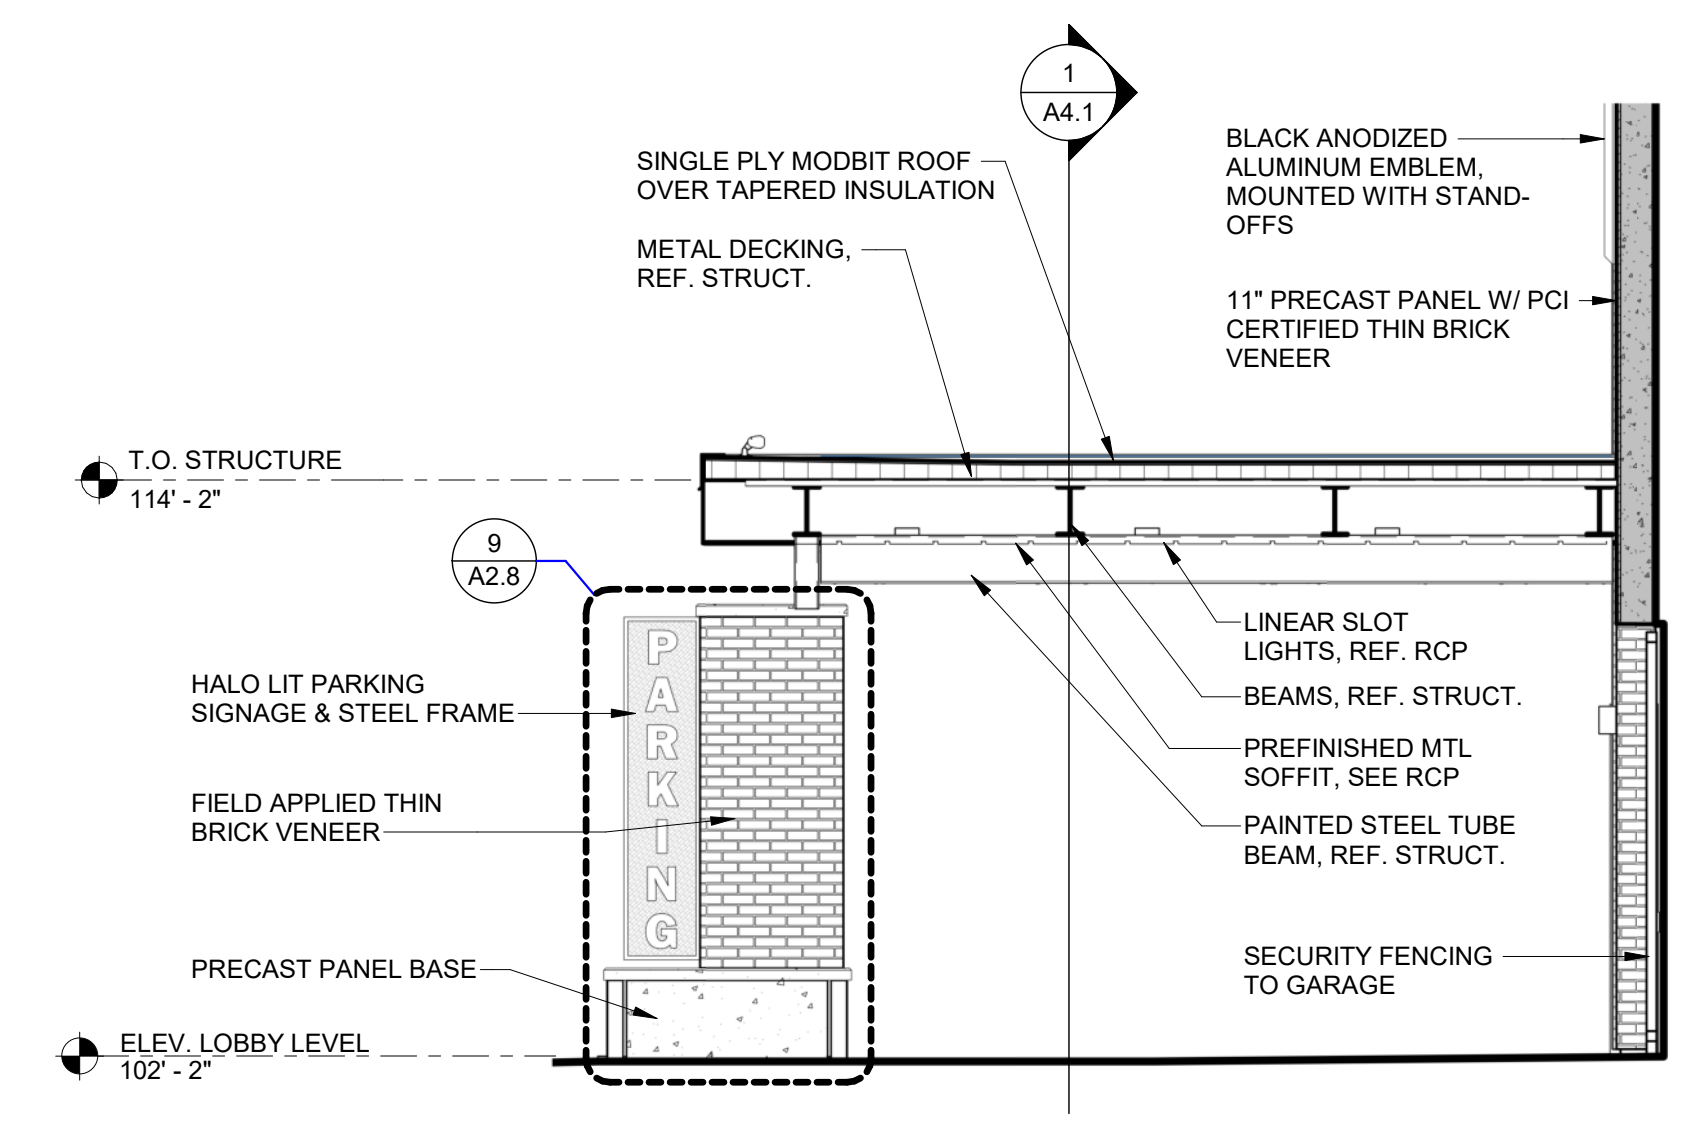

WEST CANOPY & SIGNAGE ELEVATION / SECTION 6
SCALE: 1/4" = 1'-0" A3.1

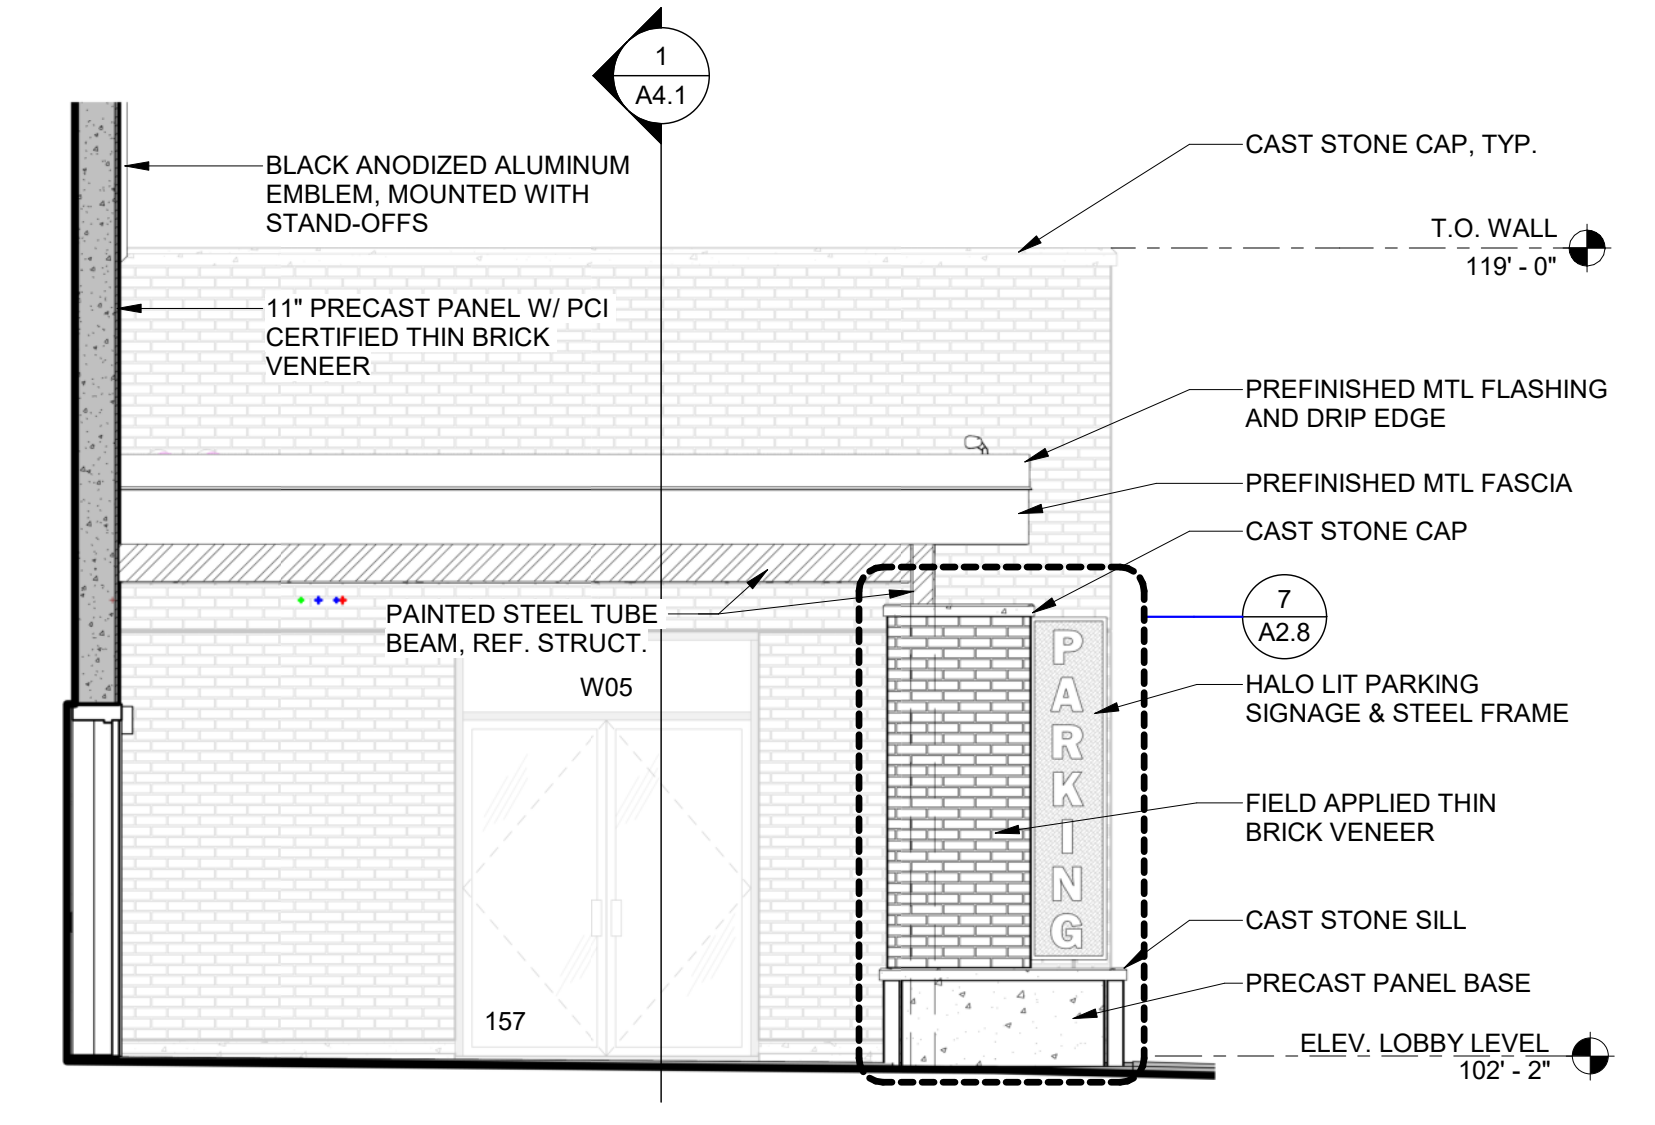


EAST CANOPY & SIGNAGE ELEVATION / SECTION 5
SCALE: 1/4" = 1'-0" A3.1

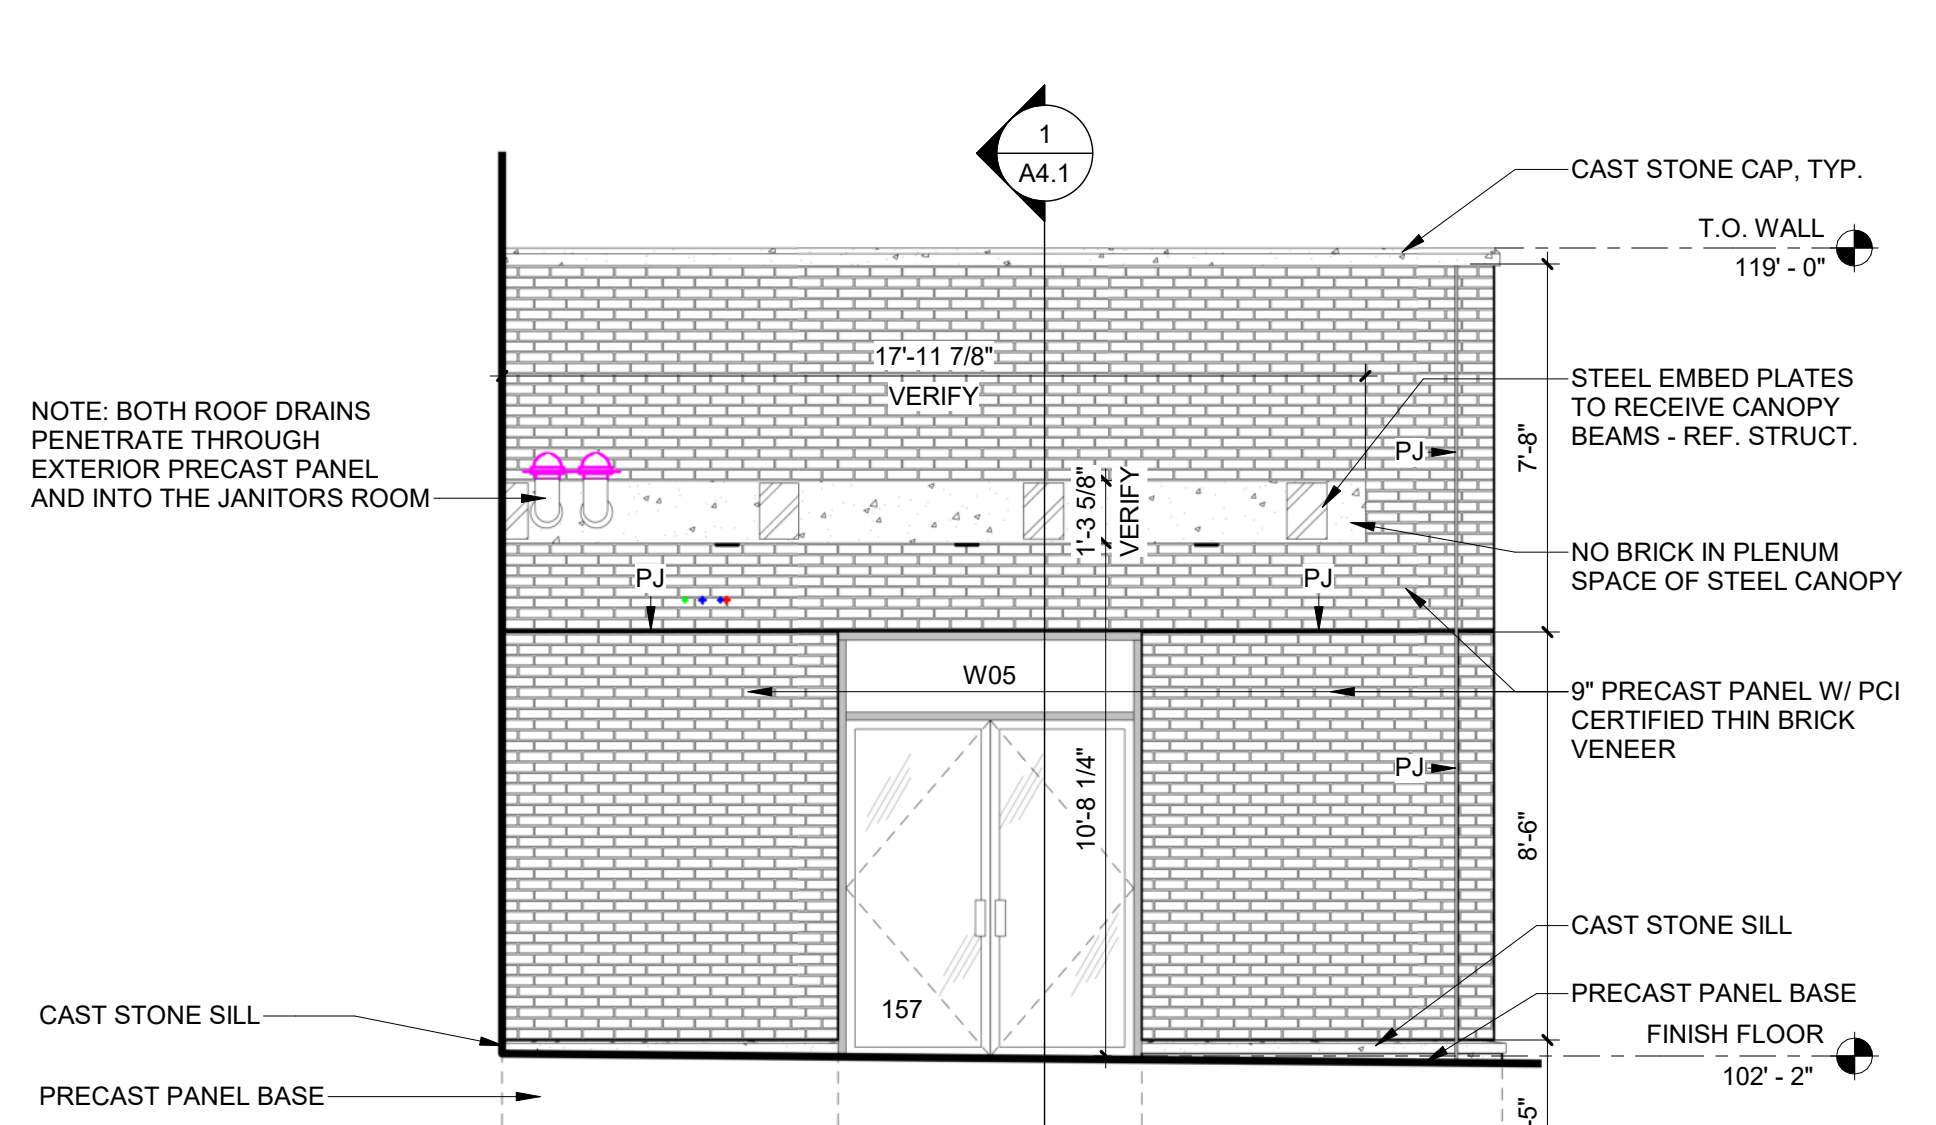


EAST ENTRANCE ELEVATION 4
SCALE: 1/4" = 1'-0" A3.1



GREGG COUNTY SEAL 3
SCALE: 1/2" = 1'-0" A3.1

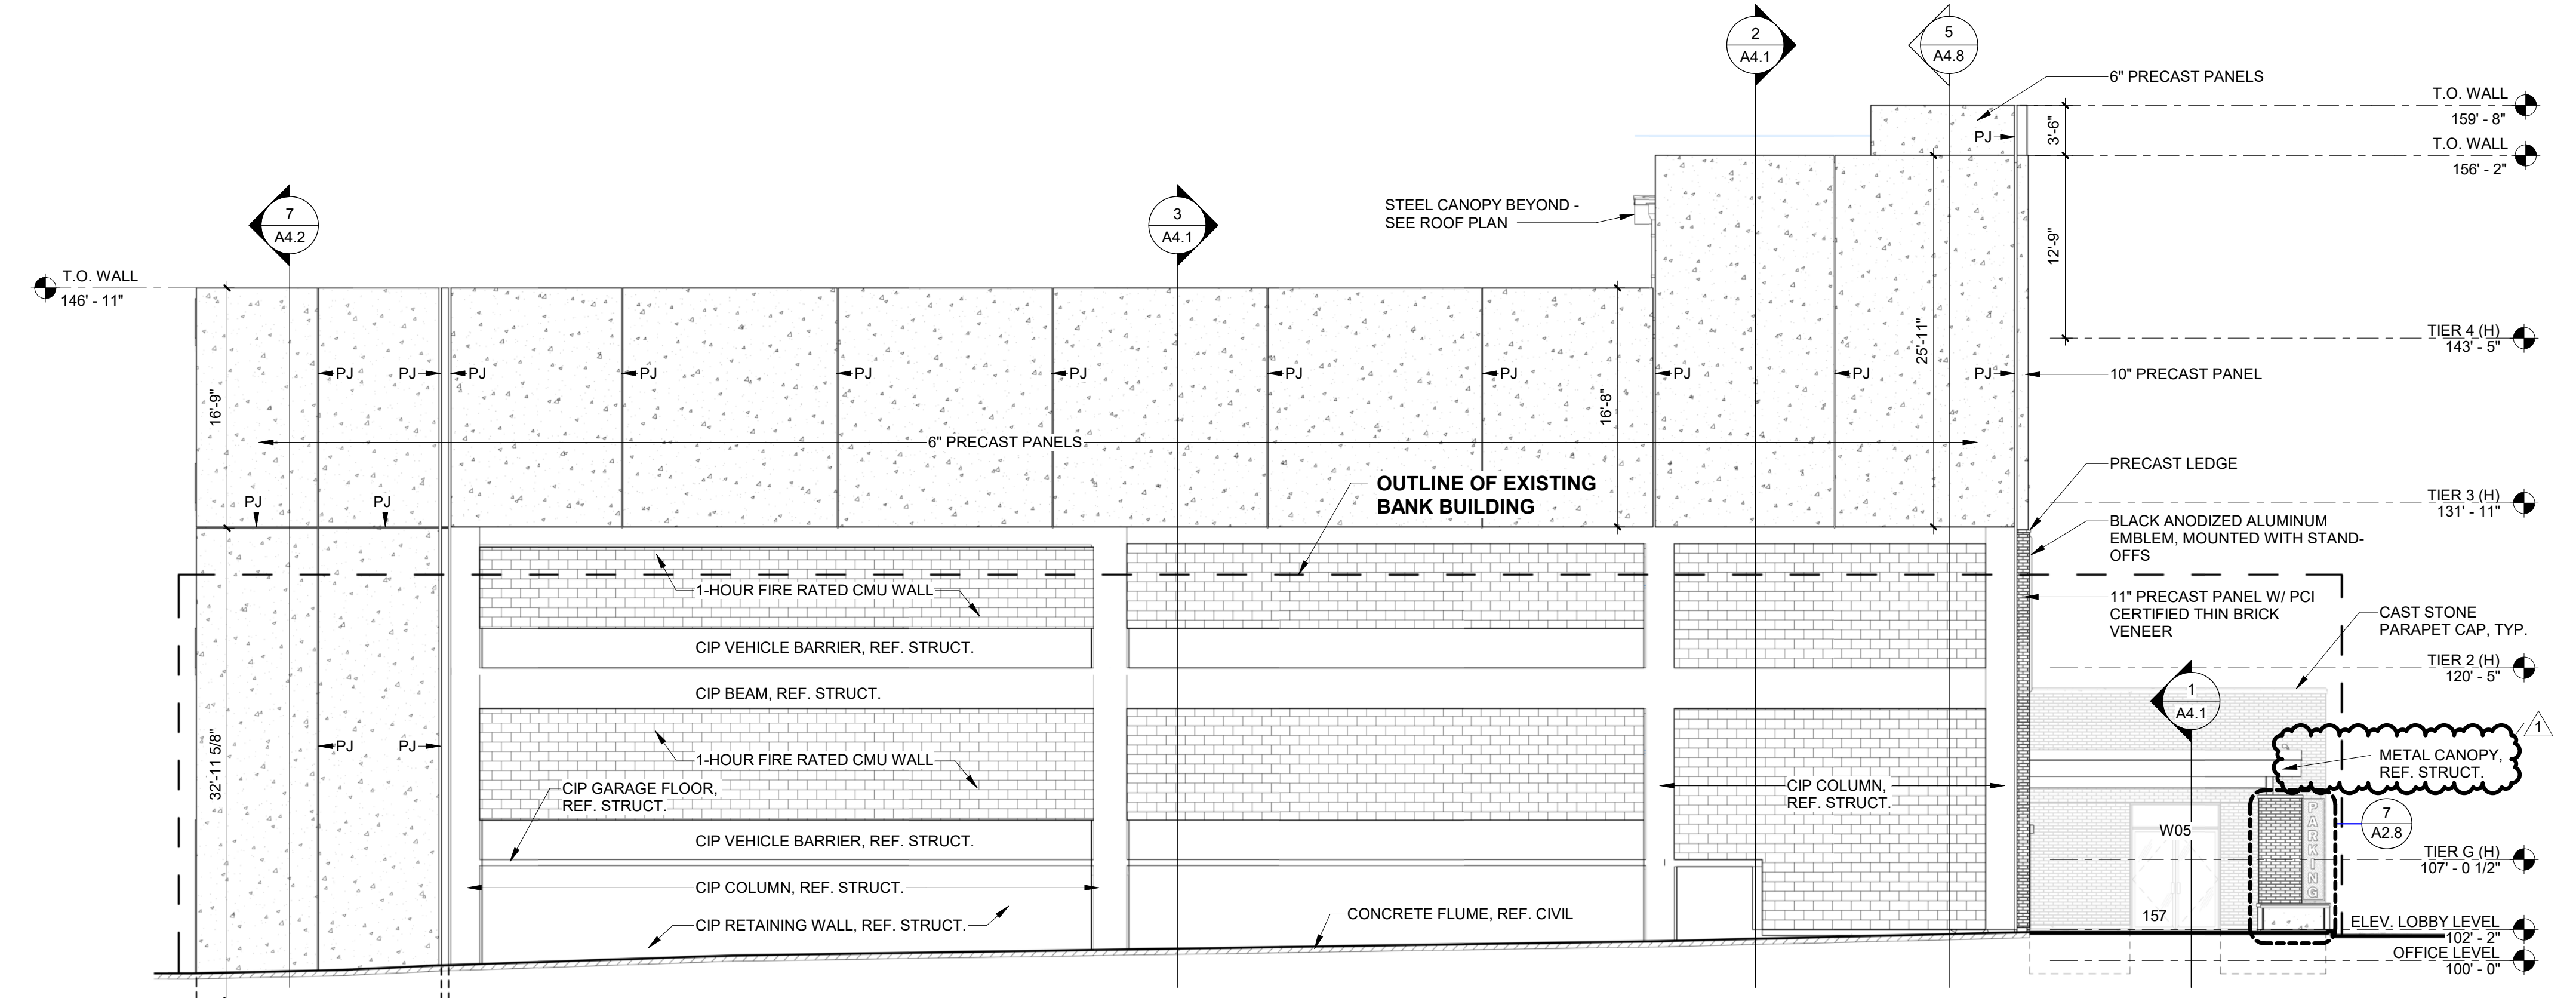

EAST ELEVATION 2
SCALE: 1/8" = 1'-0" A3.1

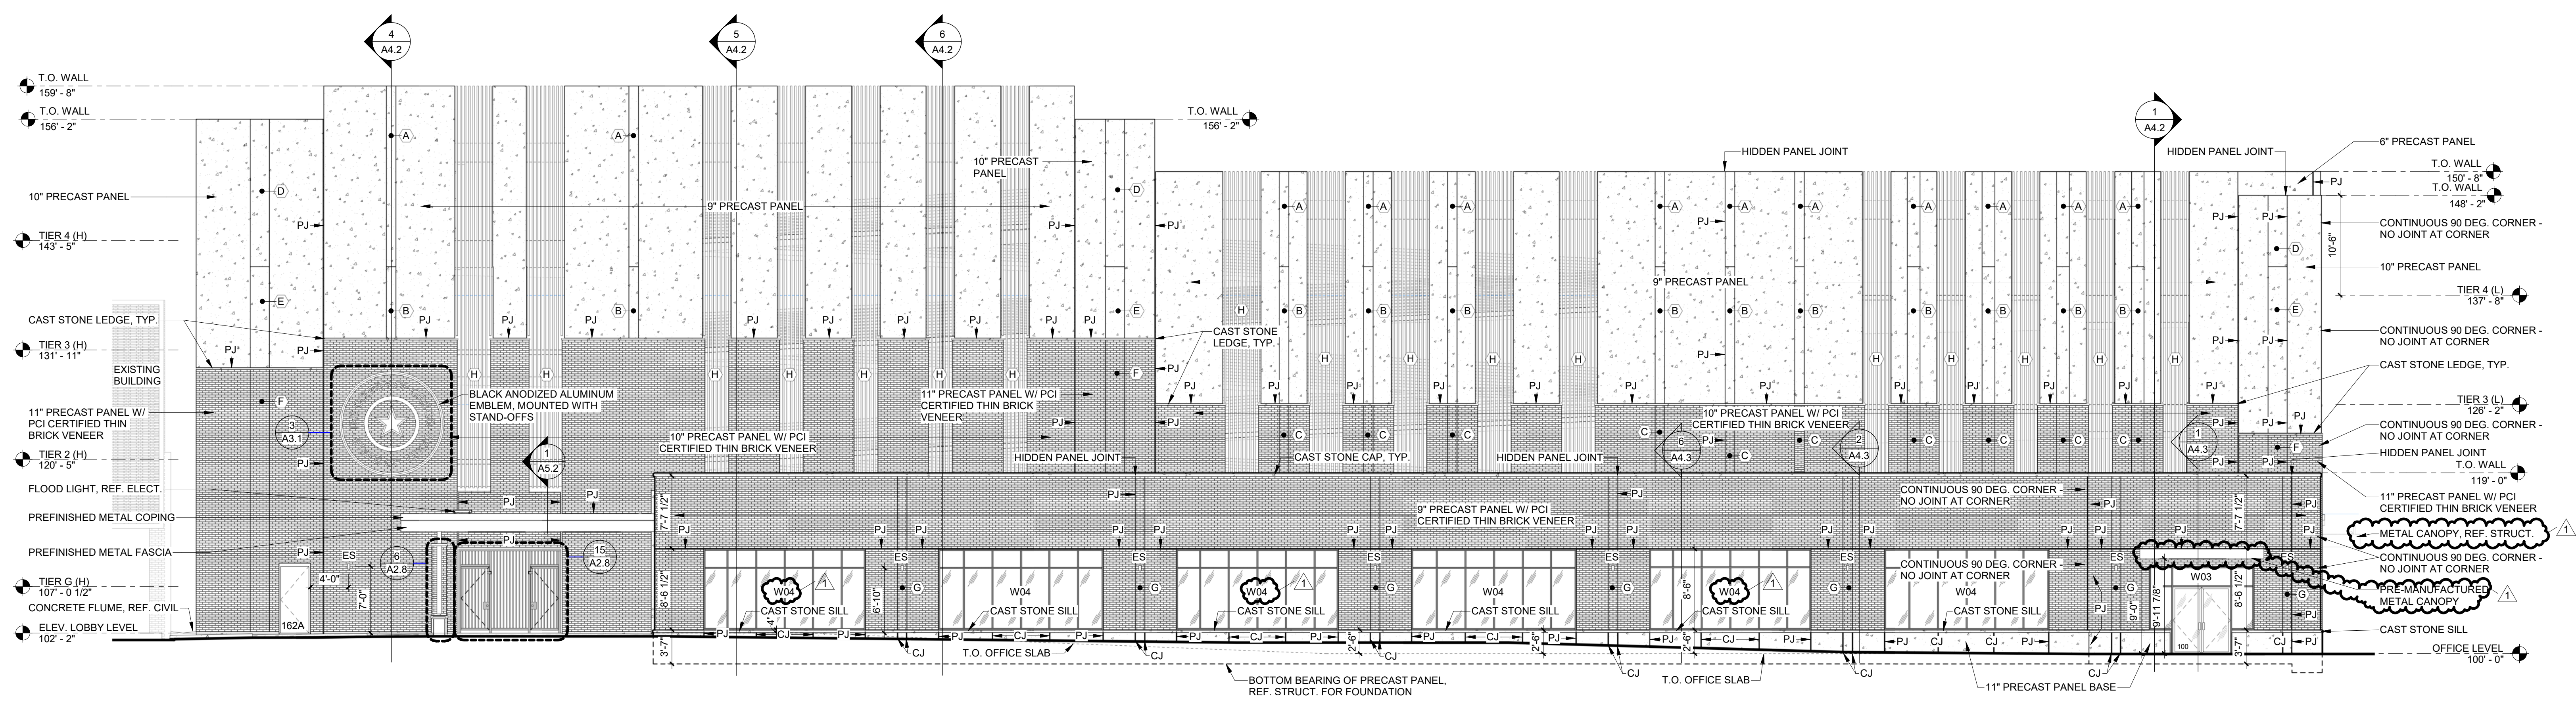

NORTH ELEVATION 1
SCALE: 1/8" = 1'-0" A3.1

A NEW FACILITY FOR
**GREGG COUNTY - PARKING
GARAGE & OFFICE**
100 E. METHAVIN ST.
LONGVIEW, TX 75601



PROJECT NO.: 20011
DATE: 03/03/2022

REVISION SCHEDULE	
A. Description	Date
1. ADDENDUM 04	03-17-2022

SHEET NAME


EXTERIOR ELEVATIONS

SHEET NO.


A3.1

- GENERAL DOOR NOTES:**
- A. 1'-4" WIDE X 3" DEEP RECESS
 - B. 1'-4" WIDE X 2" DEEP RECESS
 - C. 1'-4" WIDE X 1" DEEP RECESS - RECESS TO BE VENEERED WITH MATCHING THIN BRICK
 - D. 2" WIDE X 3" DEEP RECESS
 - E. 2" WIDE X 2" DEEP RECESS
 - F. 2" WIDE X 3" DEEP RECESS - RECESS TO BE VENEERED WITH MATCHING THIN BRICK
 - G. 1" WIDE X 2" DEEP RECESS - RECESS TO BE VENEERED WITH MATCHING THIN BRICK
 - H. 6" DEEP X 2" WIDE VERTICAL ALUMINUM LOUVERS @ 5'-14" MAX O.C. - LOUVERS PREFINISHED CLEAR ANODIZED - MUST MEET 200LB PEDESTRIAN GUARDRAIL STANDARDS
 - I. 1" WIDE X 3" DEEP RECESS
 - J. 1" WIDE X 2" DEEP RECESS
 - K. 1" WIDE X 1" DEEP RECESS - RECESS TO BE VENEERED WITH MATCHING THIN BRICK
- NOTE: "P.J." = PANEL JOINT (AKA EXPANSION JOINT)
 "C.J." = STANDARD CONTROL JOINT
 "ES" = EXTERIOR SCONCE, REF. ELECT.


A NEW FACILITY FOR
GREGG COUNTY - PARKING GARAGE & OFFICE
 100 E. METHUEN ST.
 LONGVIEW, TX 75601

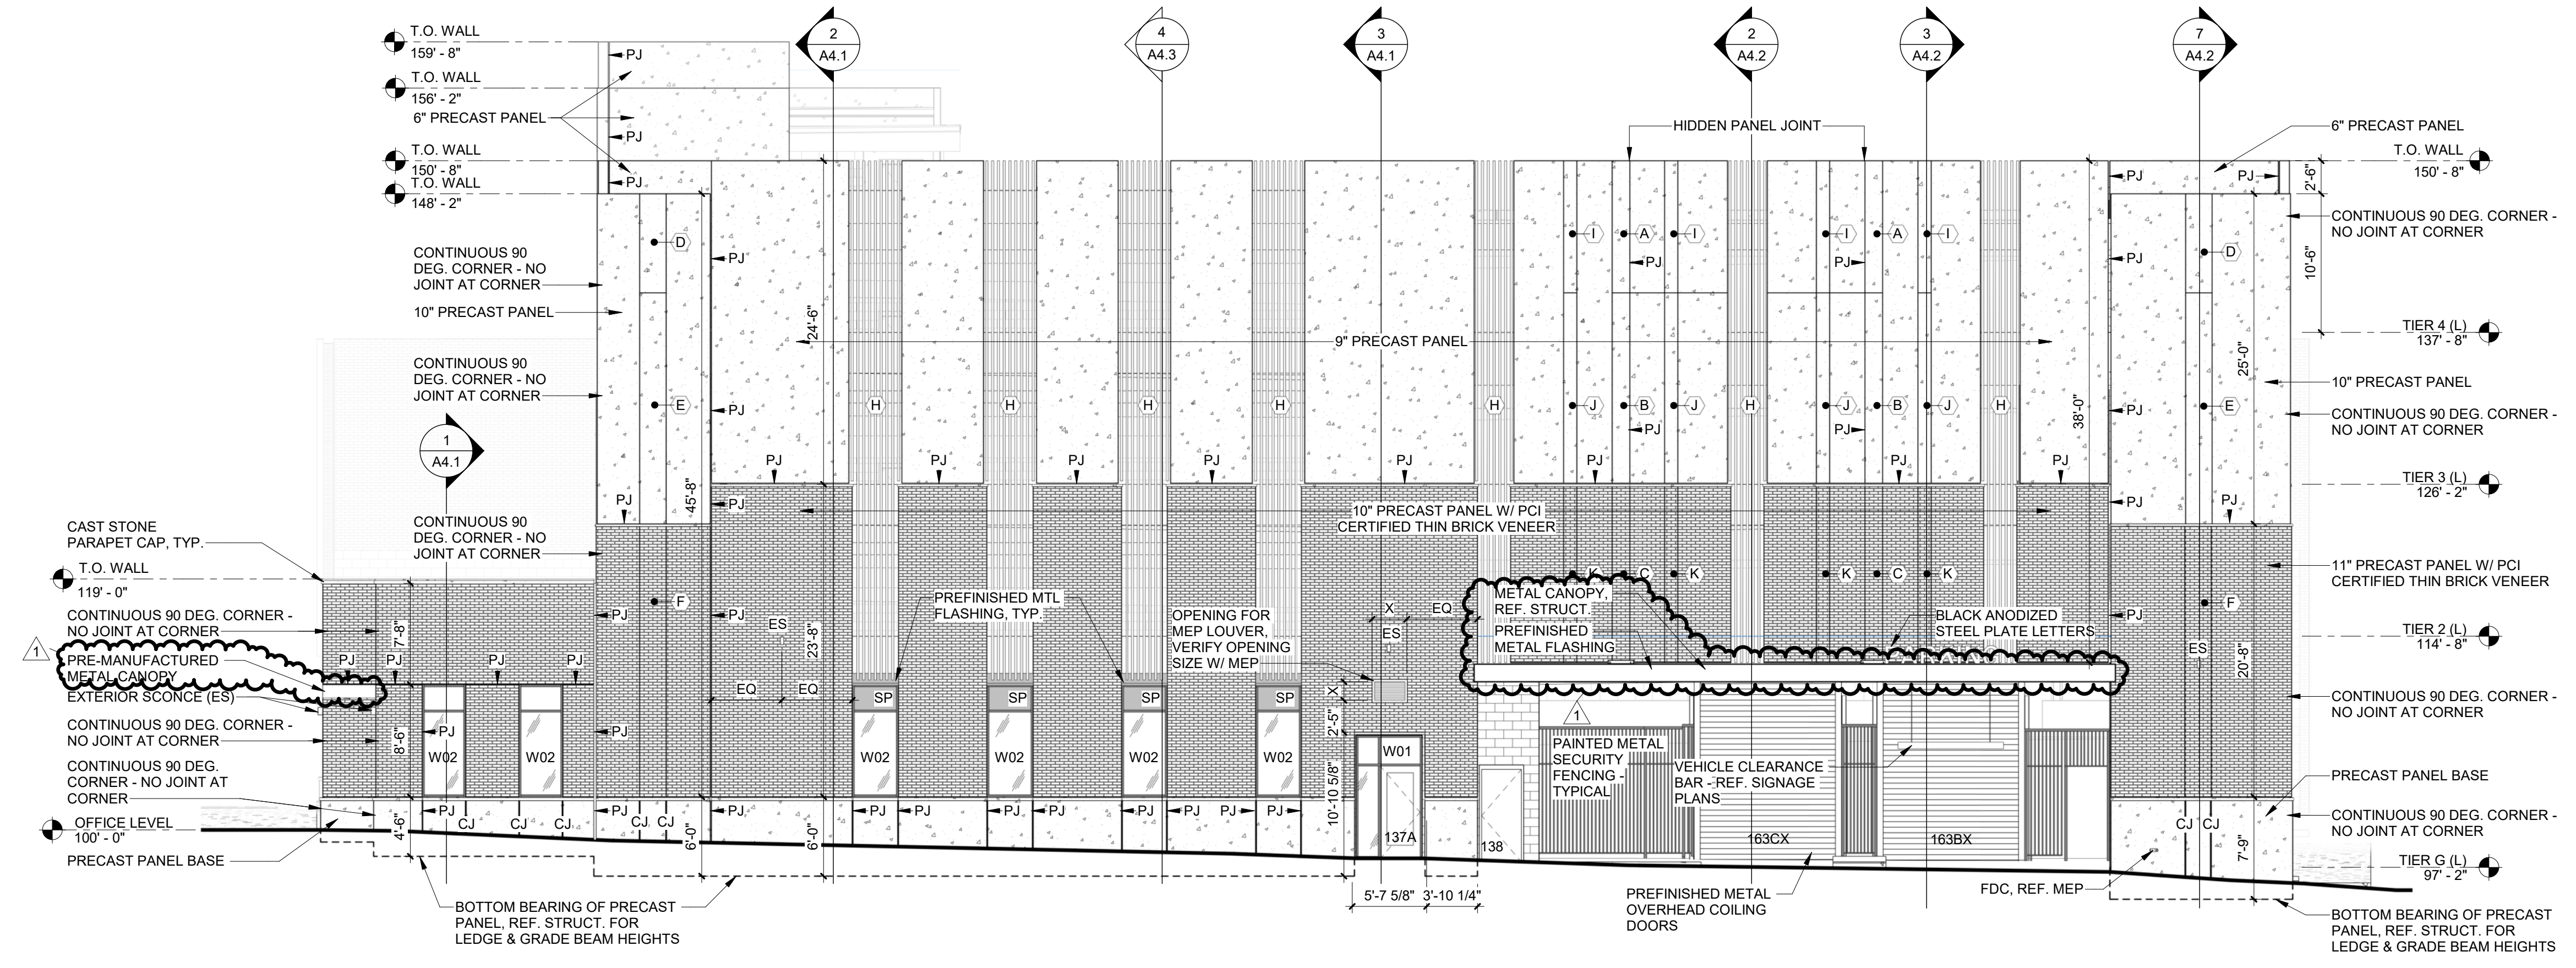

WEST ELEVATION | 2
 SCALE: 1/8" = 1'-0" A3.2

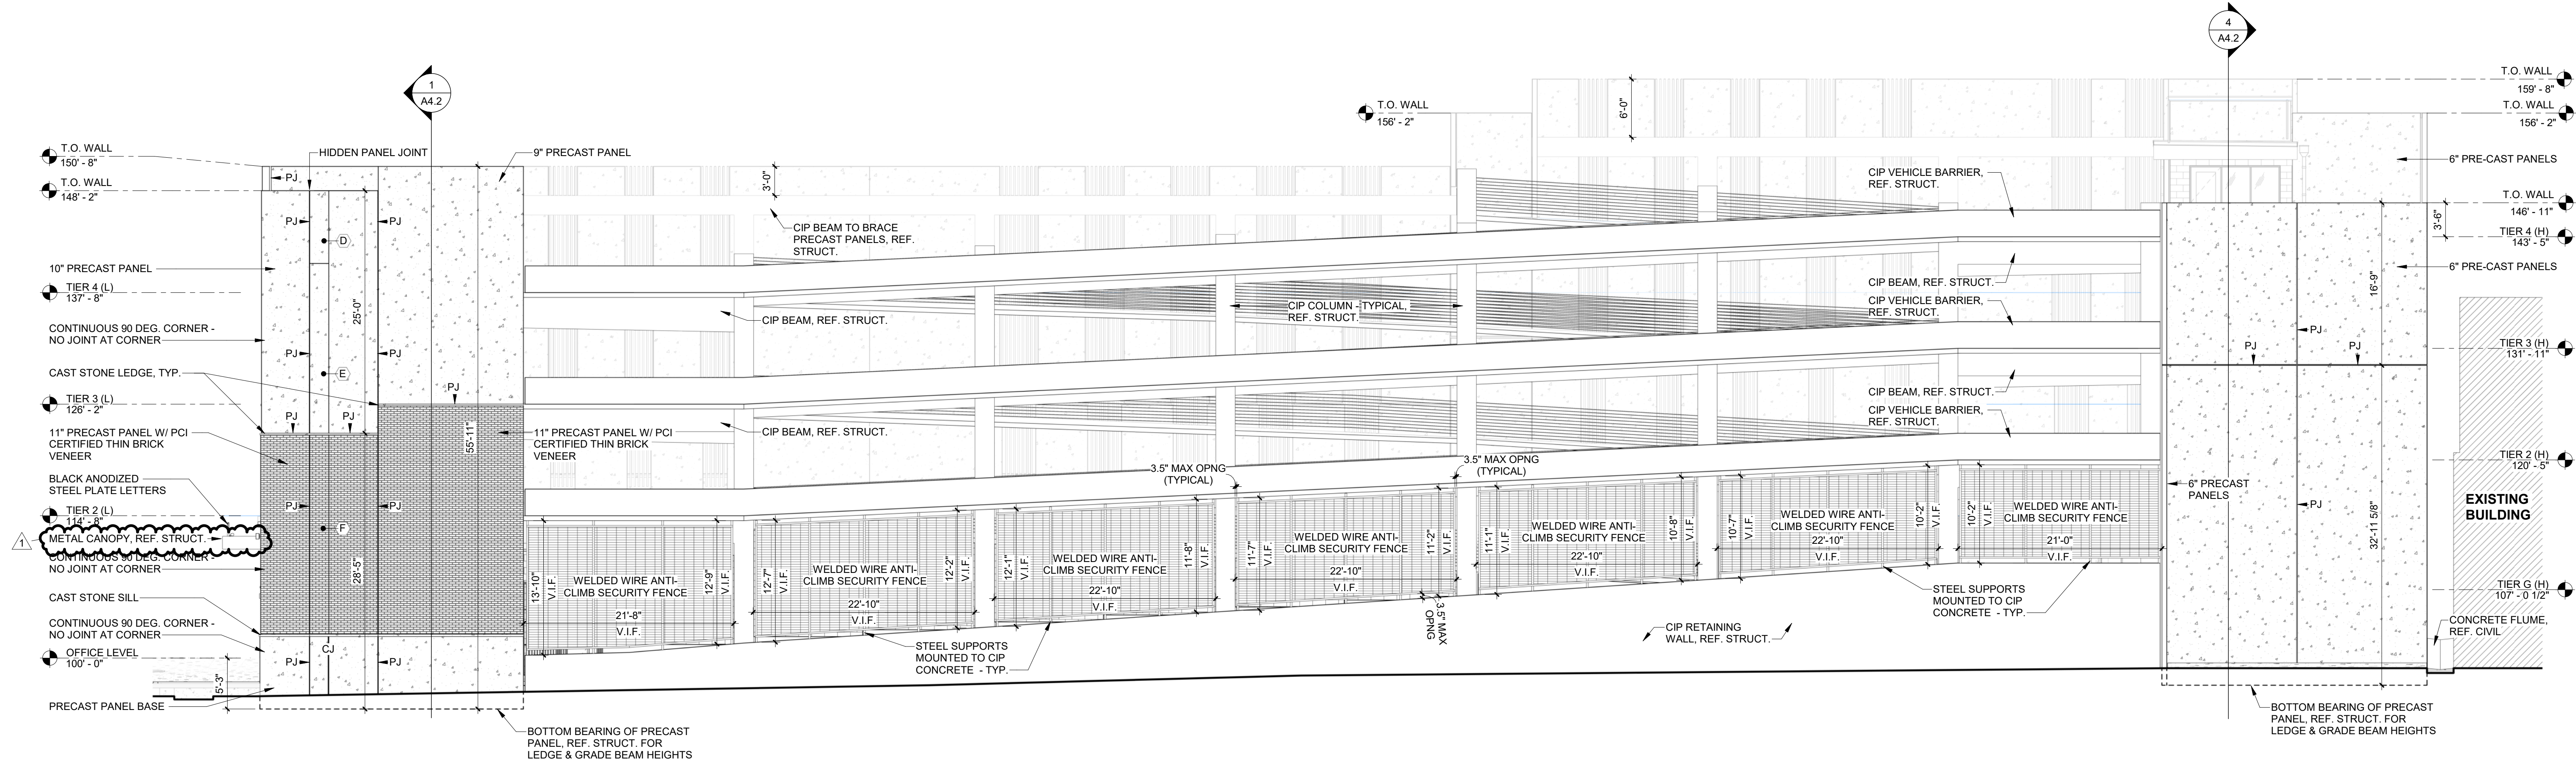

SOUTH ELEVATION | 1
 SCALE: 1/8" = 1'-0" A3.2

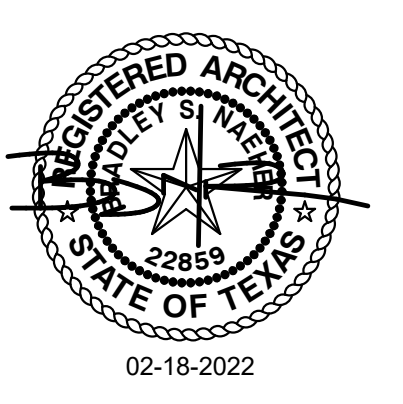

02-18-2022
 PROJECT NO.: 20011
 DATE: 03/03/2022

REVISION SCHEDULE	
A. Description	Date
1. ADDENDUM 04	03-17-2022

SHEET NAME


EXTERIOR ELEVATIONS

SHEET NO.


A3.2



LEVEL 4 GRAPHIC | 18
SCALE: 1/4" = 1'-0" A3.3

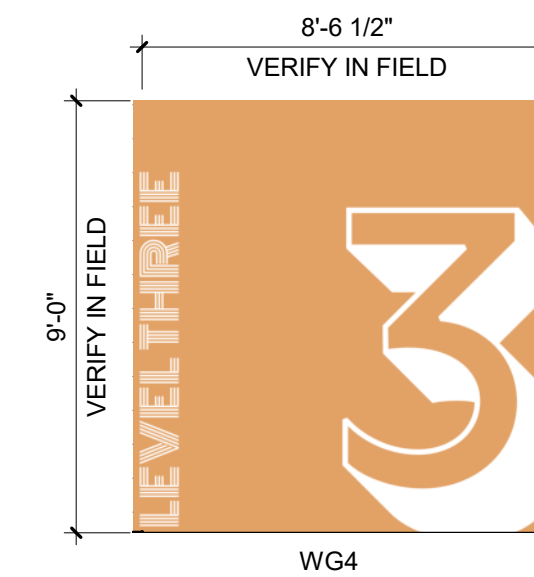


LEVEL 3 GRAPHIC | 17
SCALE: 1/4" = 1'-0" A3.3

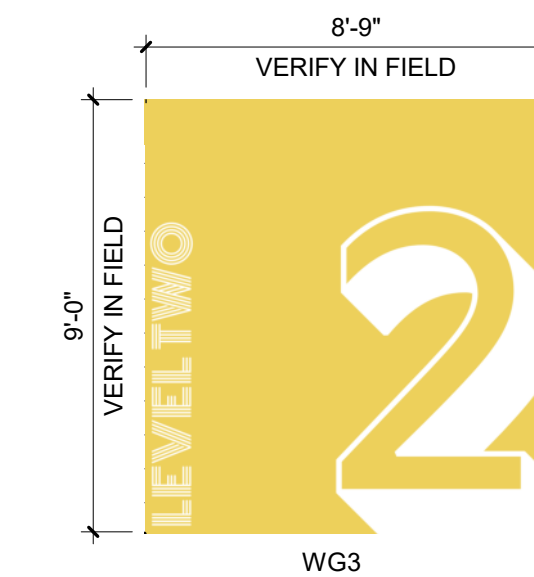


LEVEL 2 GRAPHIC | 16
SCALE: 1/4" = 1'-0" A3.3




GROUND FLOOR GRAPHIC | 15
SCALE: 1/4" = 1'-0" A3.3

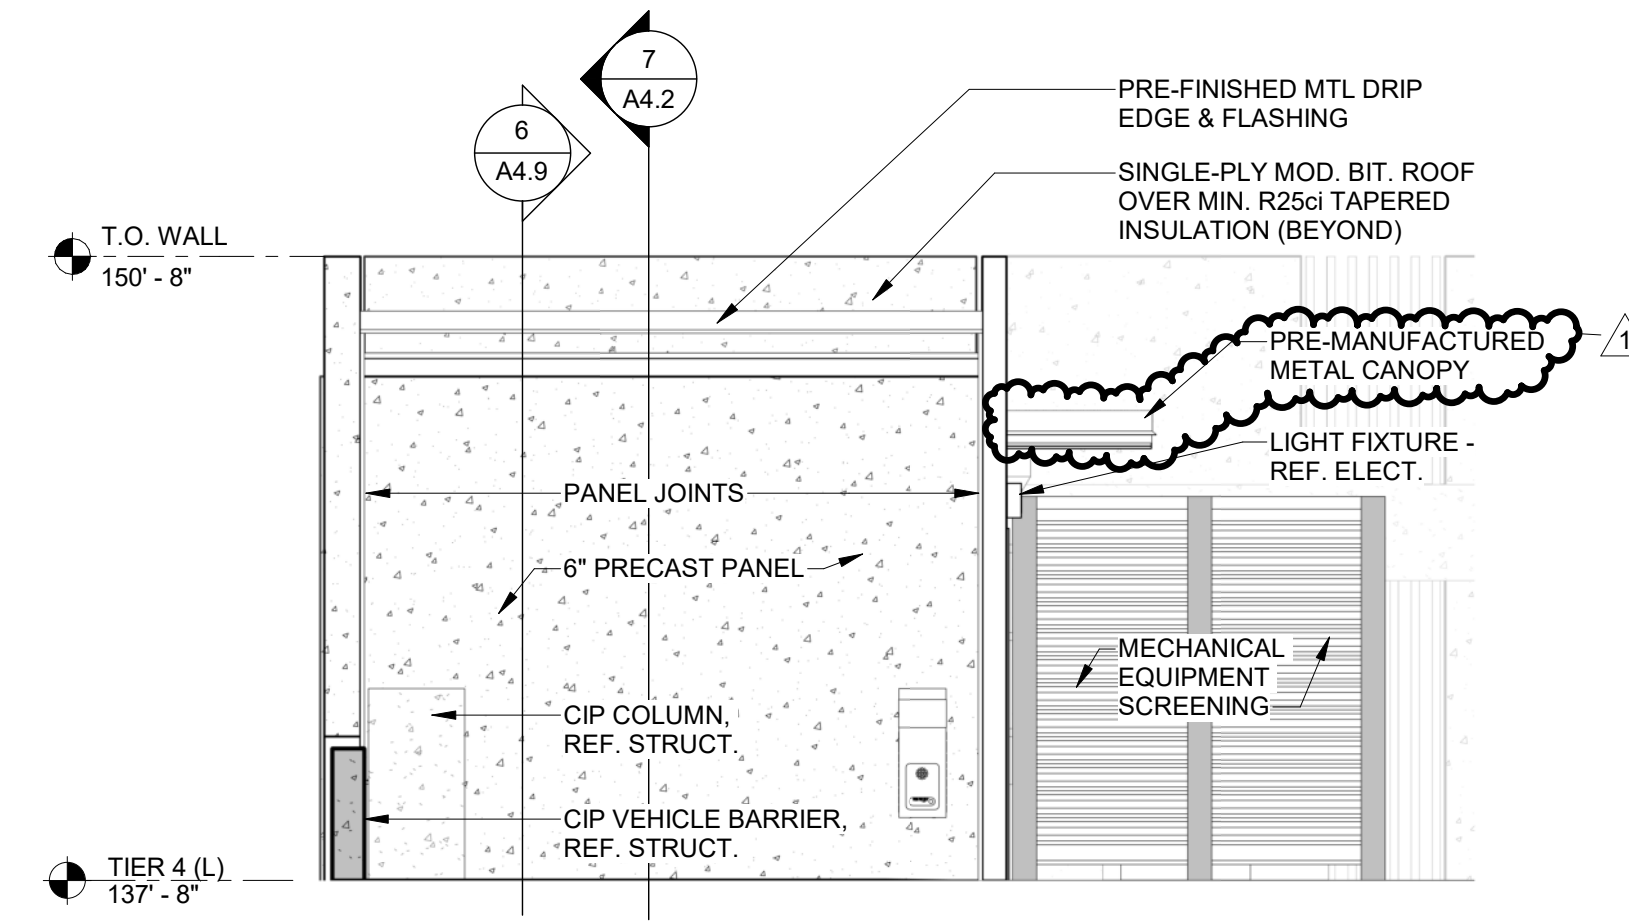


PARTIAL BUILDING SECTION | 14
SCALE: 1/4" = 1'-0" A3.3

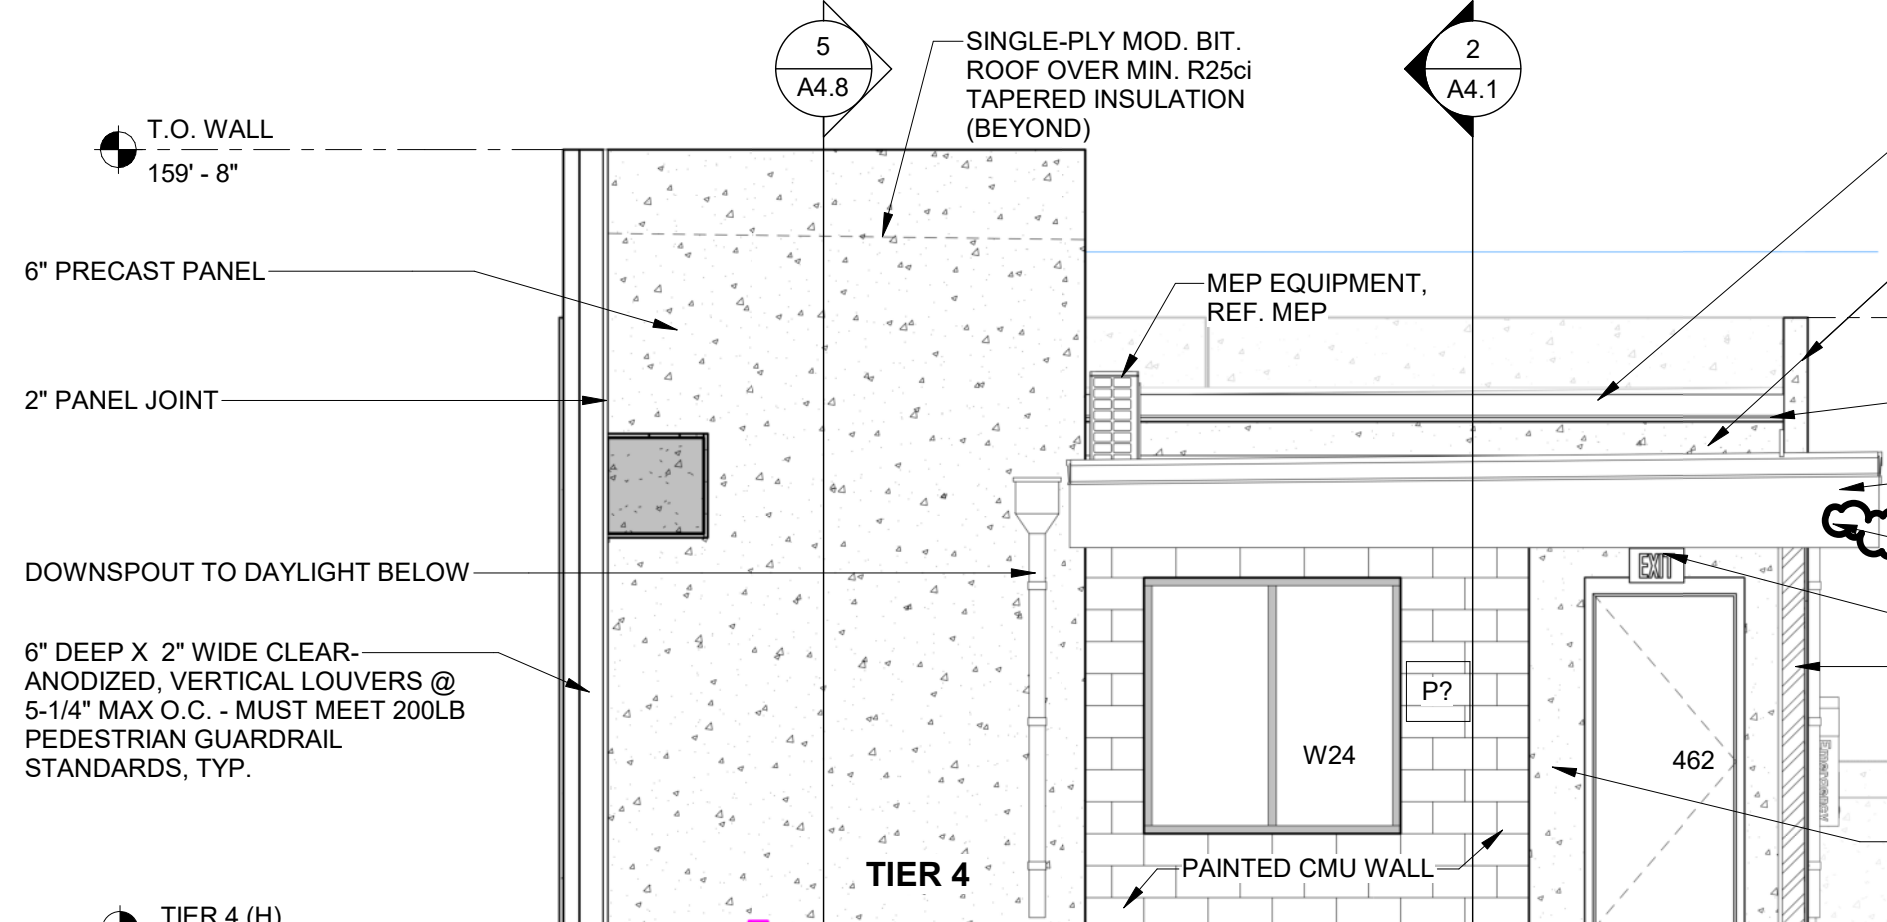


PARTIAL BUILDING SECTION | 8
SCALE: 1/4" = 1'-0" A3.3

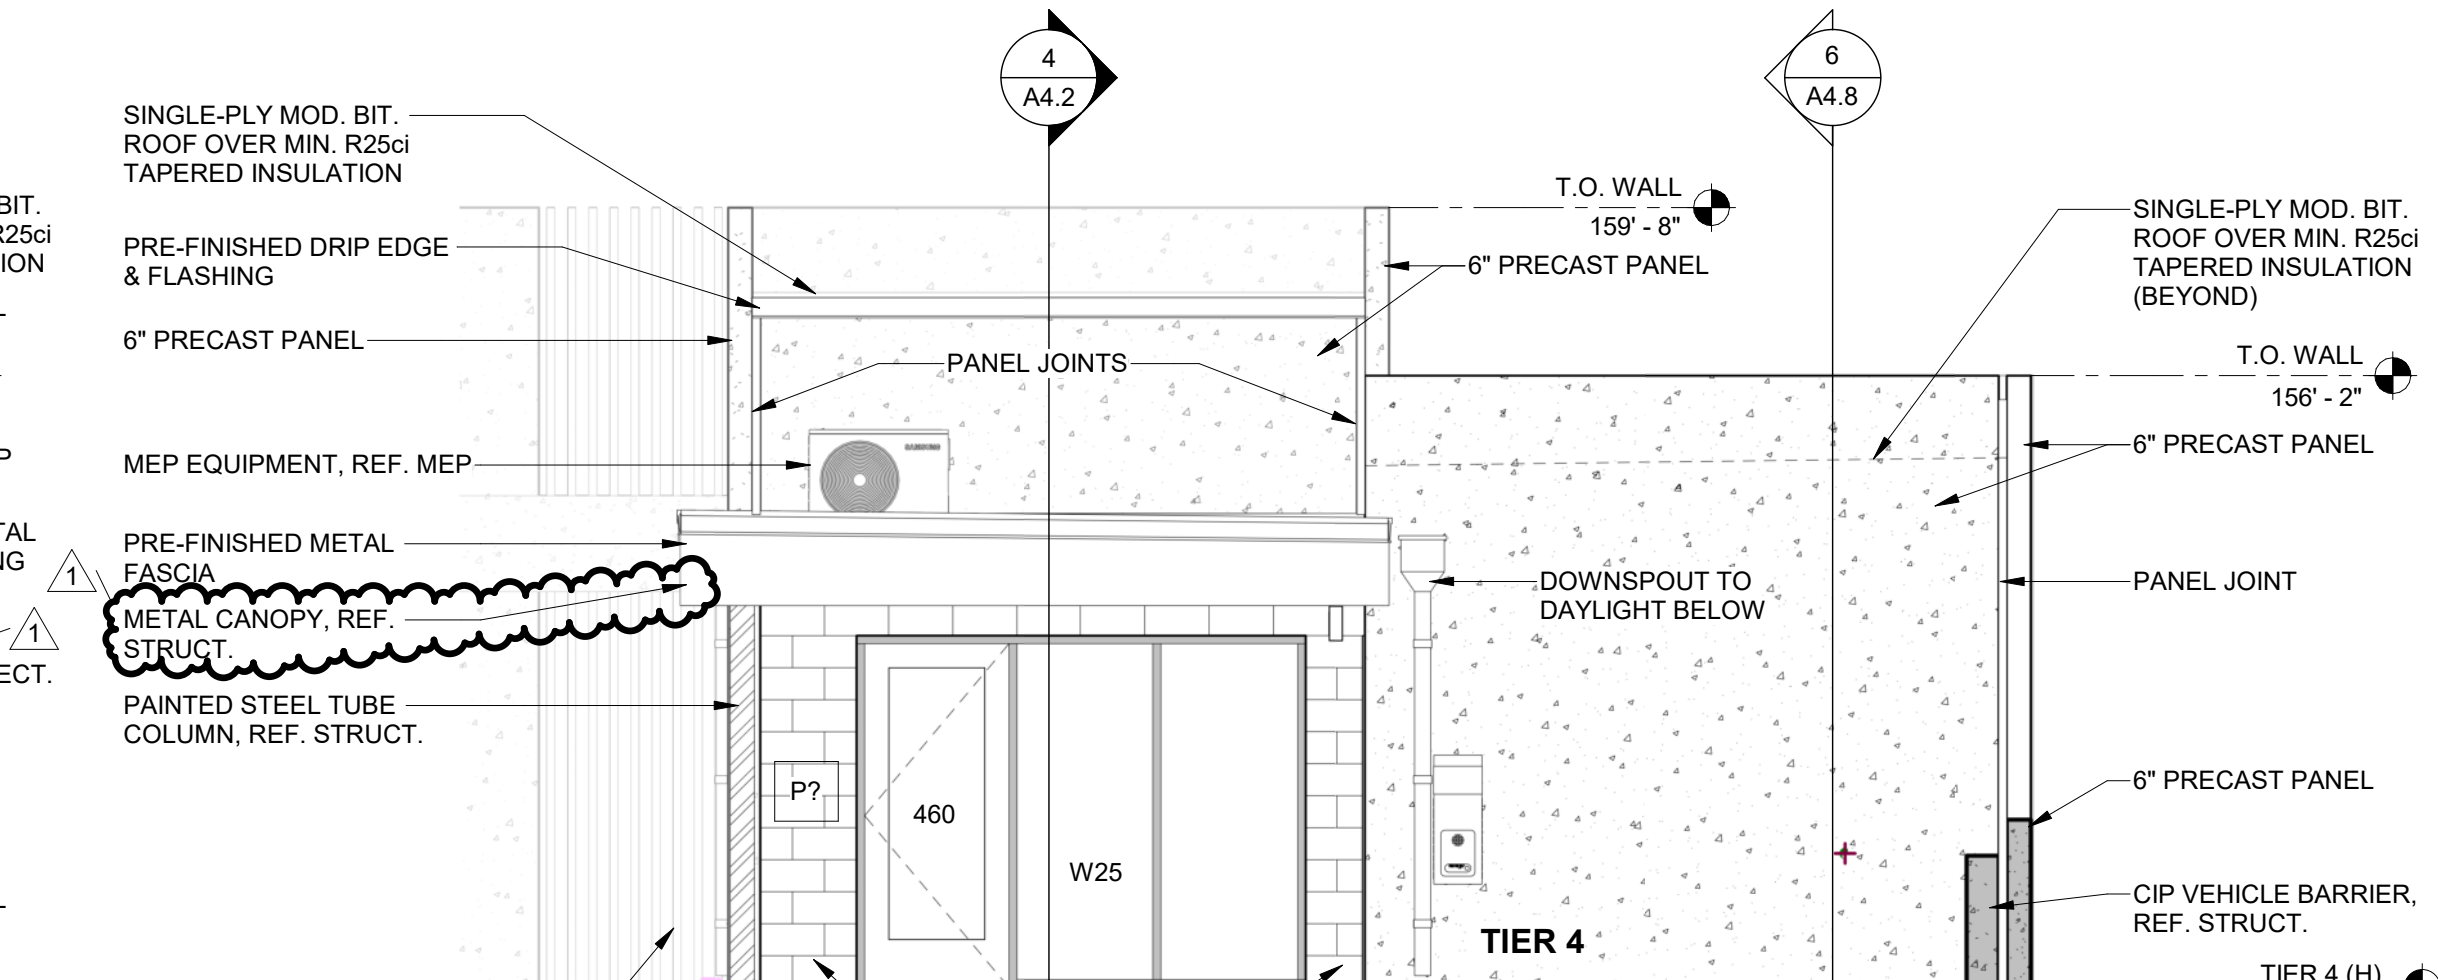


PARTIAL BUILDING SECTION | 4
SCALE: 1/4" = 1'-0" A3.3

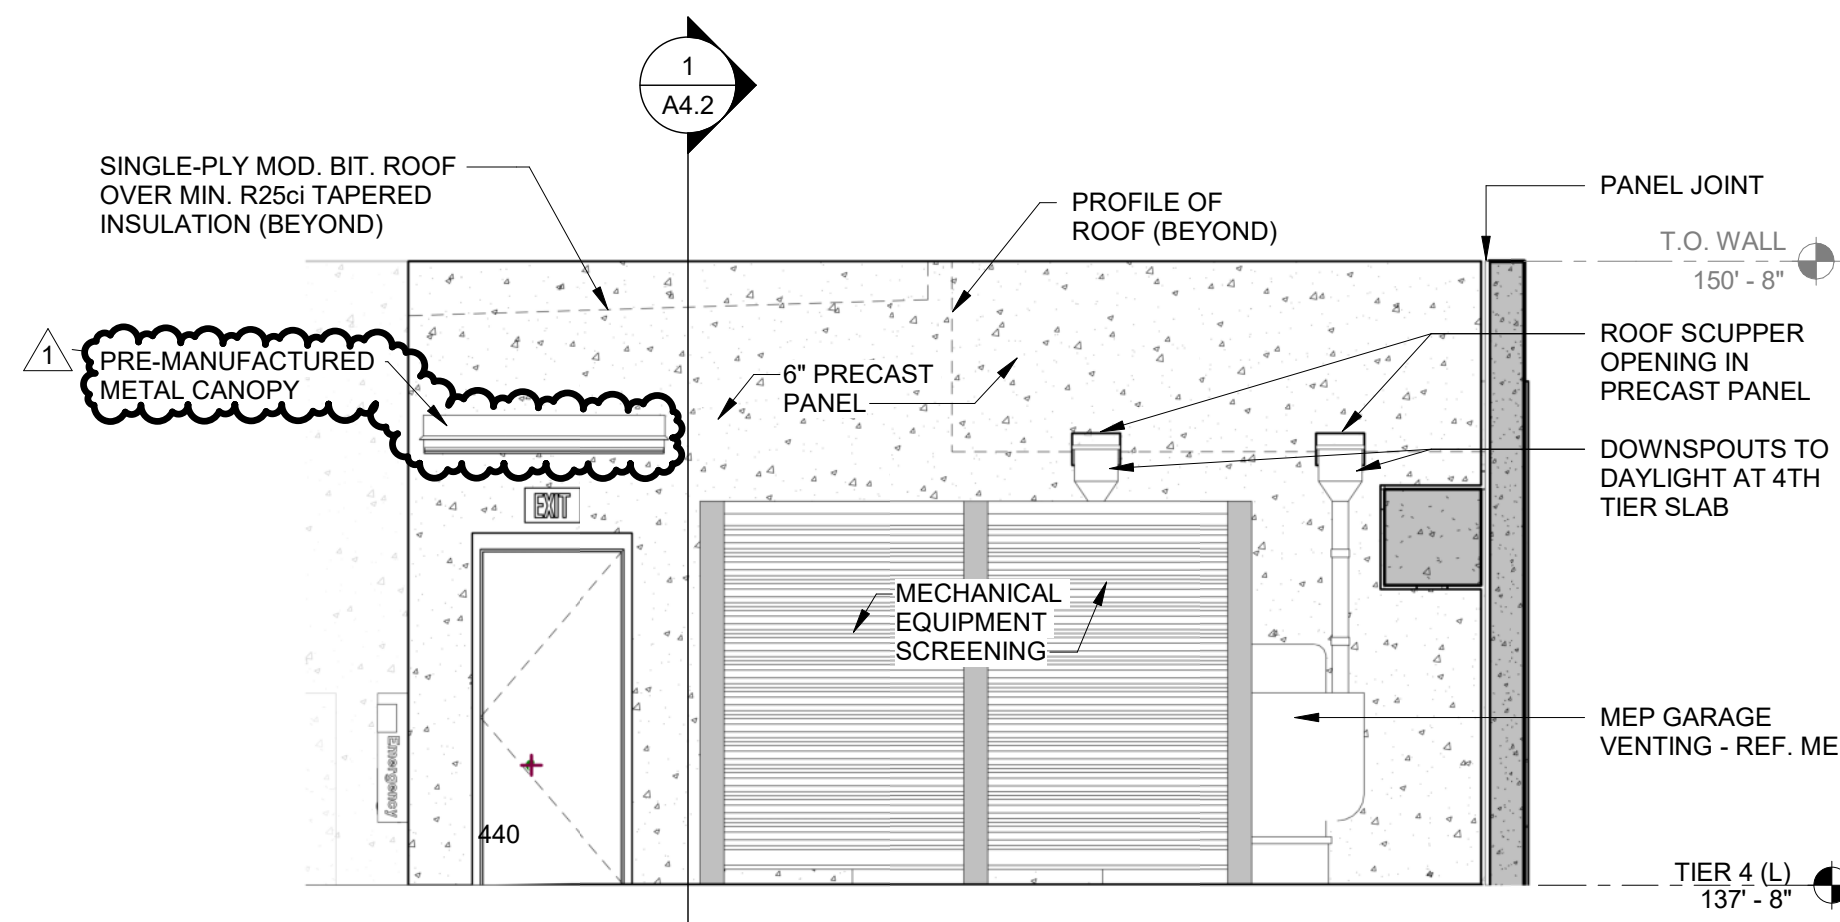


PARTIAL BUILDING SECTION | 13
SCALE: 1/4" = 1'-0" A3.3

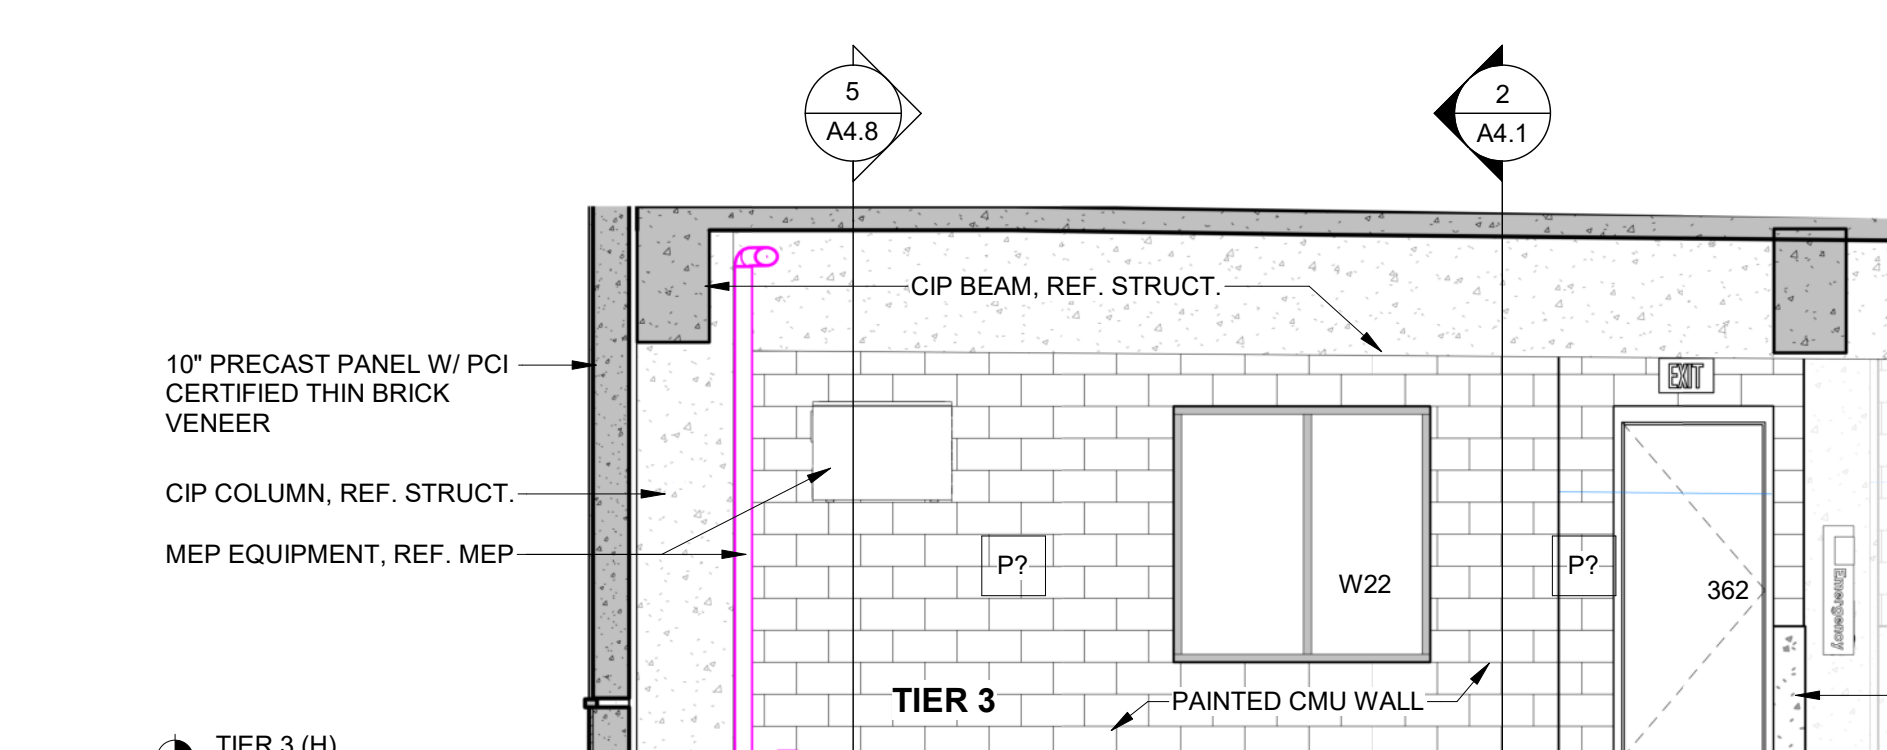

PARTIAL BUILDING SECTION | 7
SCALE: 1/4" = 1'-0" A3.3

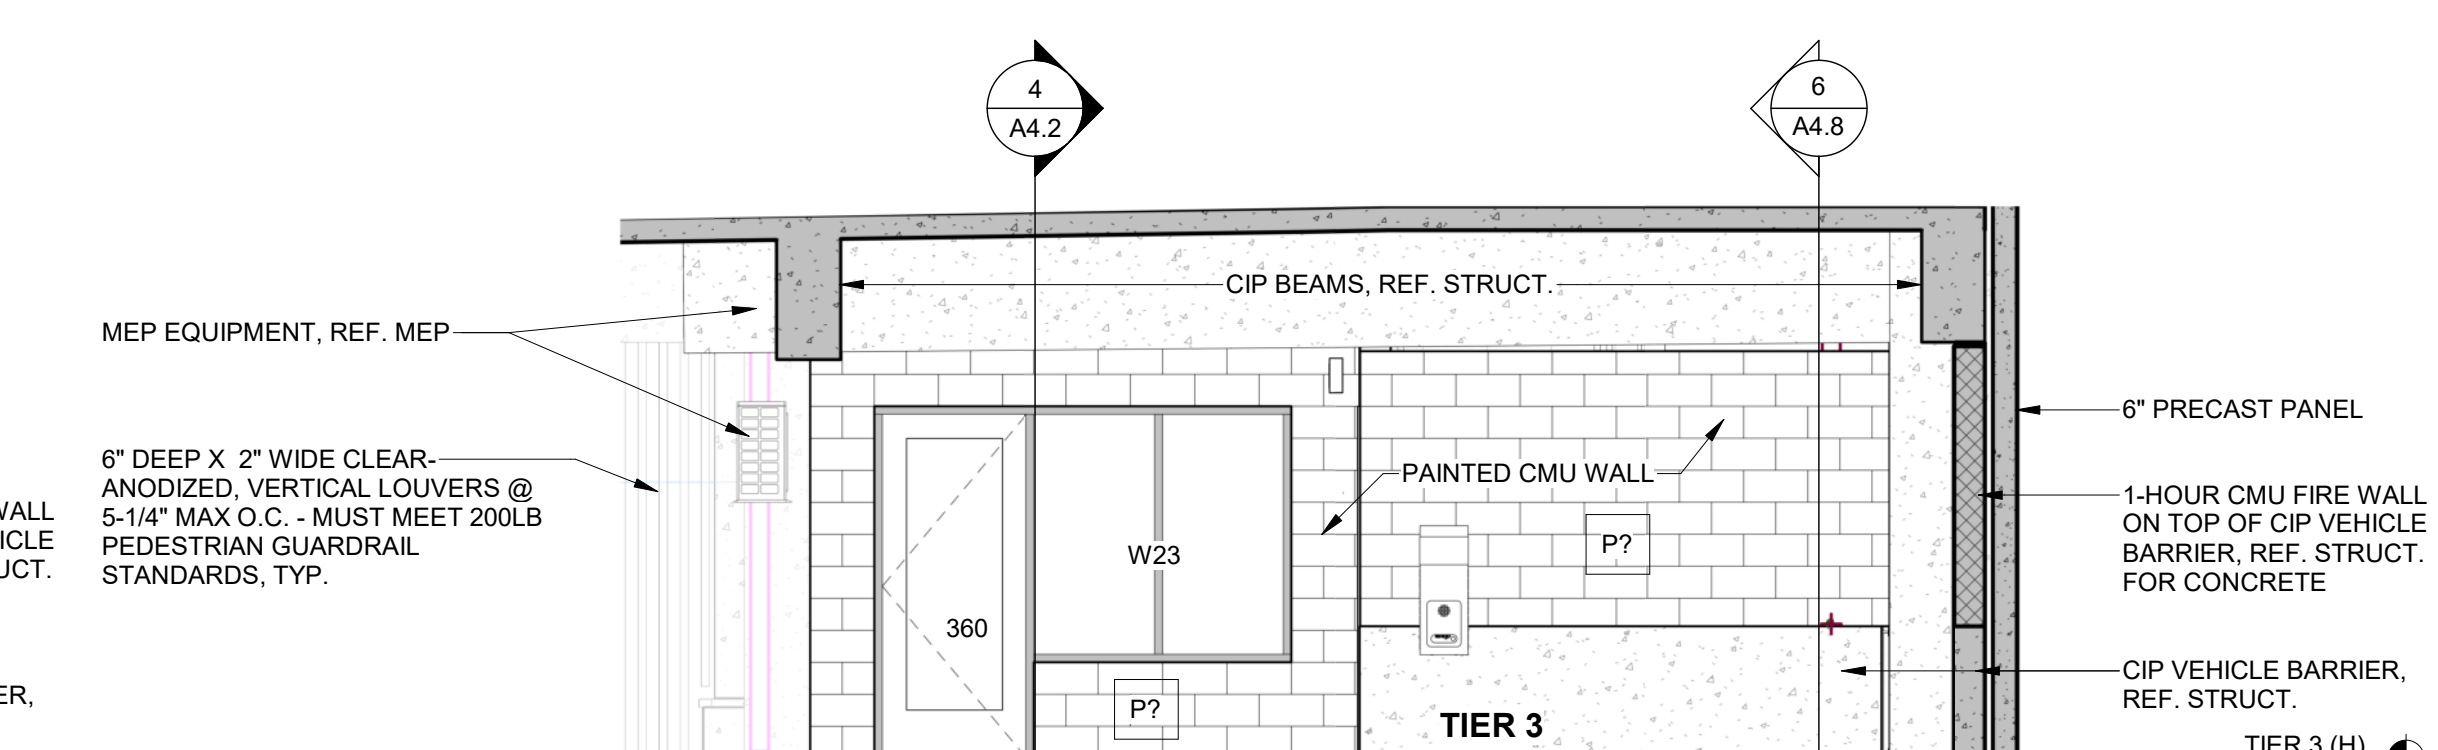


PARTIAL BUILDING SECTION | 3
SCALE: 1/4" = 1'-0" A3.3

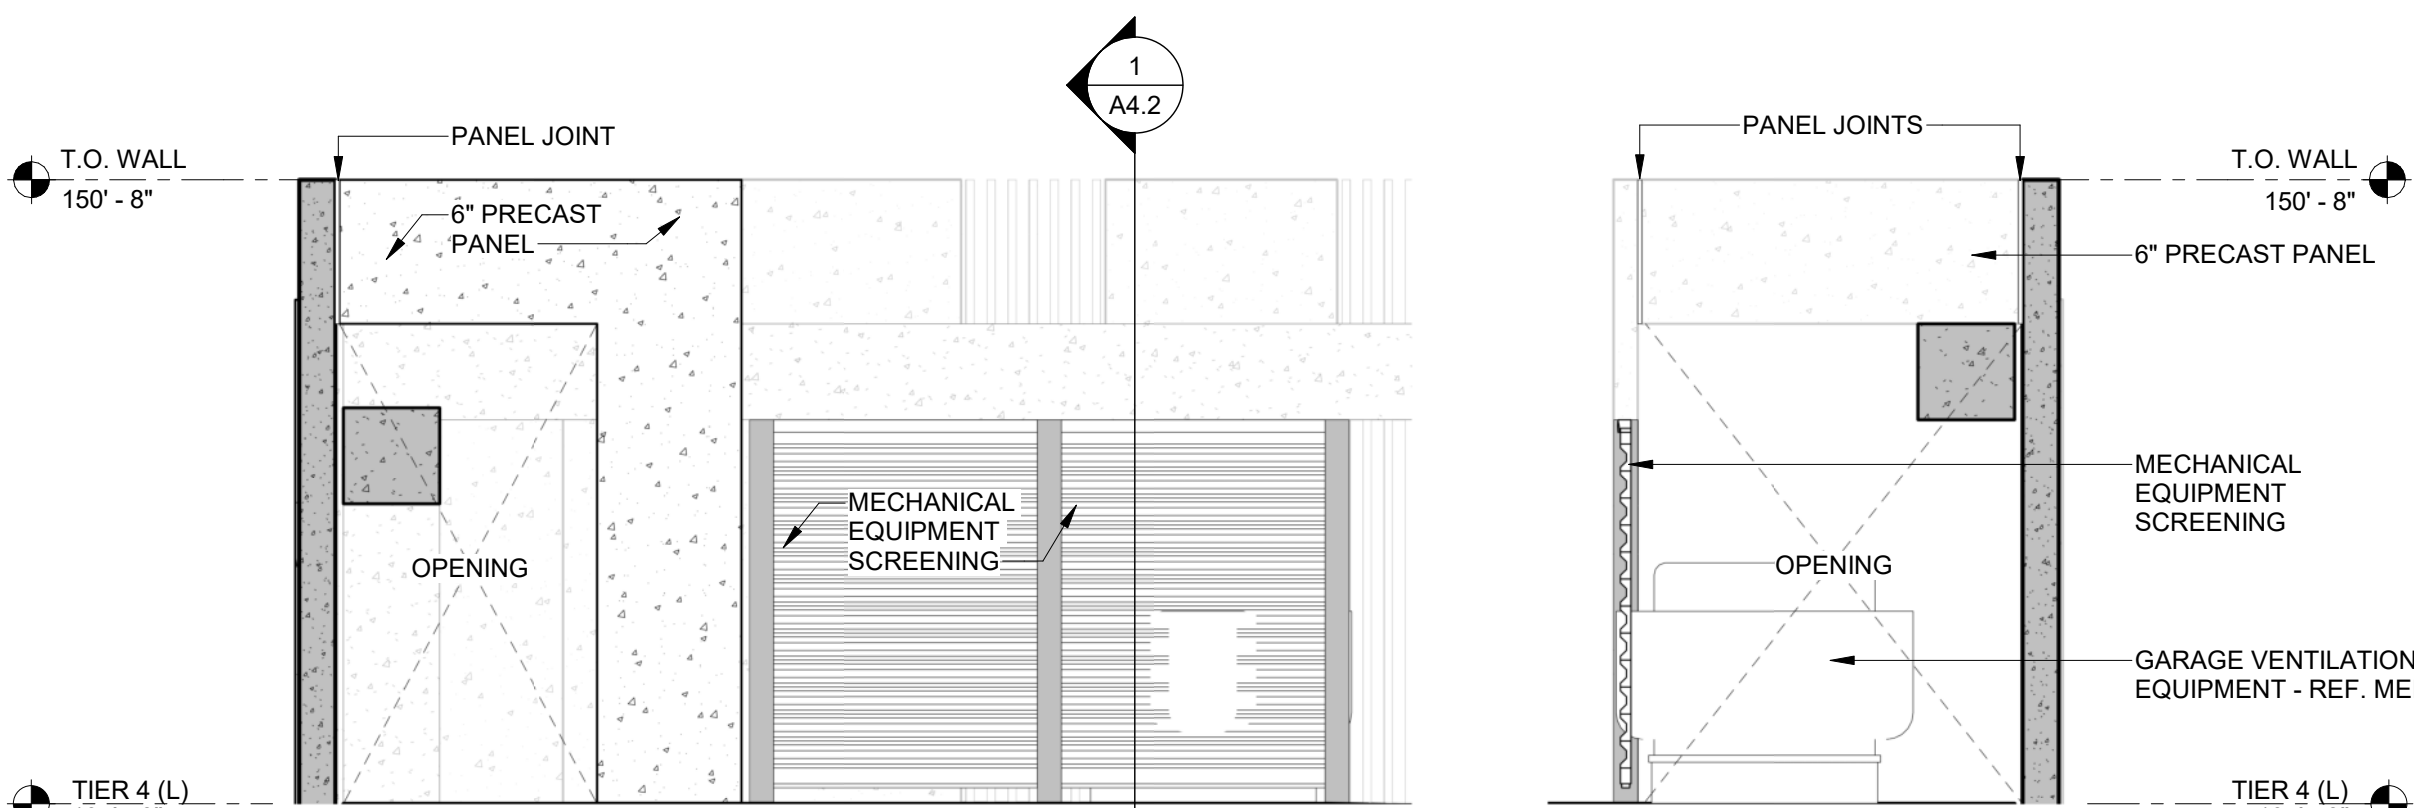


PARTIAL BUILDING SECTION | 12
SCALE: 1/4" = 1'-0" A3.3


PARTIAL BUILDING SECTION | 10
SCALE: 1/4" = 1'-0" A3.3

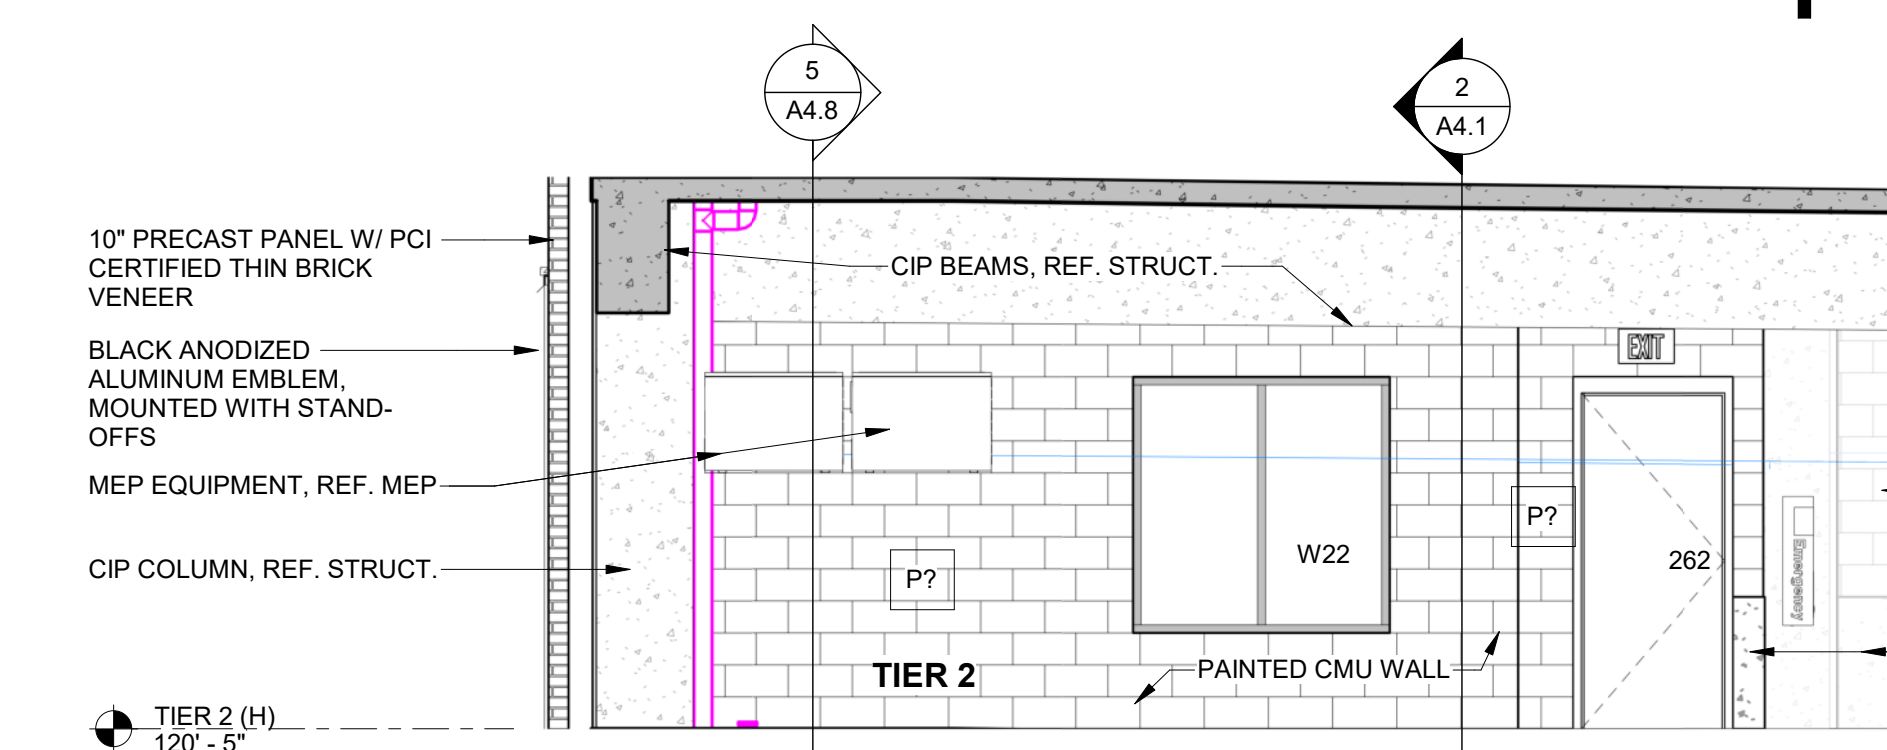

PARTIAL BUILDING SECTION | 6
SCALE: 1/4" = 1'-0" A3.3

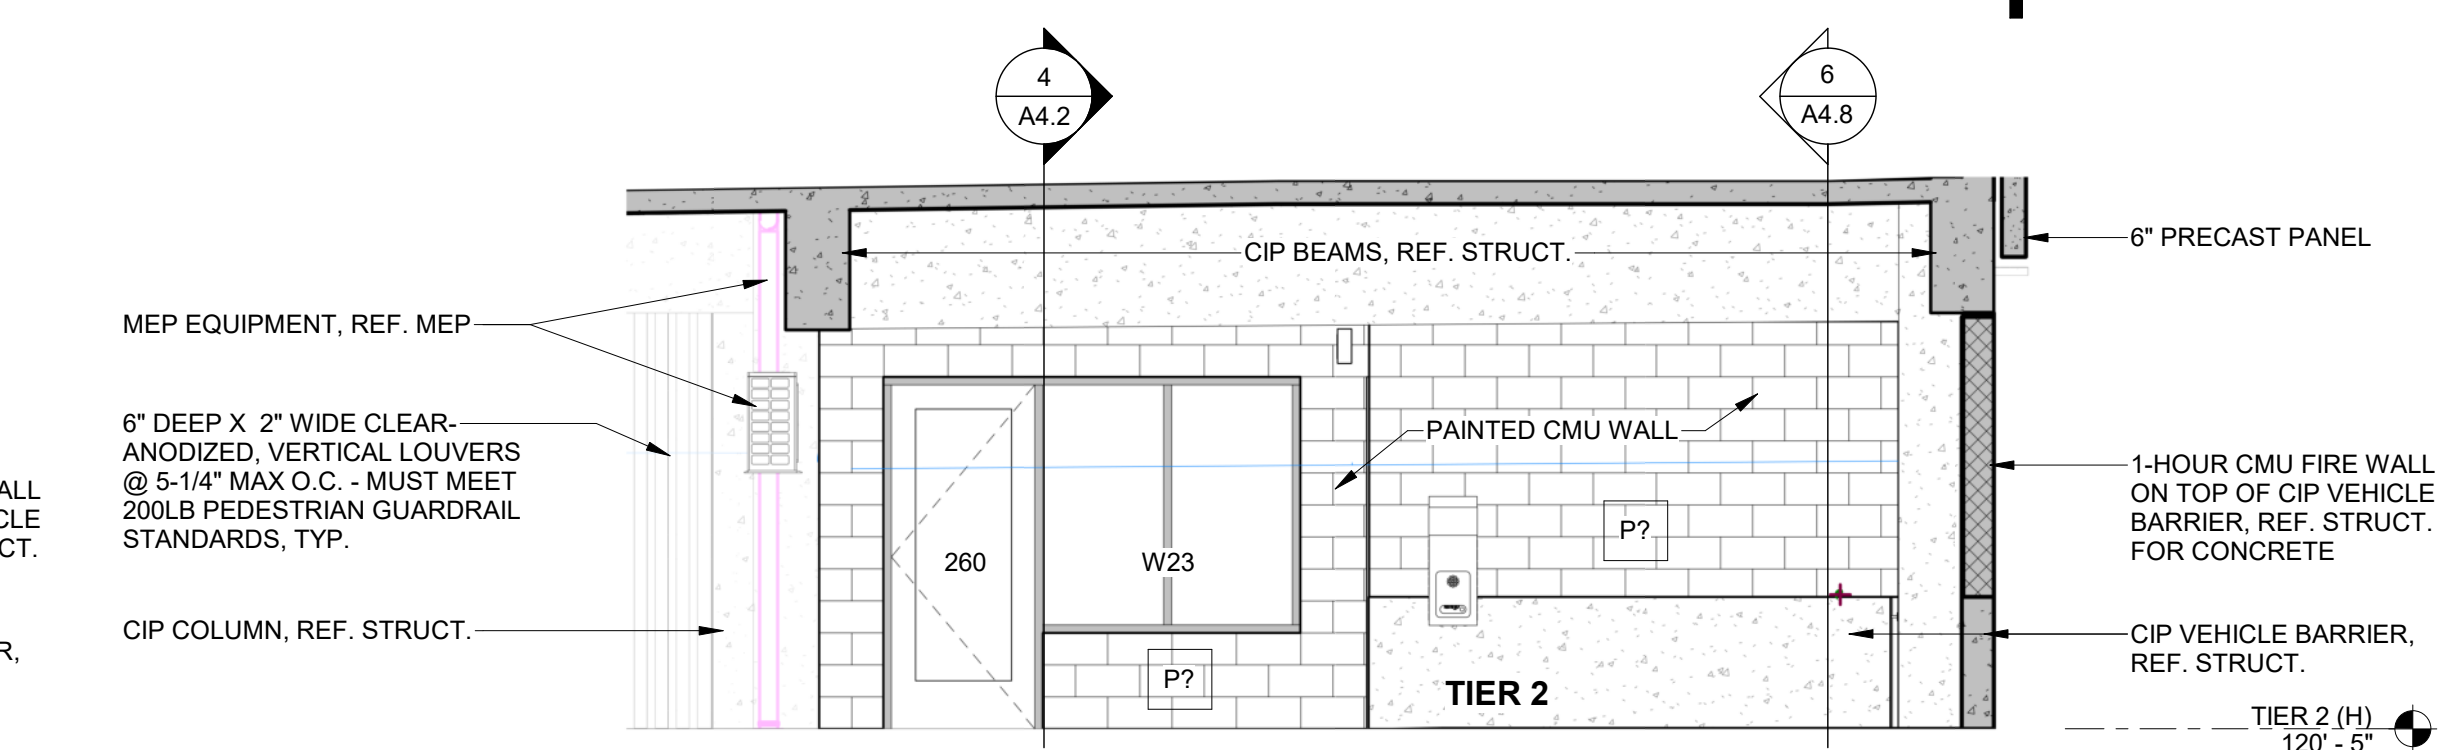


PARTIAL BUILDING SECTION | 2
SCALE: 1/4" = 1'-0" A3.3

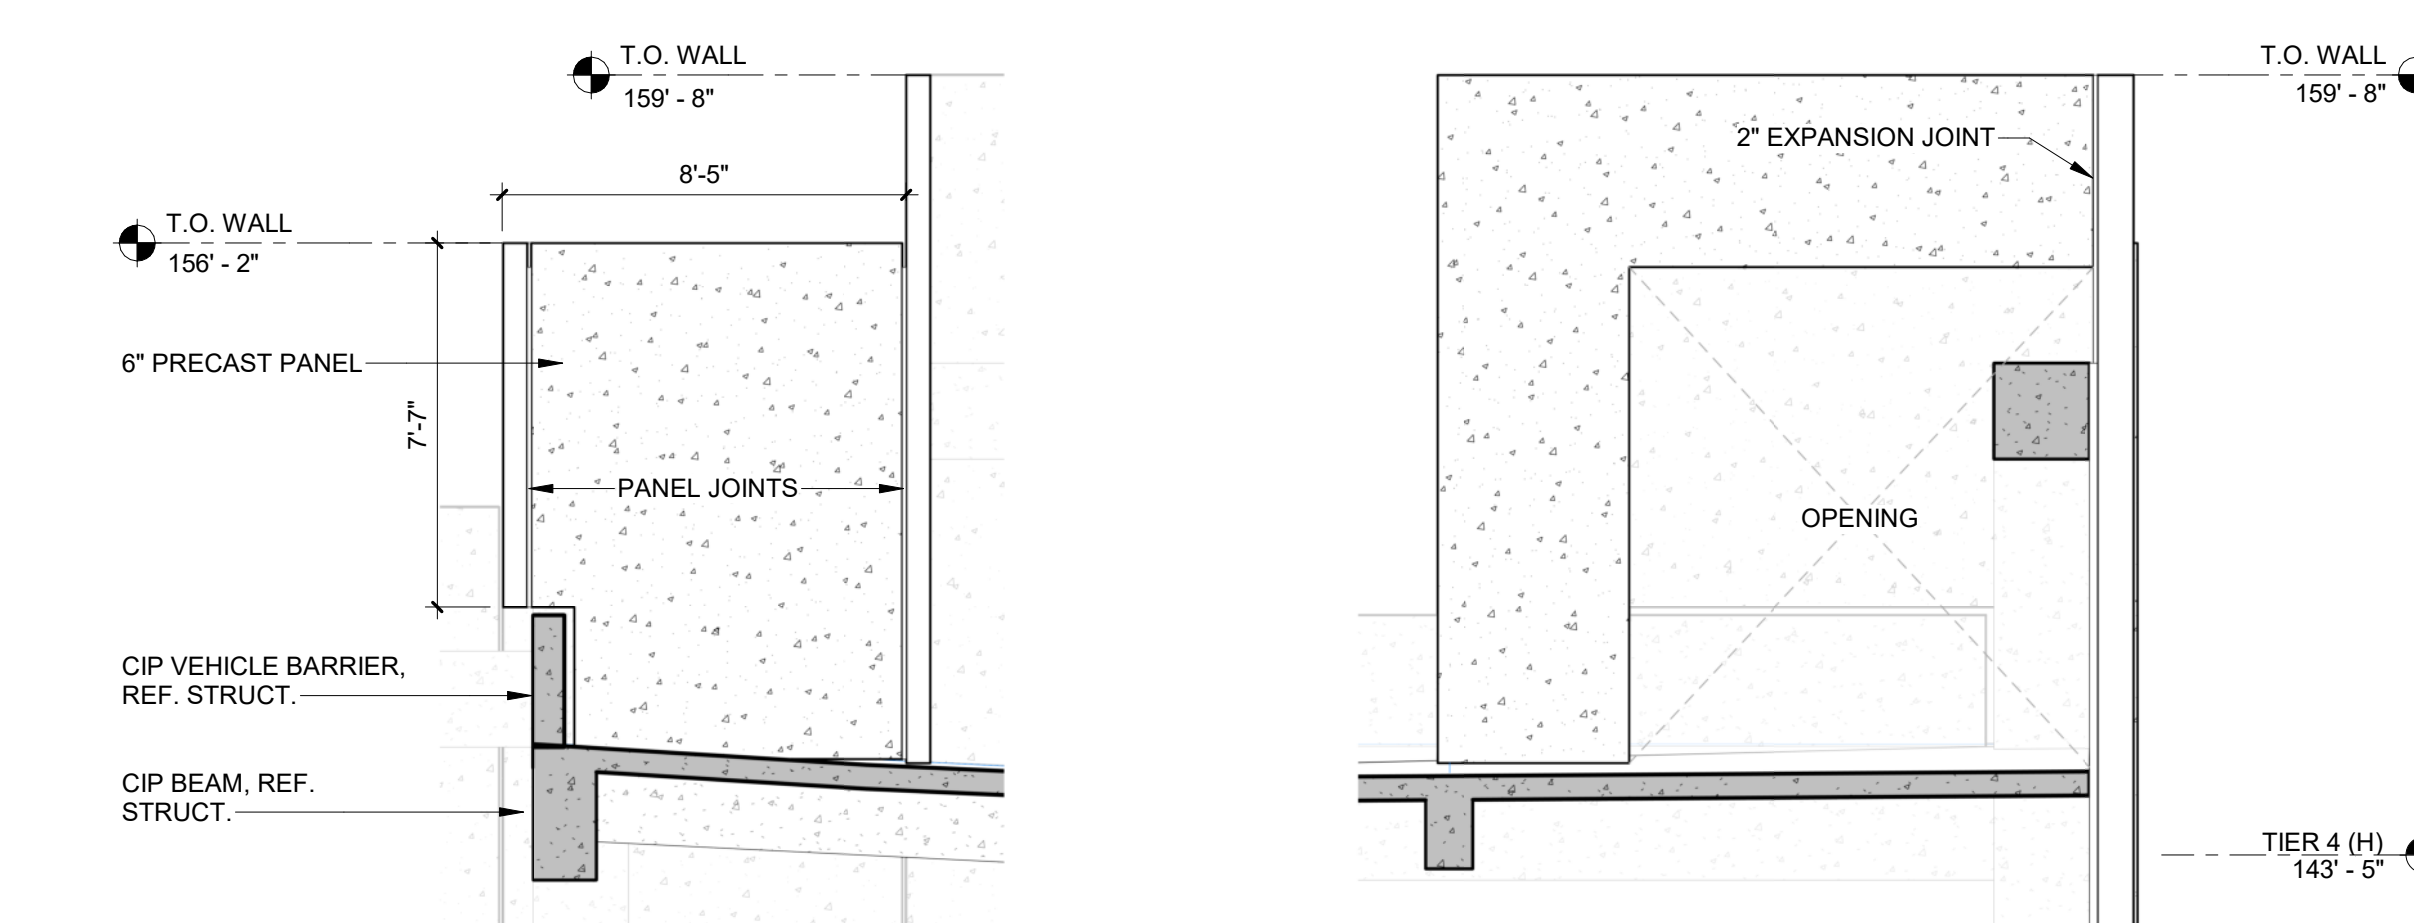


PARTIAL BUILDING SECTION | 11
SCALE: 1/4" = 1'-0" A3.3

PARTIAL BUILDING SECTION | 9
SCALE: 1/4" = 1'-0" A3.3

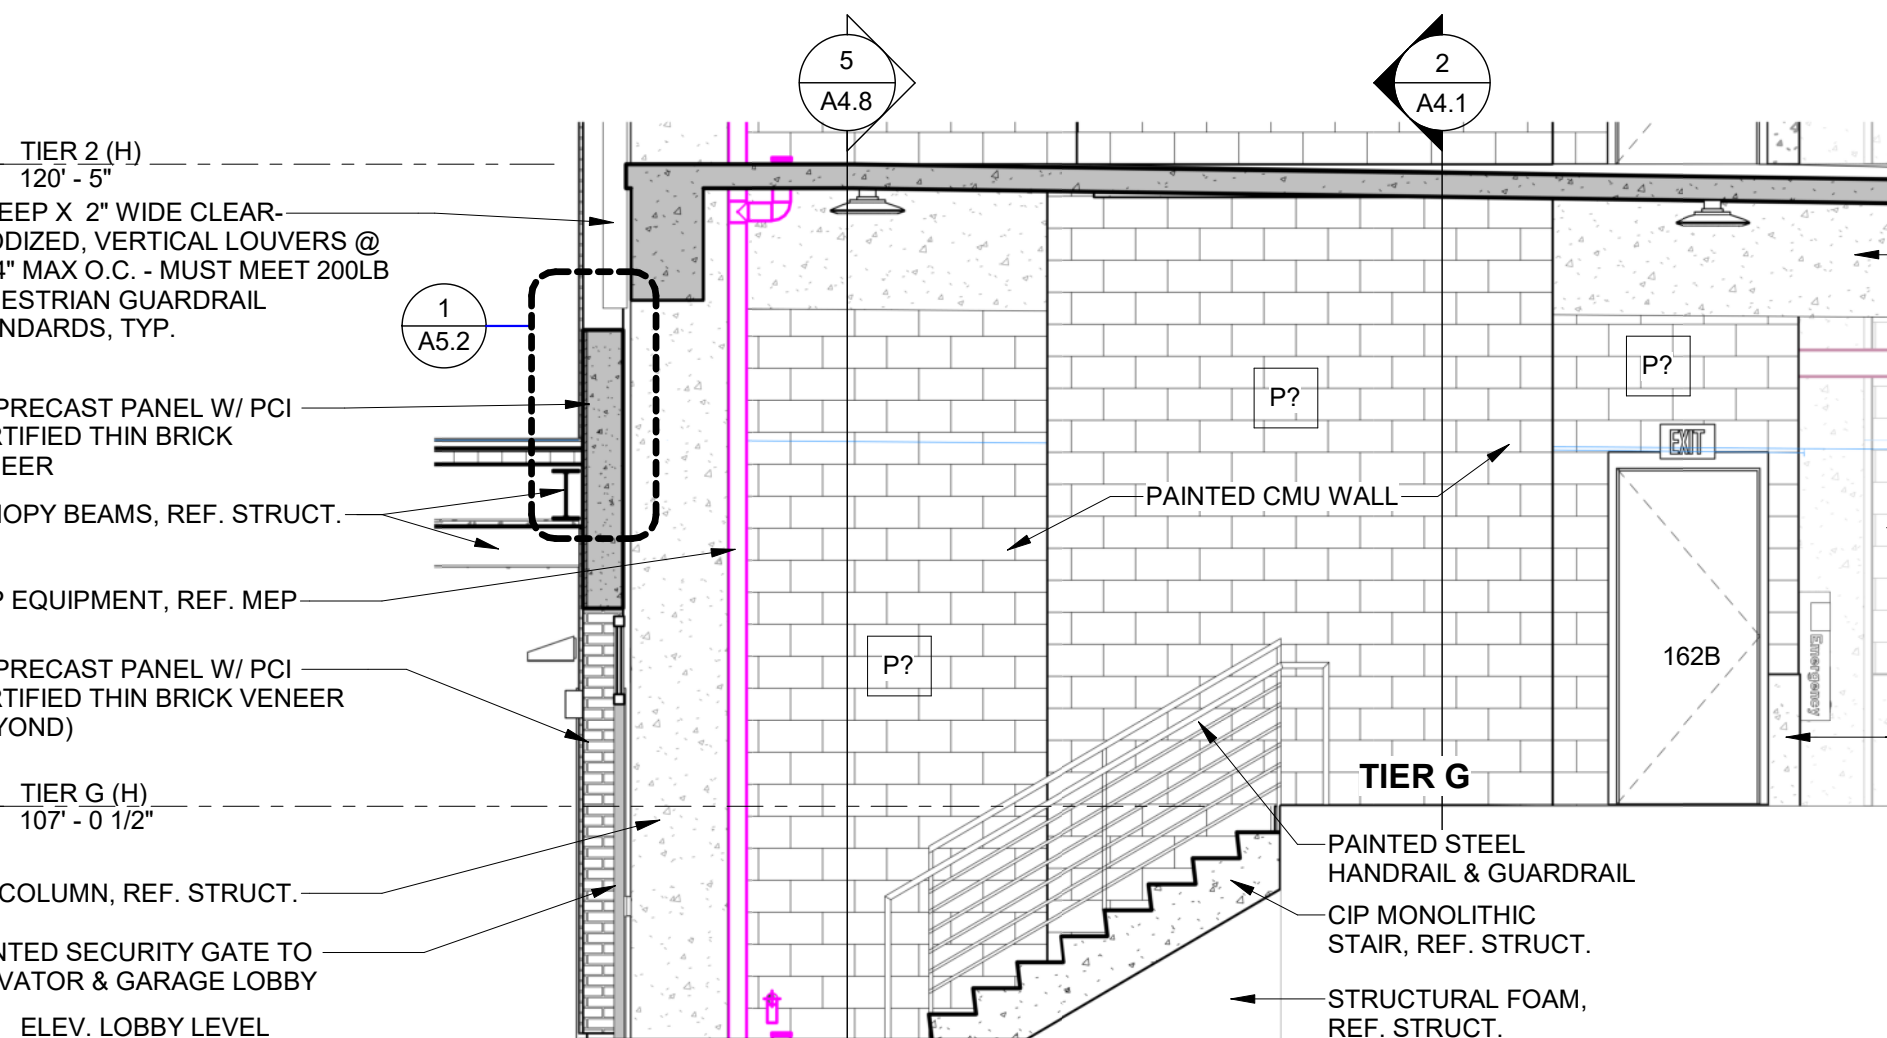

PARTIAL BUILDING SECTION | 5
SCALE: 1/4" = 1'-0" A3.3

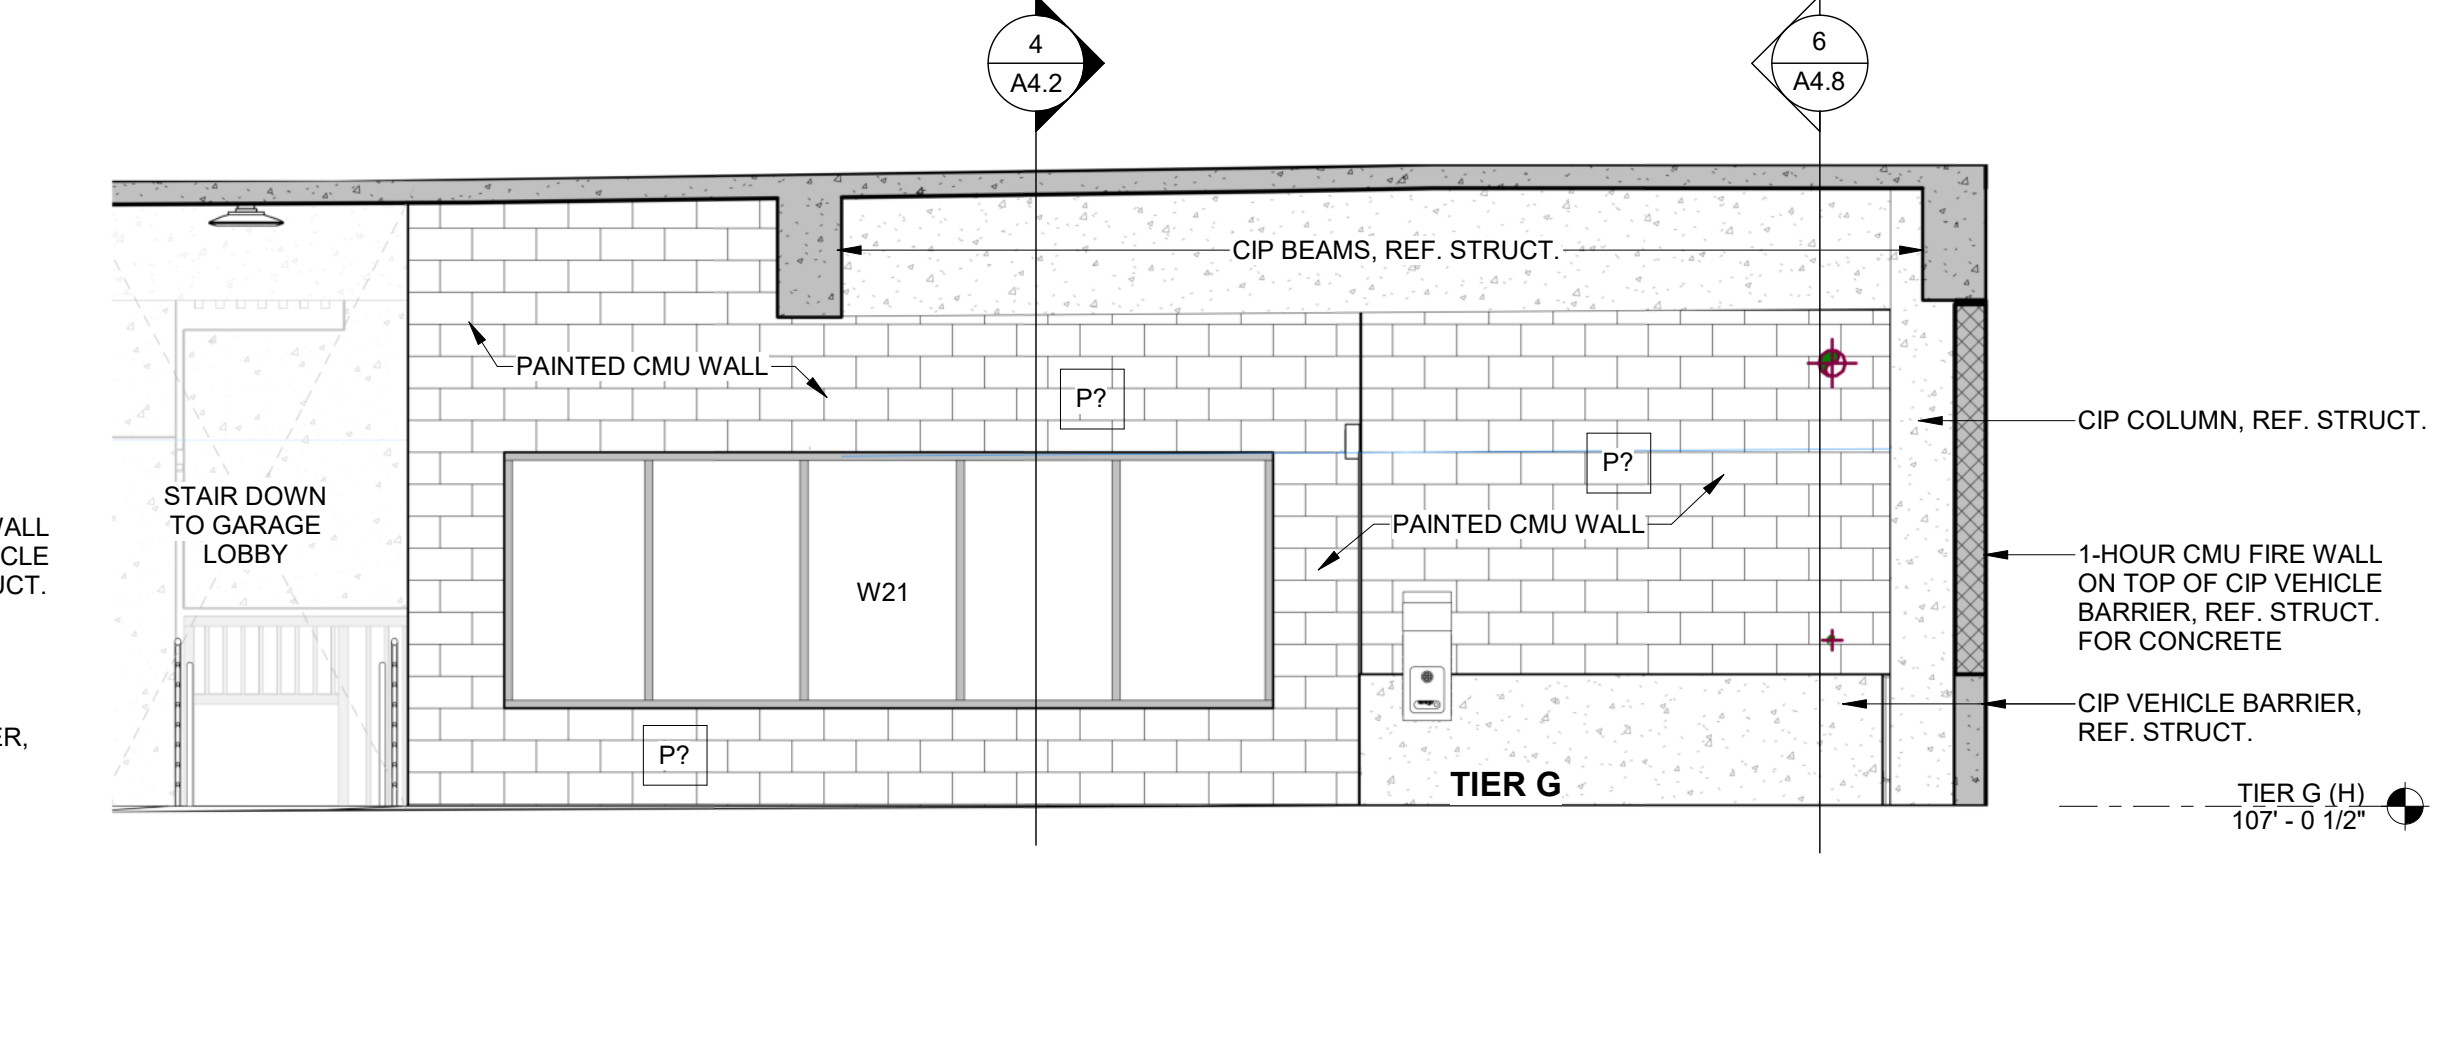


PARTIAL BUILDING SECTION | 1
SCALE: 1/4" = 1'-0" A3.3

A NEW FACILITY FOR
GREGG COUNTY - PARKING GARAGE & OFFICE
 100 E. METHUEN ST.
 LONGVIEW, TX 75601



PROJECT NO.: 20011
 DATE: 03/03/2022

REVISION SCHEDULE	
Δ Description	Date
1. ADDENDUM 04	03-17-2022

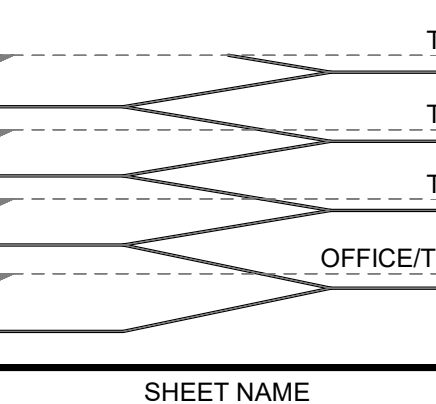

SHEET NAME
PARTIAL BUILDING SECTIONS

SHEET NO.
A3.3





PROJECT NO.: 20011
 DATE: 03/03/2022

REVISION SCHEDULE	
A	Date
1	03-17-2022
1	ADDENDUM 04


BUILDING SECTIONS

SHEET NO.


A4.2

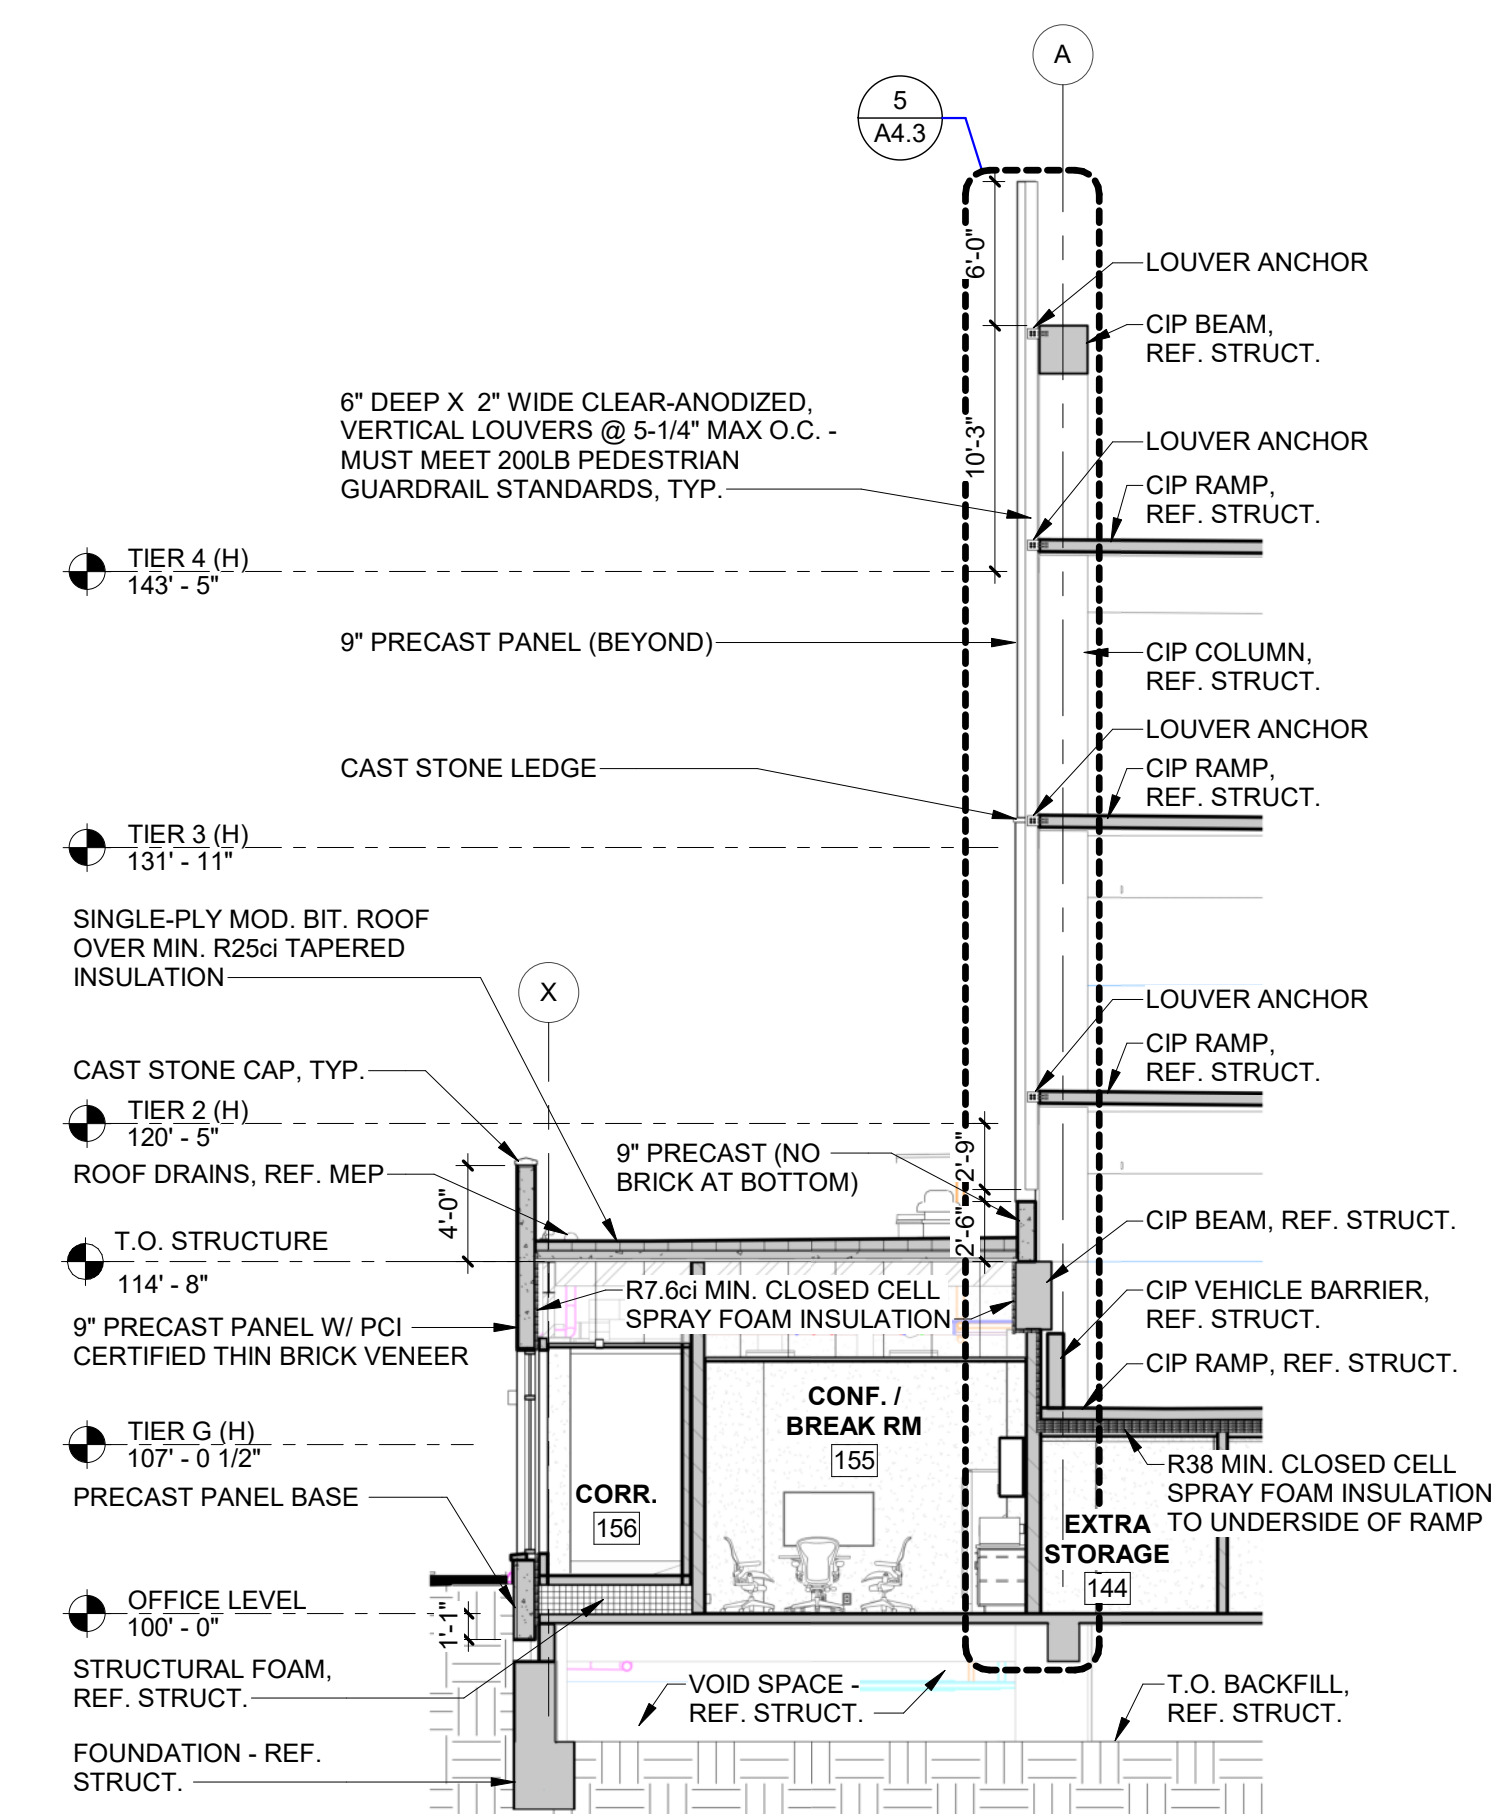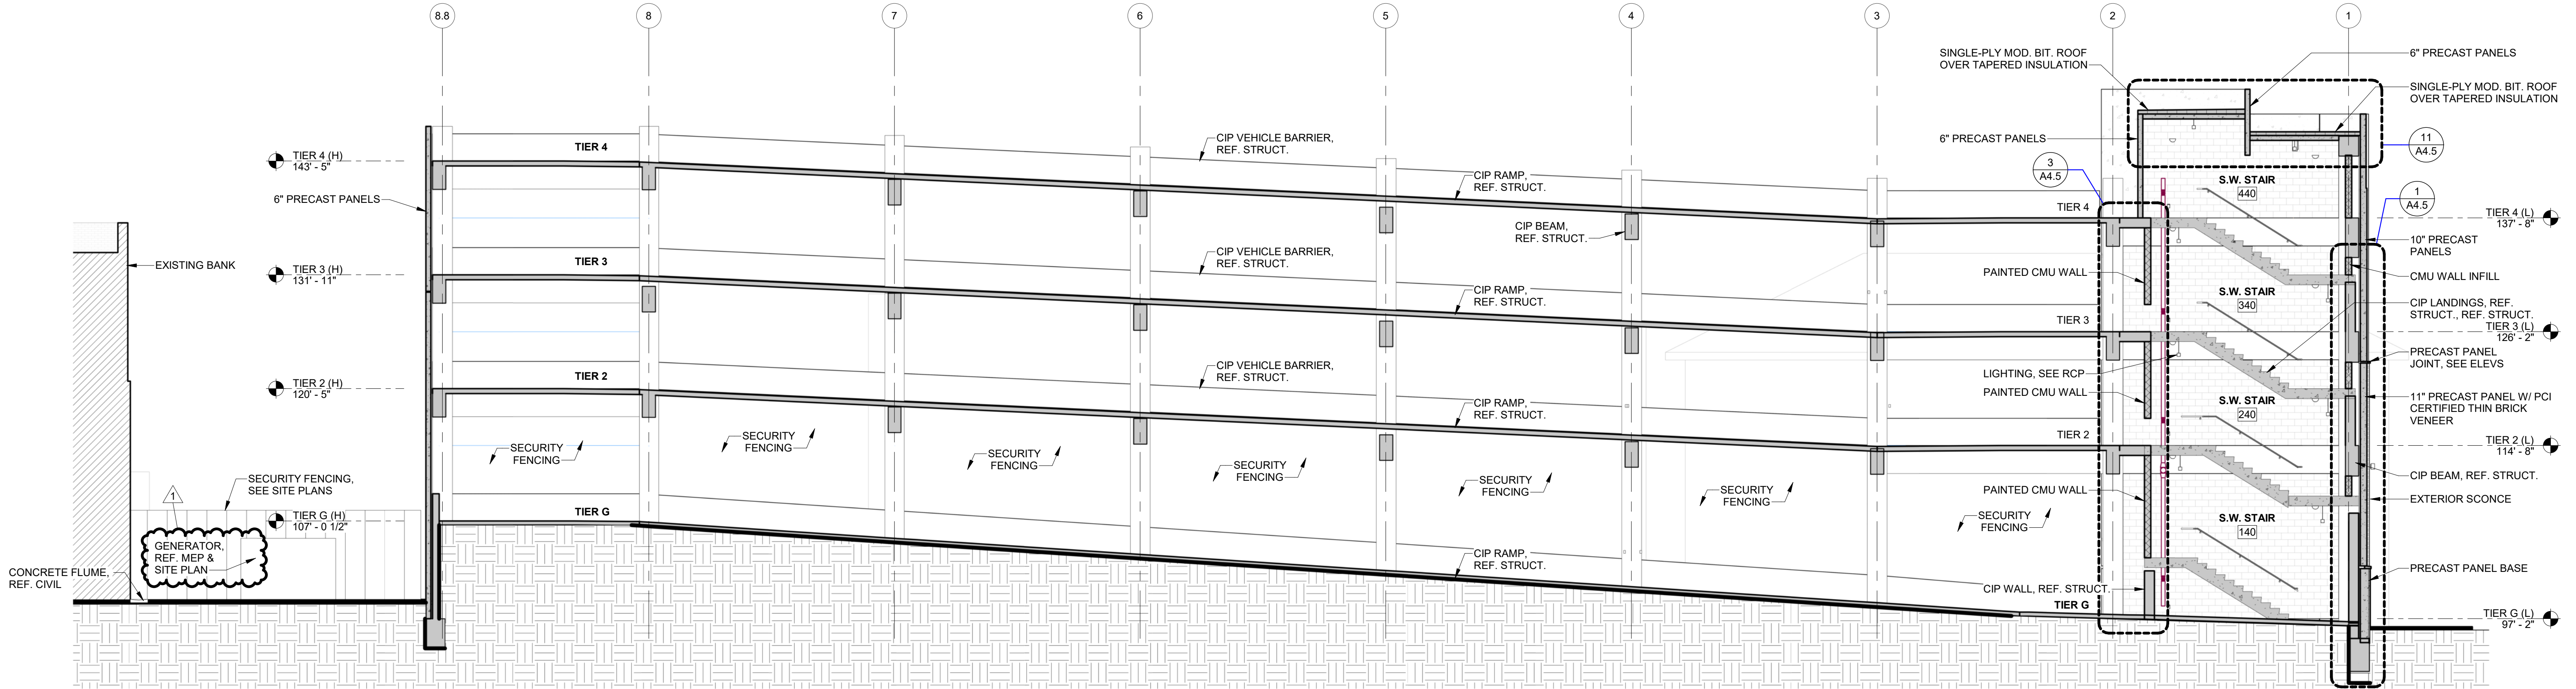


BUILDING SECTION 6
 SCALE: 1/8" = 1'-0"
 A4.2

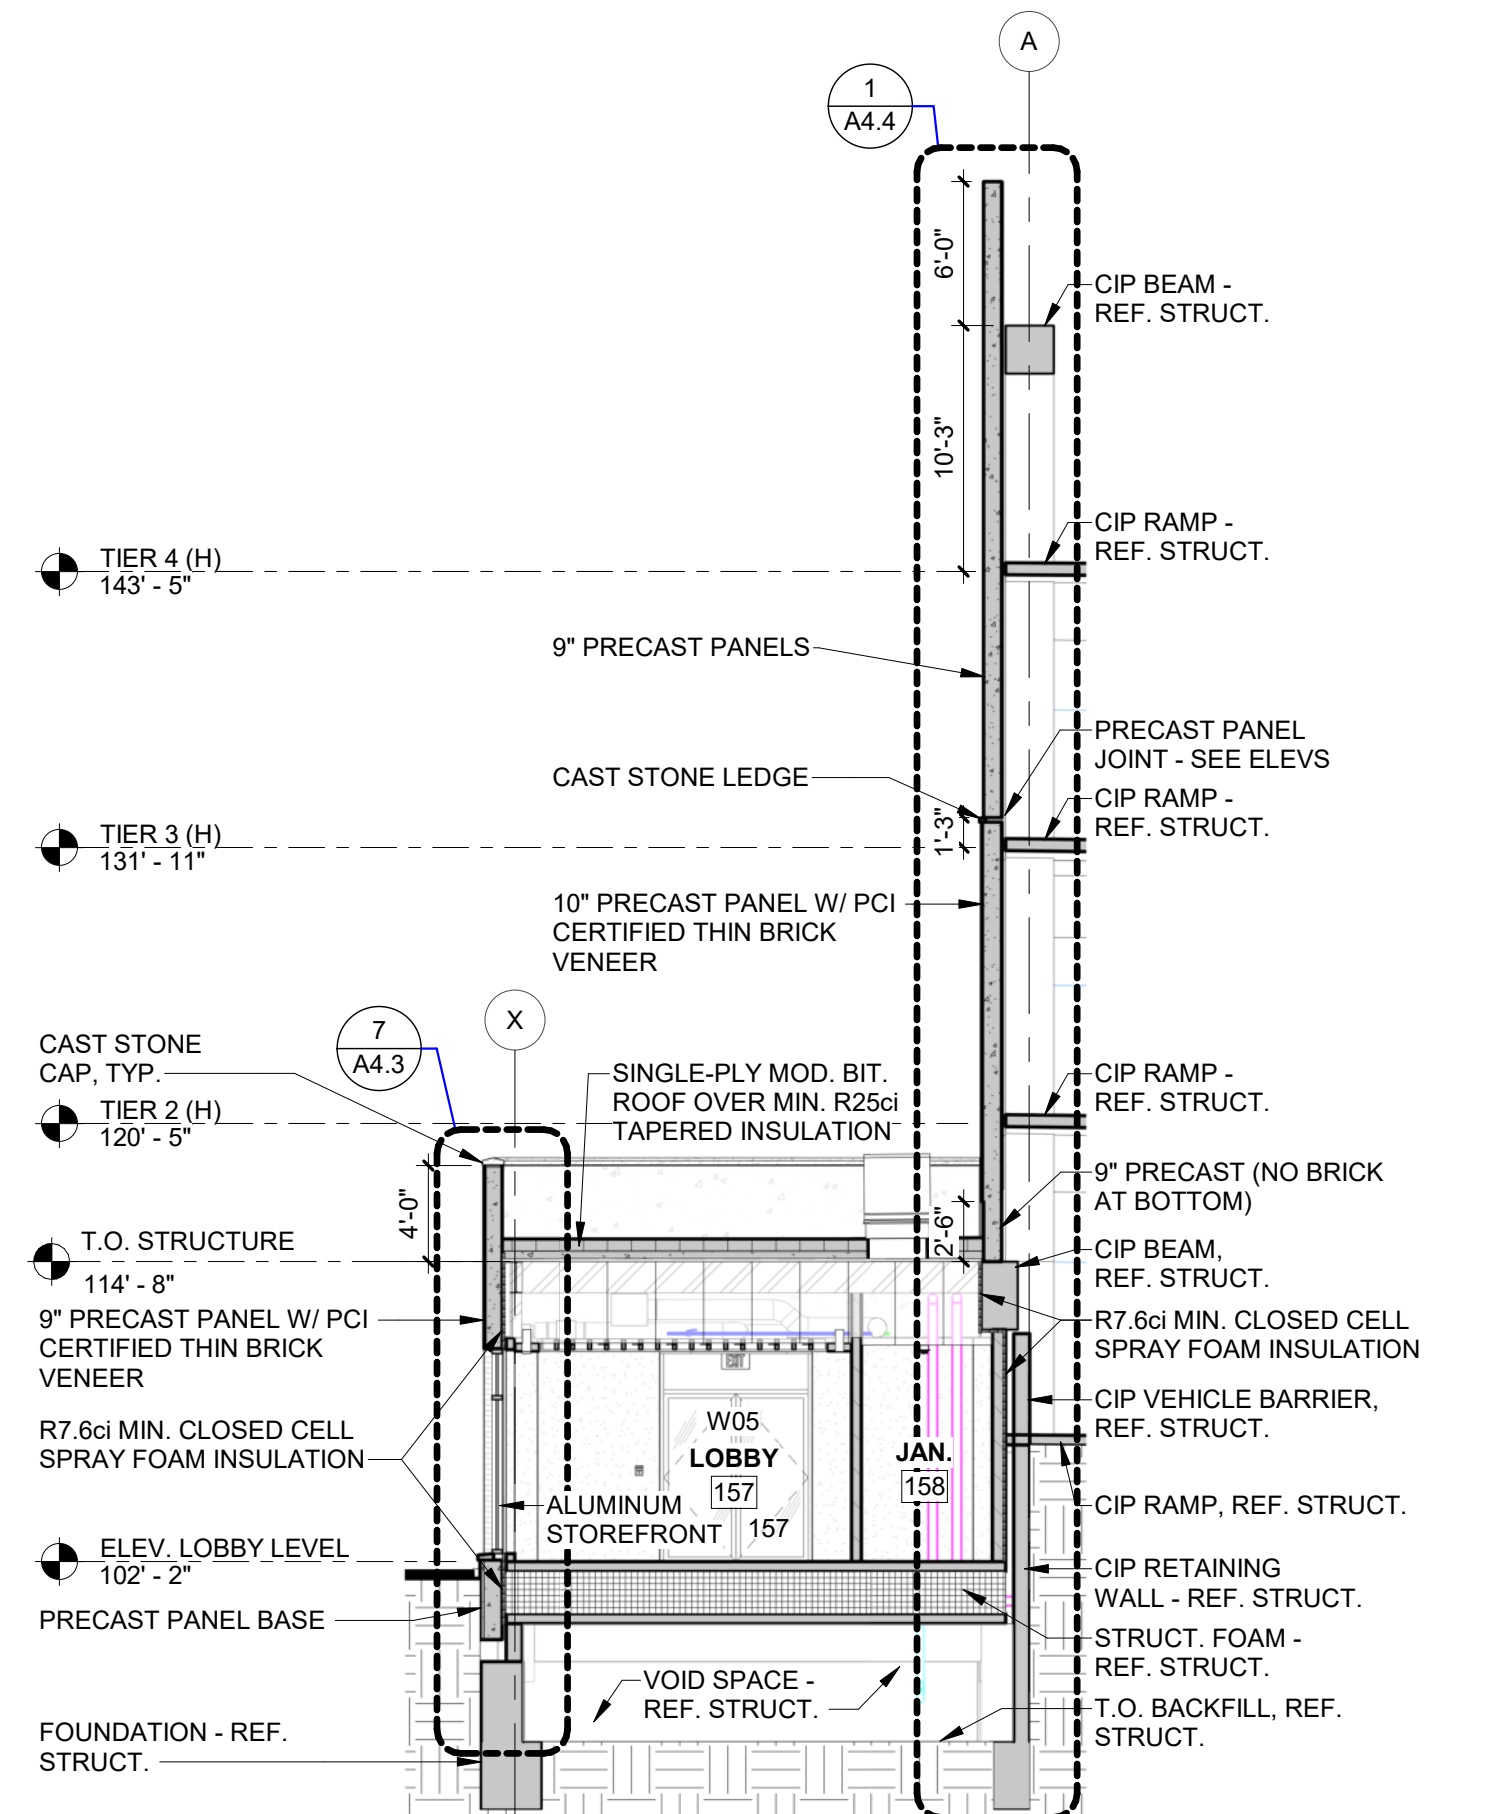


BUILDING SECTION 5
 SCALE: 1/8" = 1'-0"
 A4.2

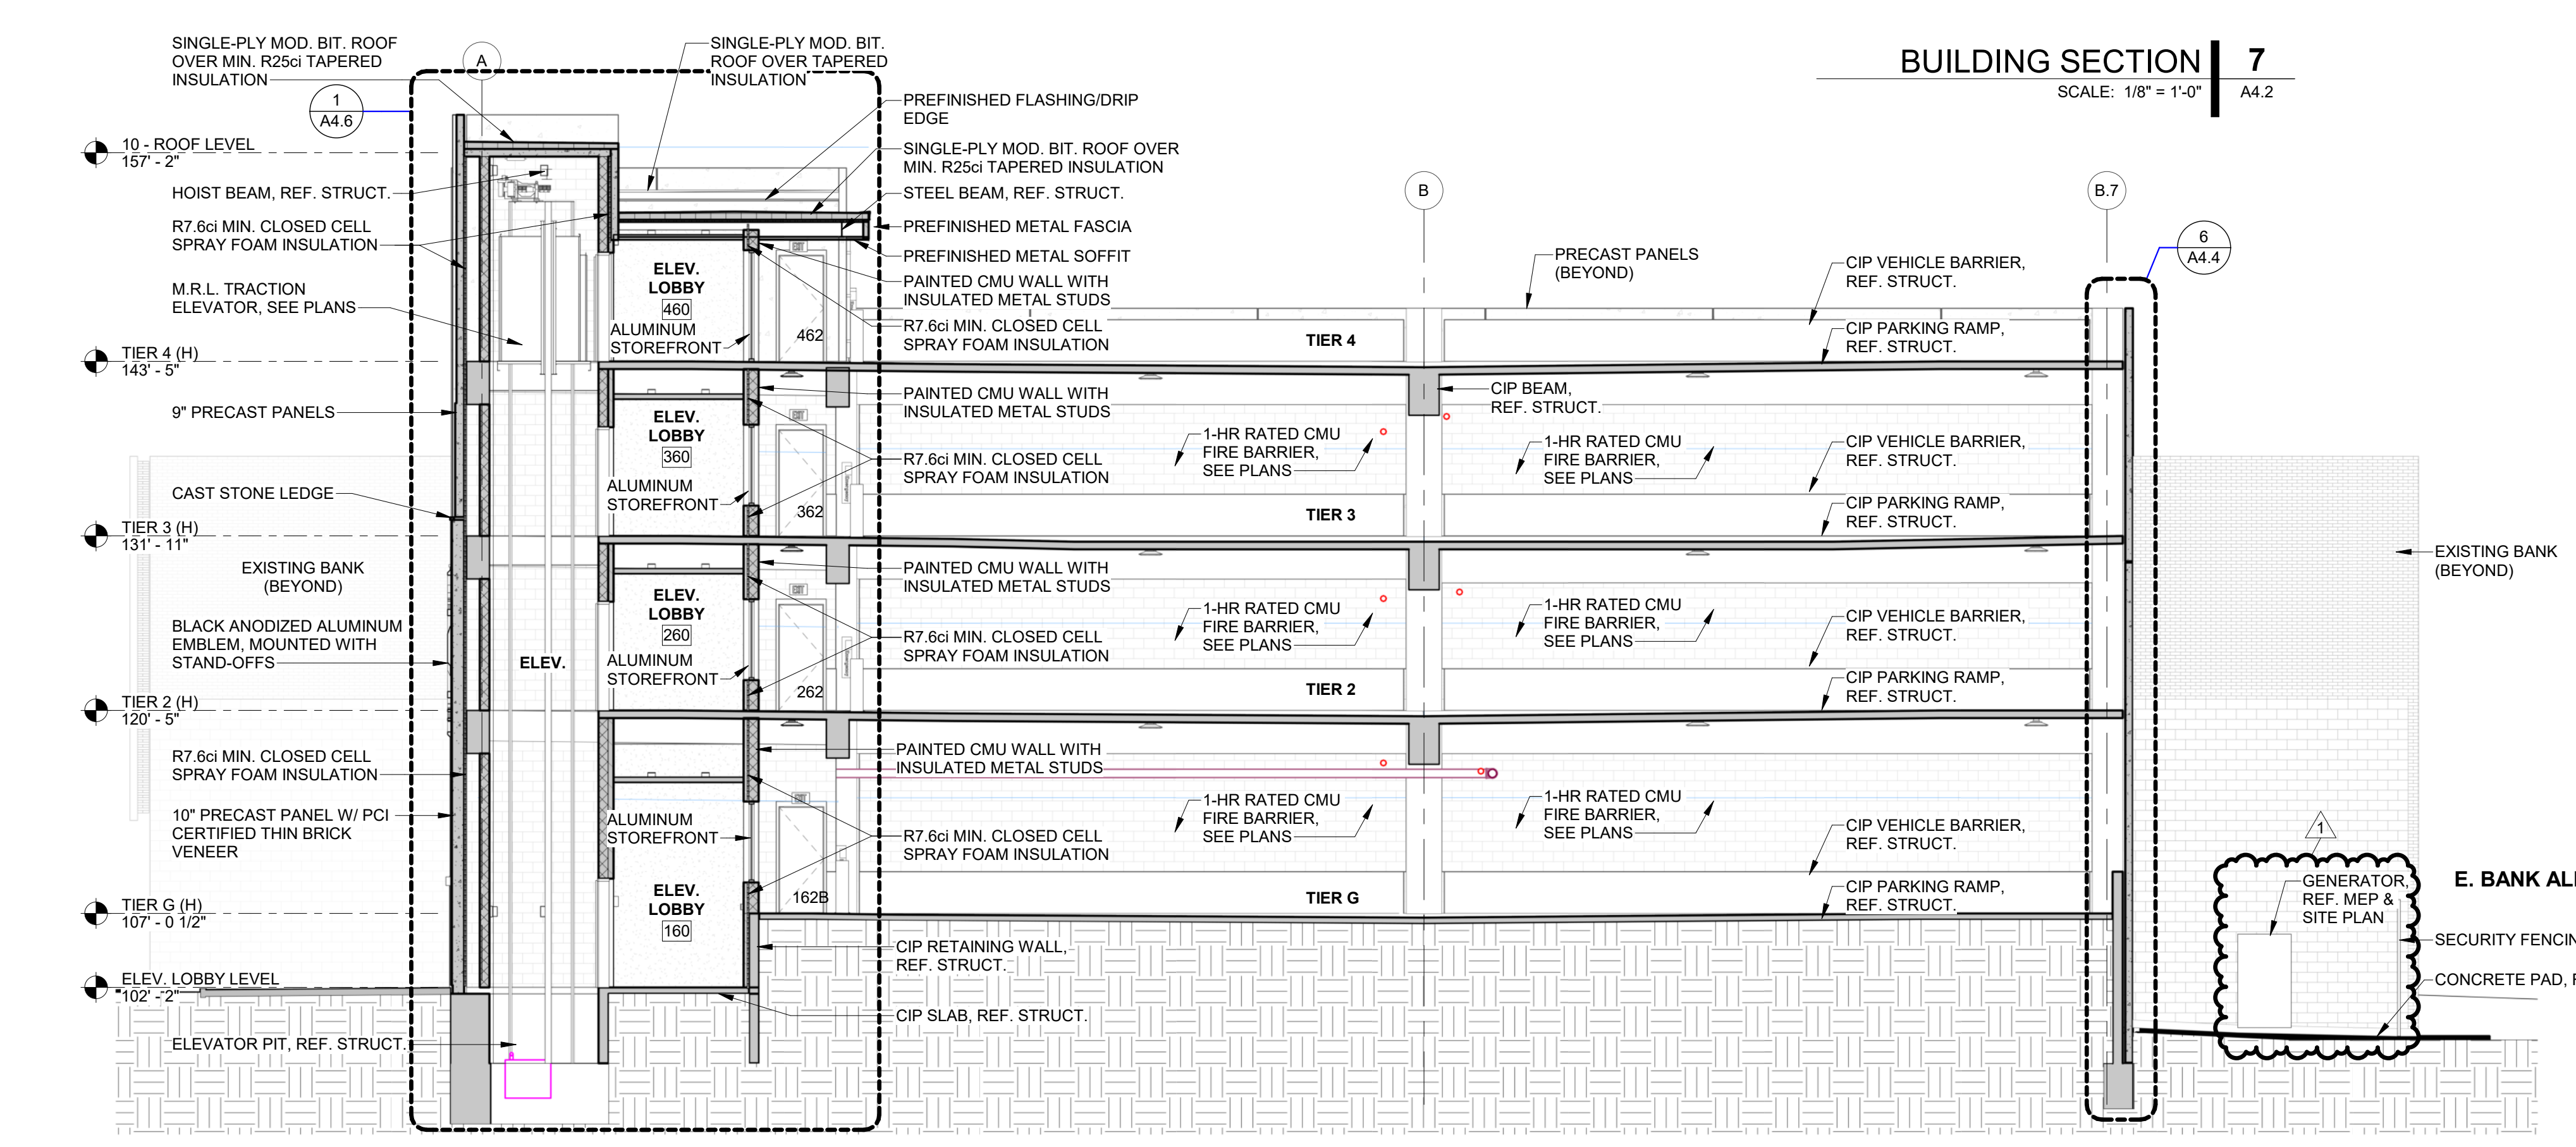


BUILDING SECTION 7
 SCALE: 1/8" = 1'-0"
 A4.2

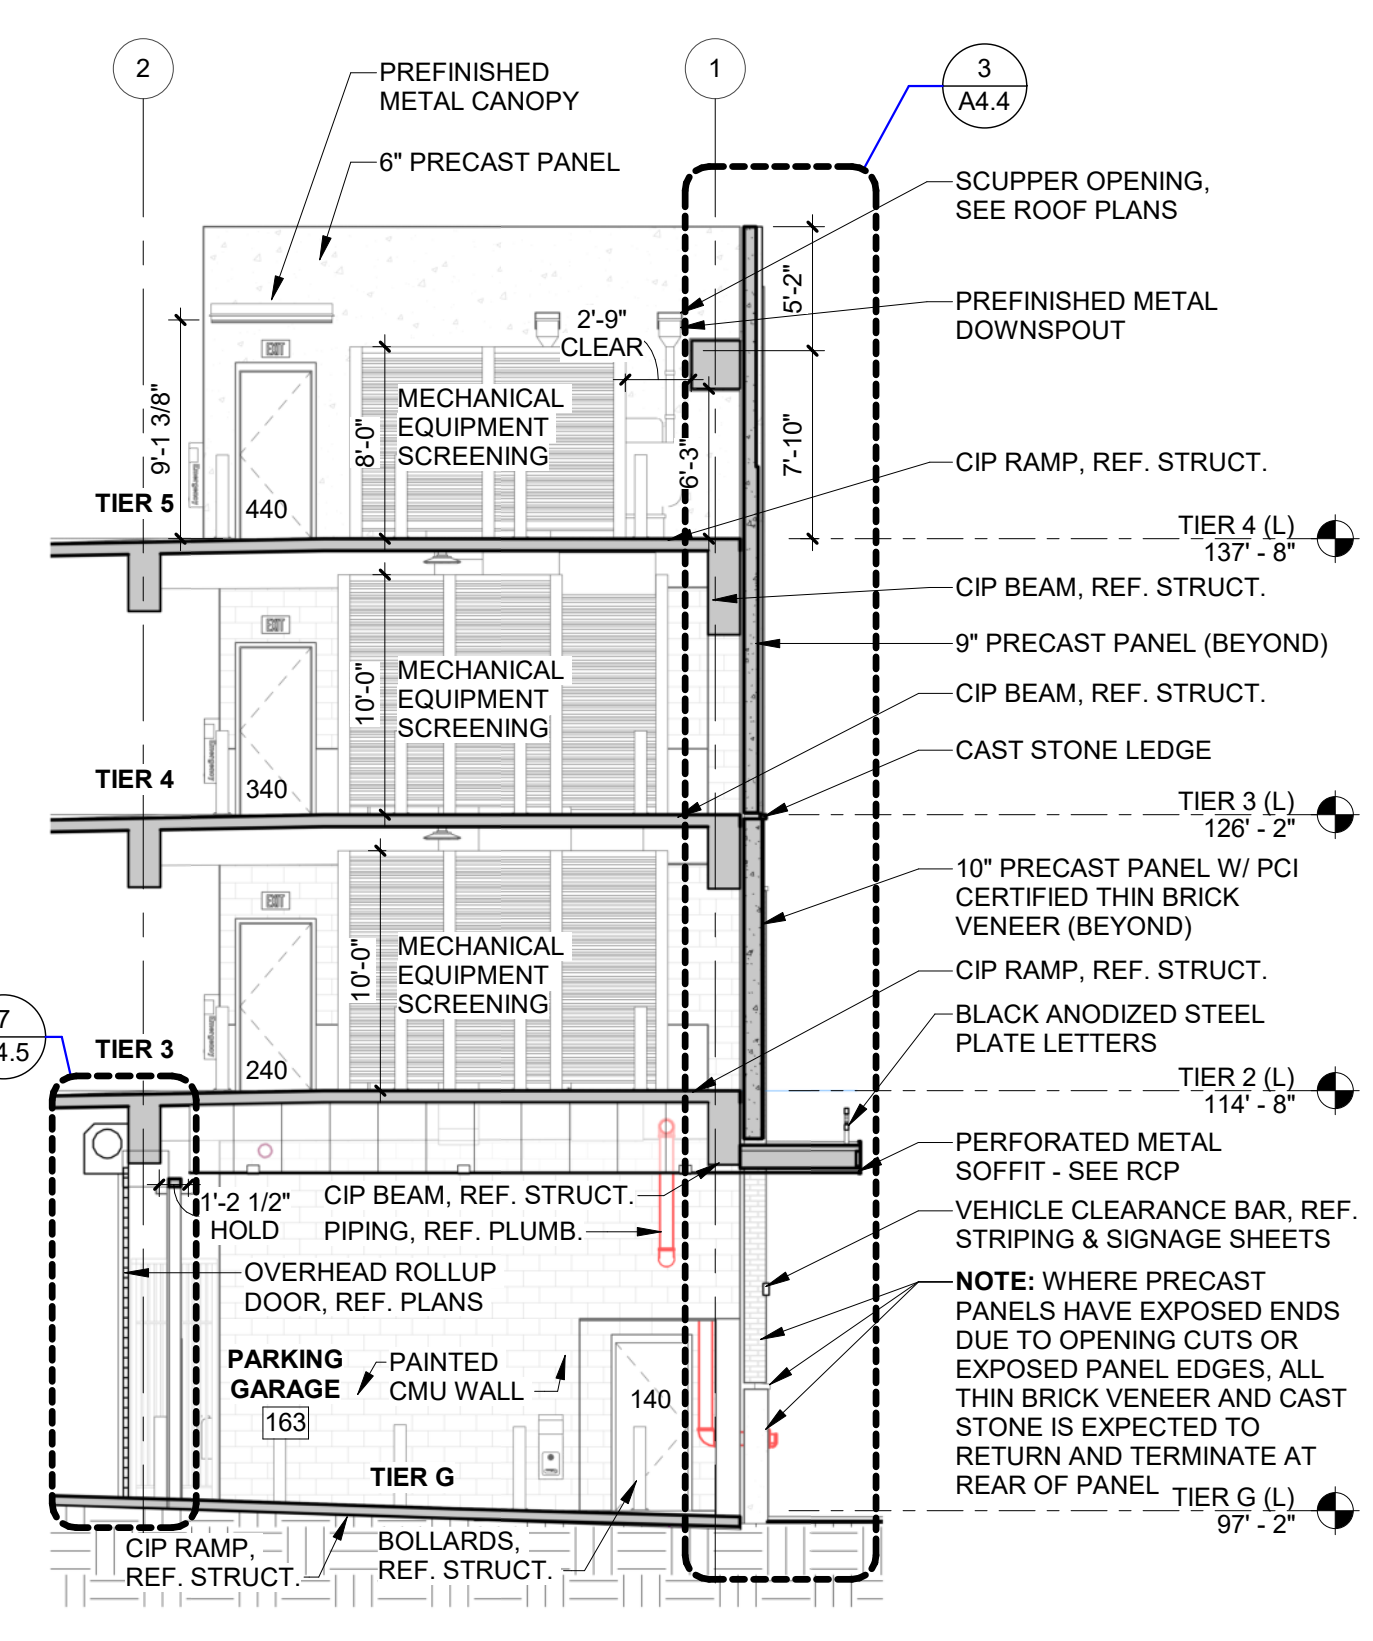

BUILDING SECTION 3
 SCALE: 1/8" = 1'-0"
 A4.2

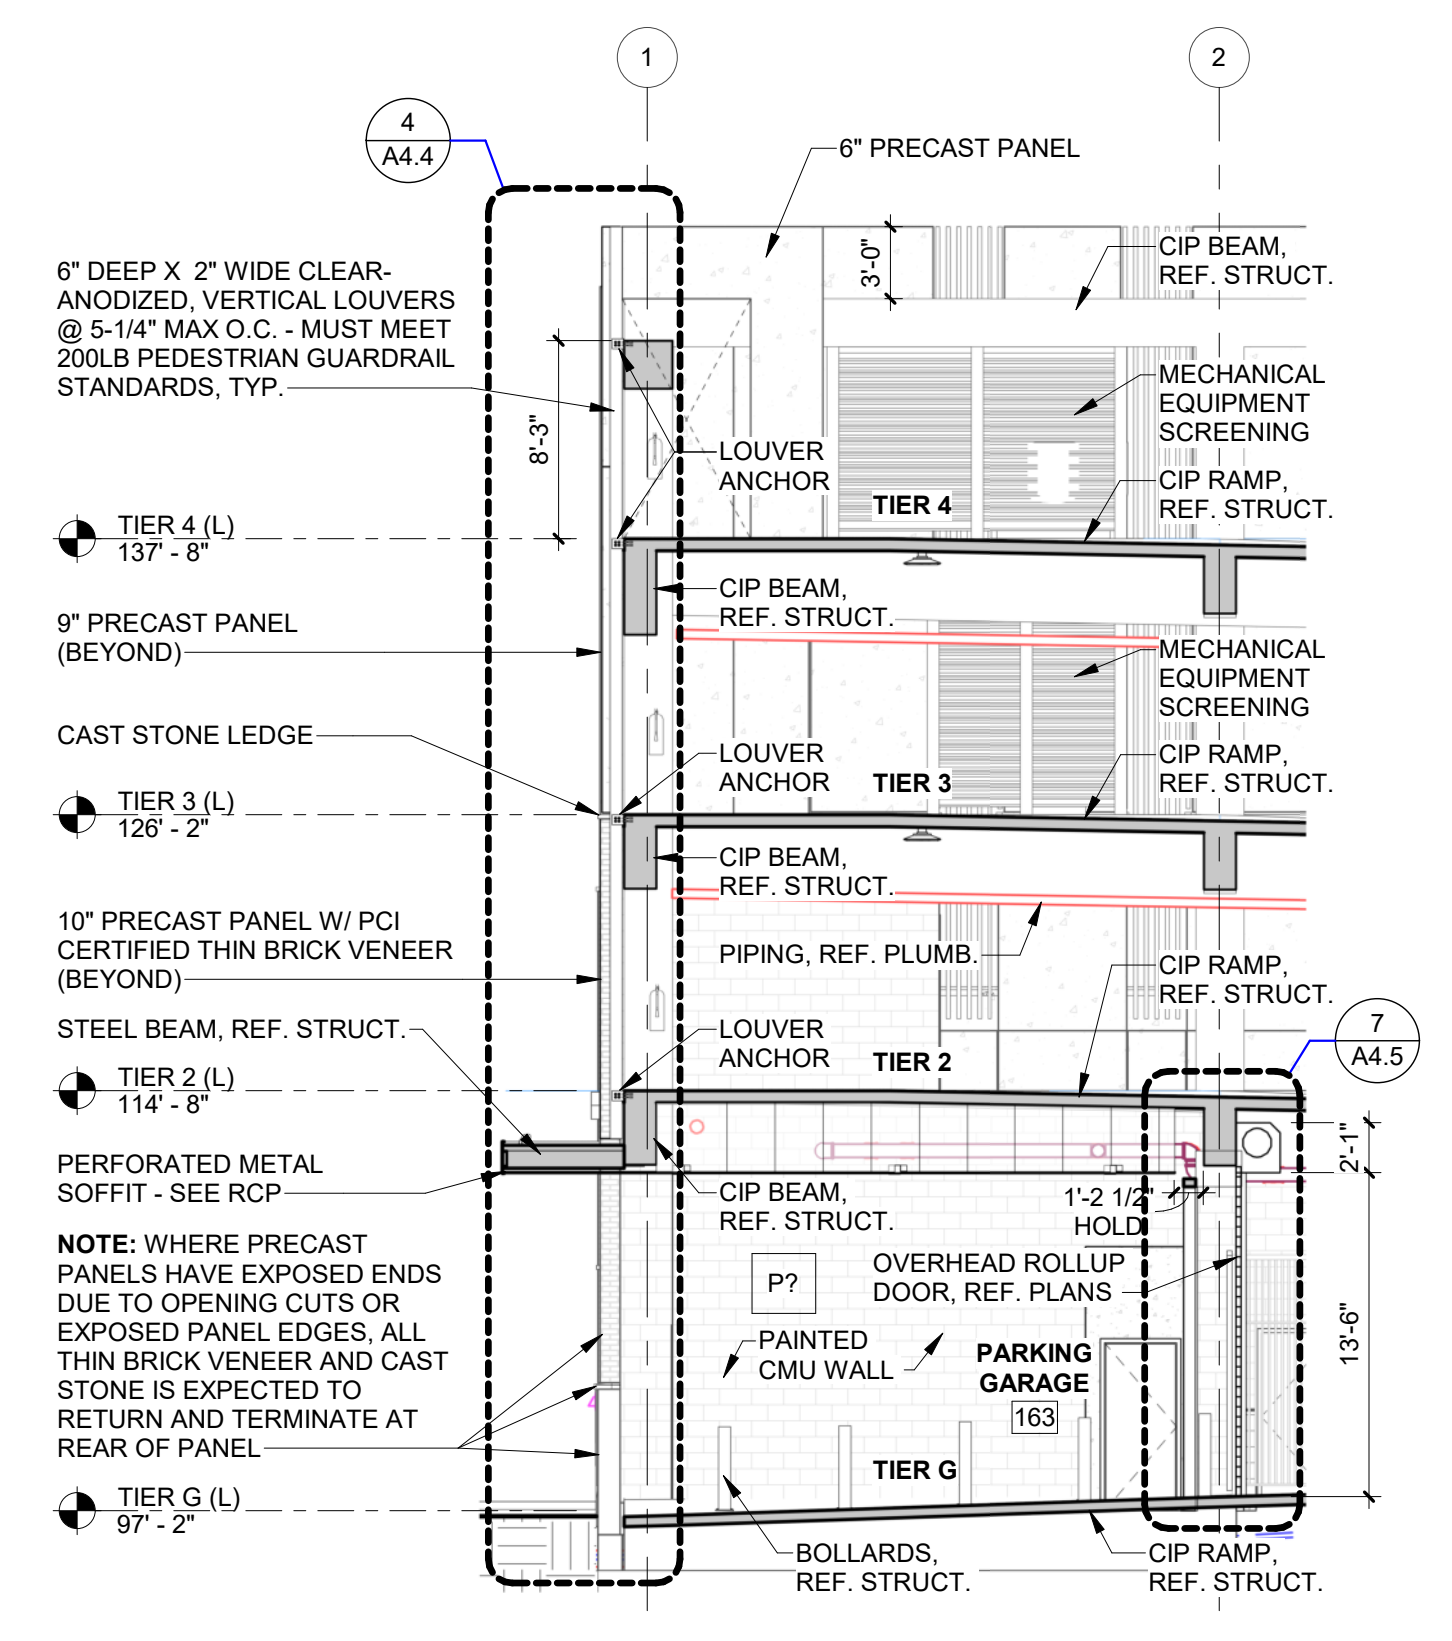

BUILDING SECTION 2
 SCALE: 1/8" = 1'-0"
 A4.2

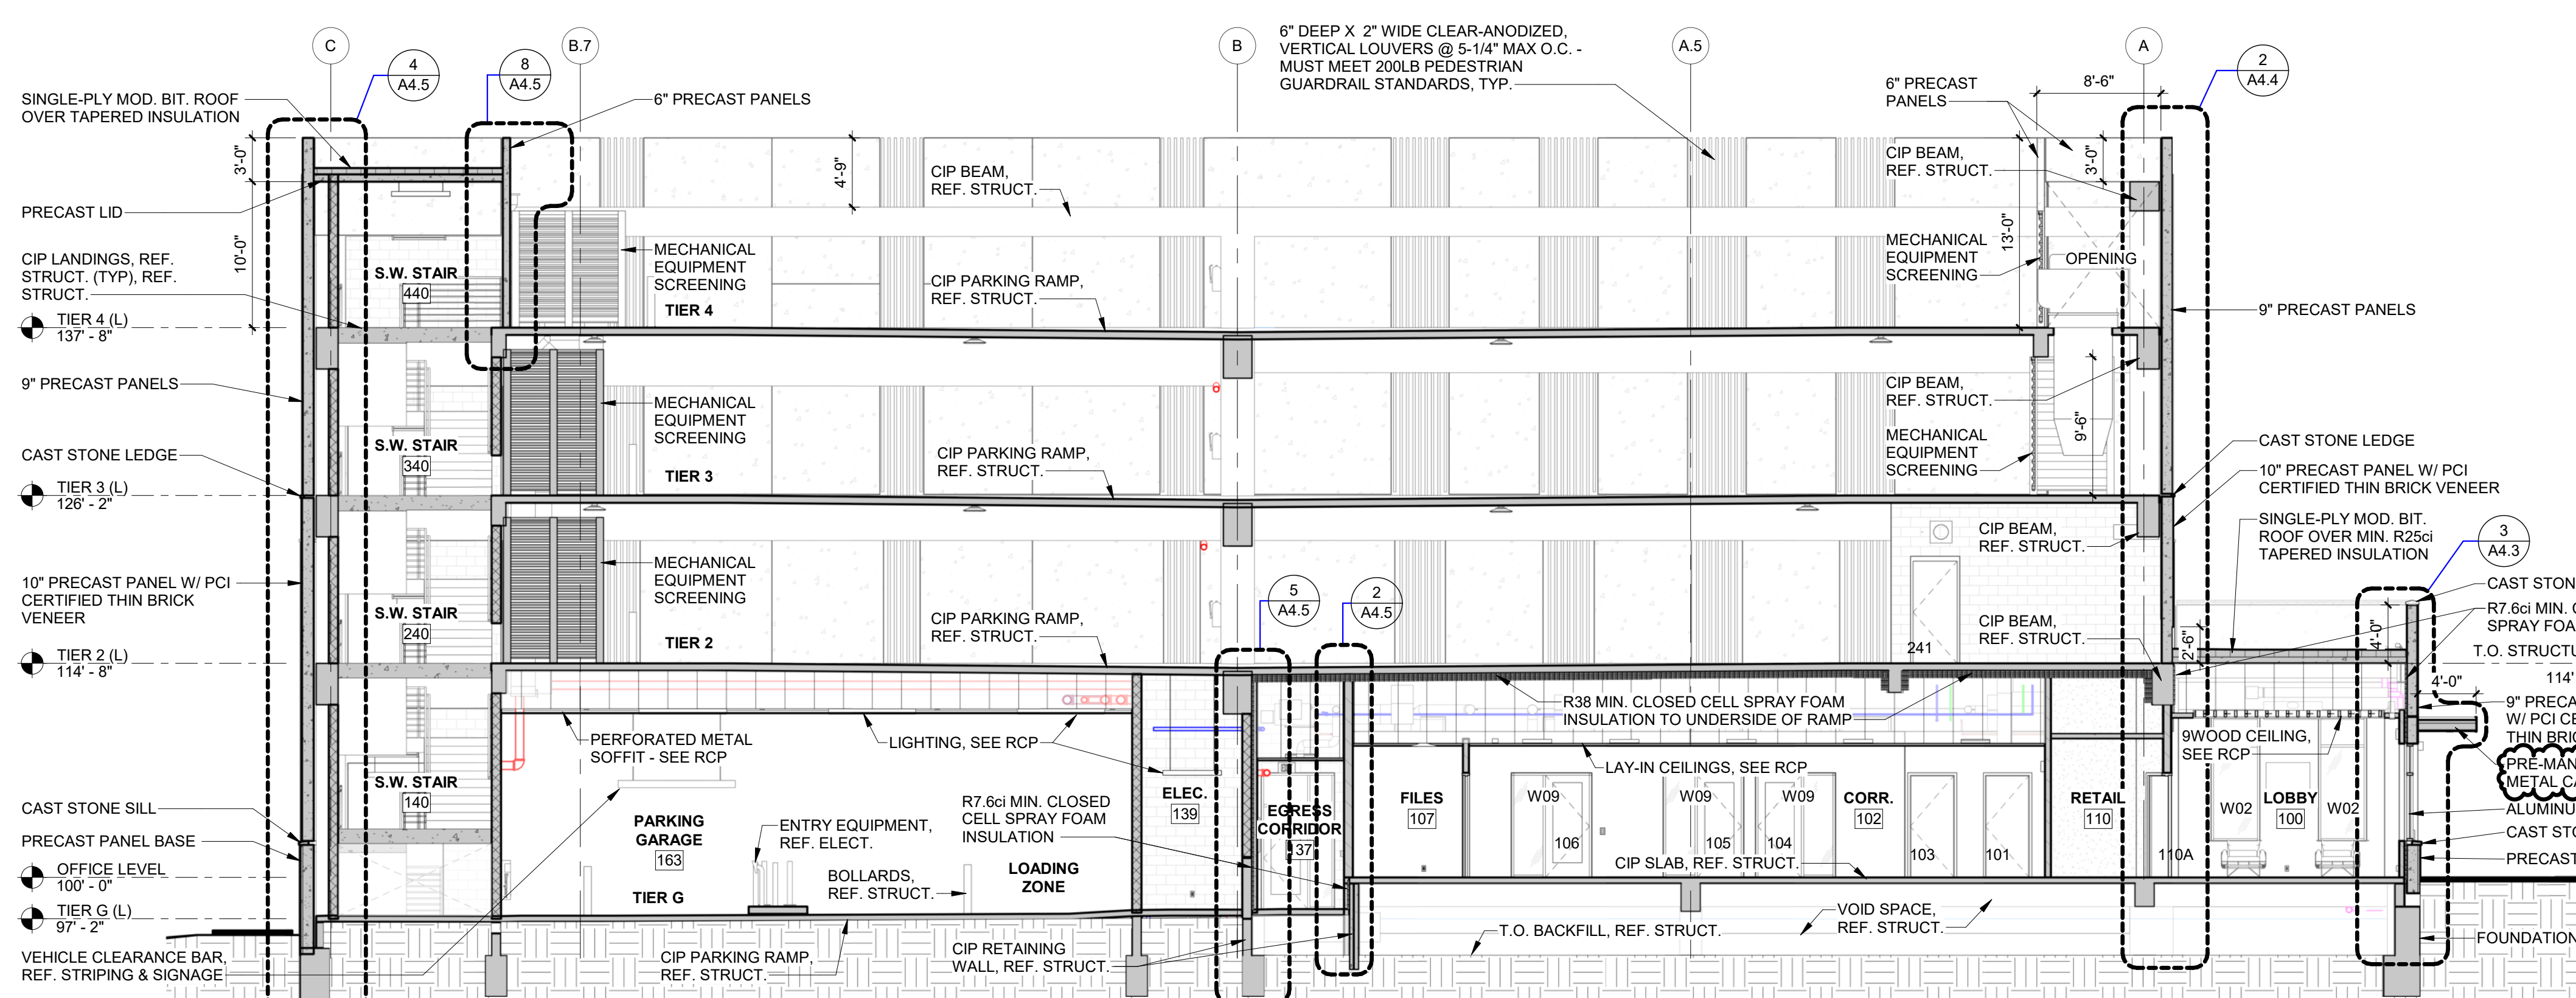

BUILDING SECTION 4
 SCALE: 1/8" = 1'-0"
 A4.2

NOTE: WHERE PRECAST PANELS HAVE EXPOSED ENDS DUE TO OPENING CUTS OR EXPOSED PANEL EDGES, ALL THIN BRICK VENEER AND CAST STONE IS EXPECTED TO RETURN AND TERMINATE AT REAR OF PANEL.


NOTE: WHERE PRECAST PANELS HAVE EXPOSED ENDS DUE TO OPENING CUTS OR EXPOSED PANEL EDGES, ALL THIN BRICK VENEER AND CAST STONE IS EXPECTED TO RETURN AND TERMINATE AT REAR OF PANEL.




PROJECT NO.: 20011
 DATE: 03/03/2022

REVISION SCHEDULE	
A	Date
1	03-17-2022
1	ADDENDUM 04


SHEET NAME
WALL SECTIONS
 SHEET NO.

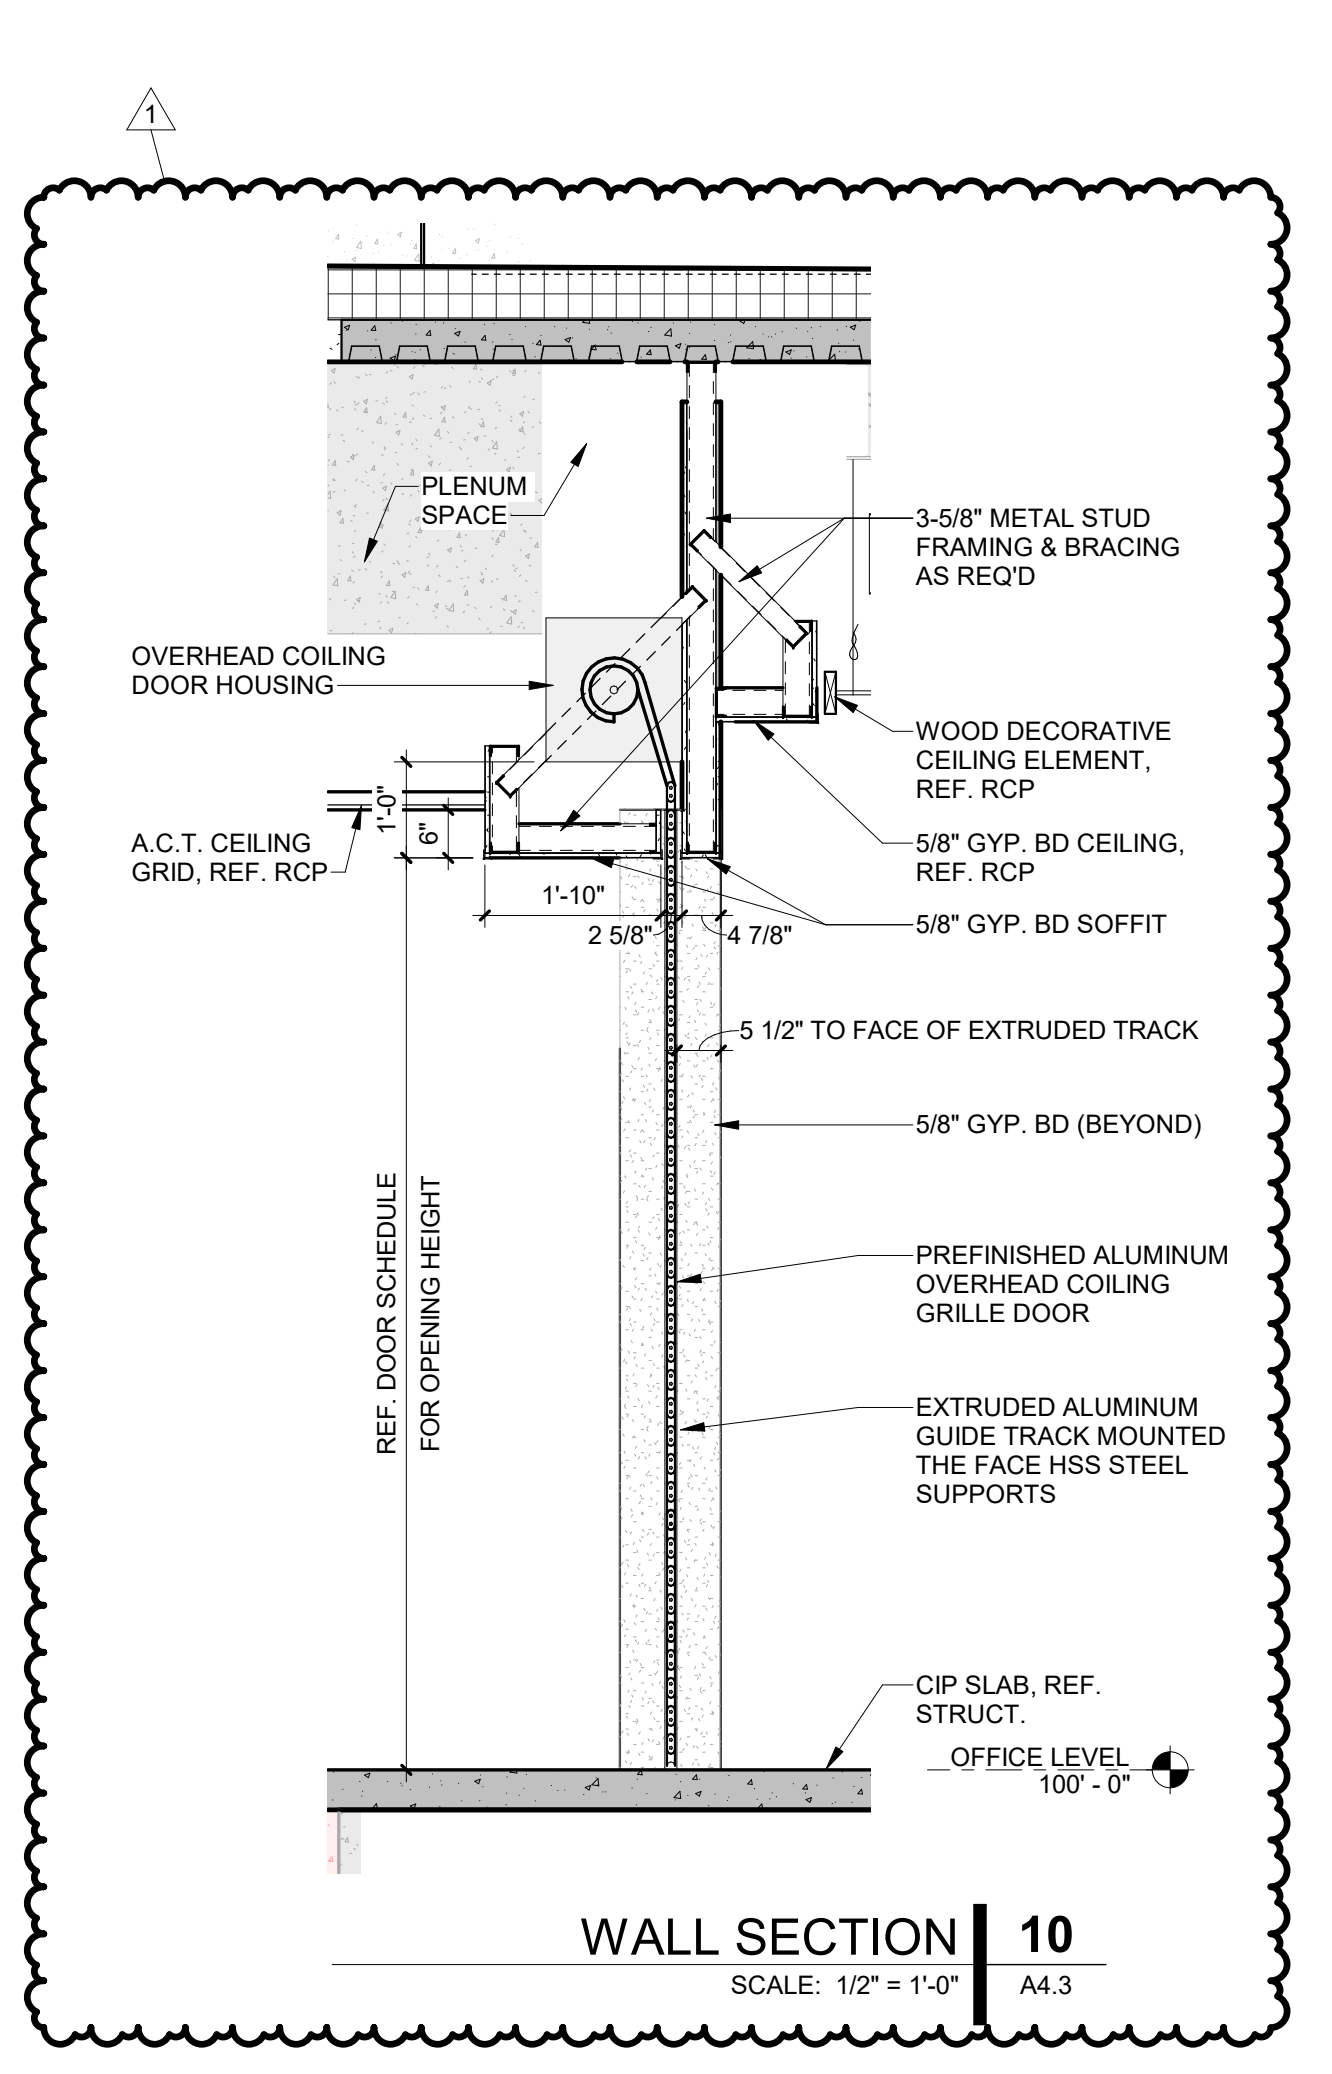


WALL SECTION 10
 SCALE: 1/2" = 1'-0"
 A4.3

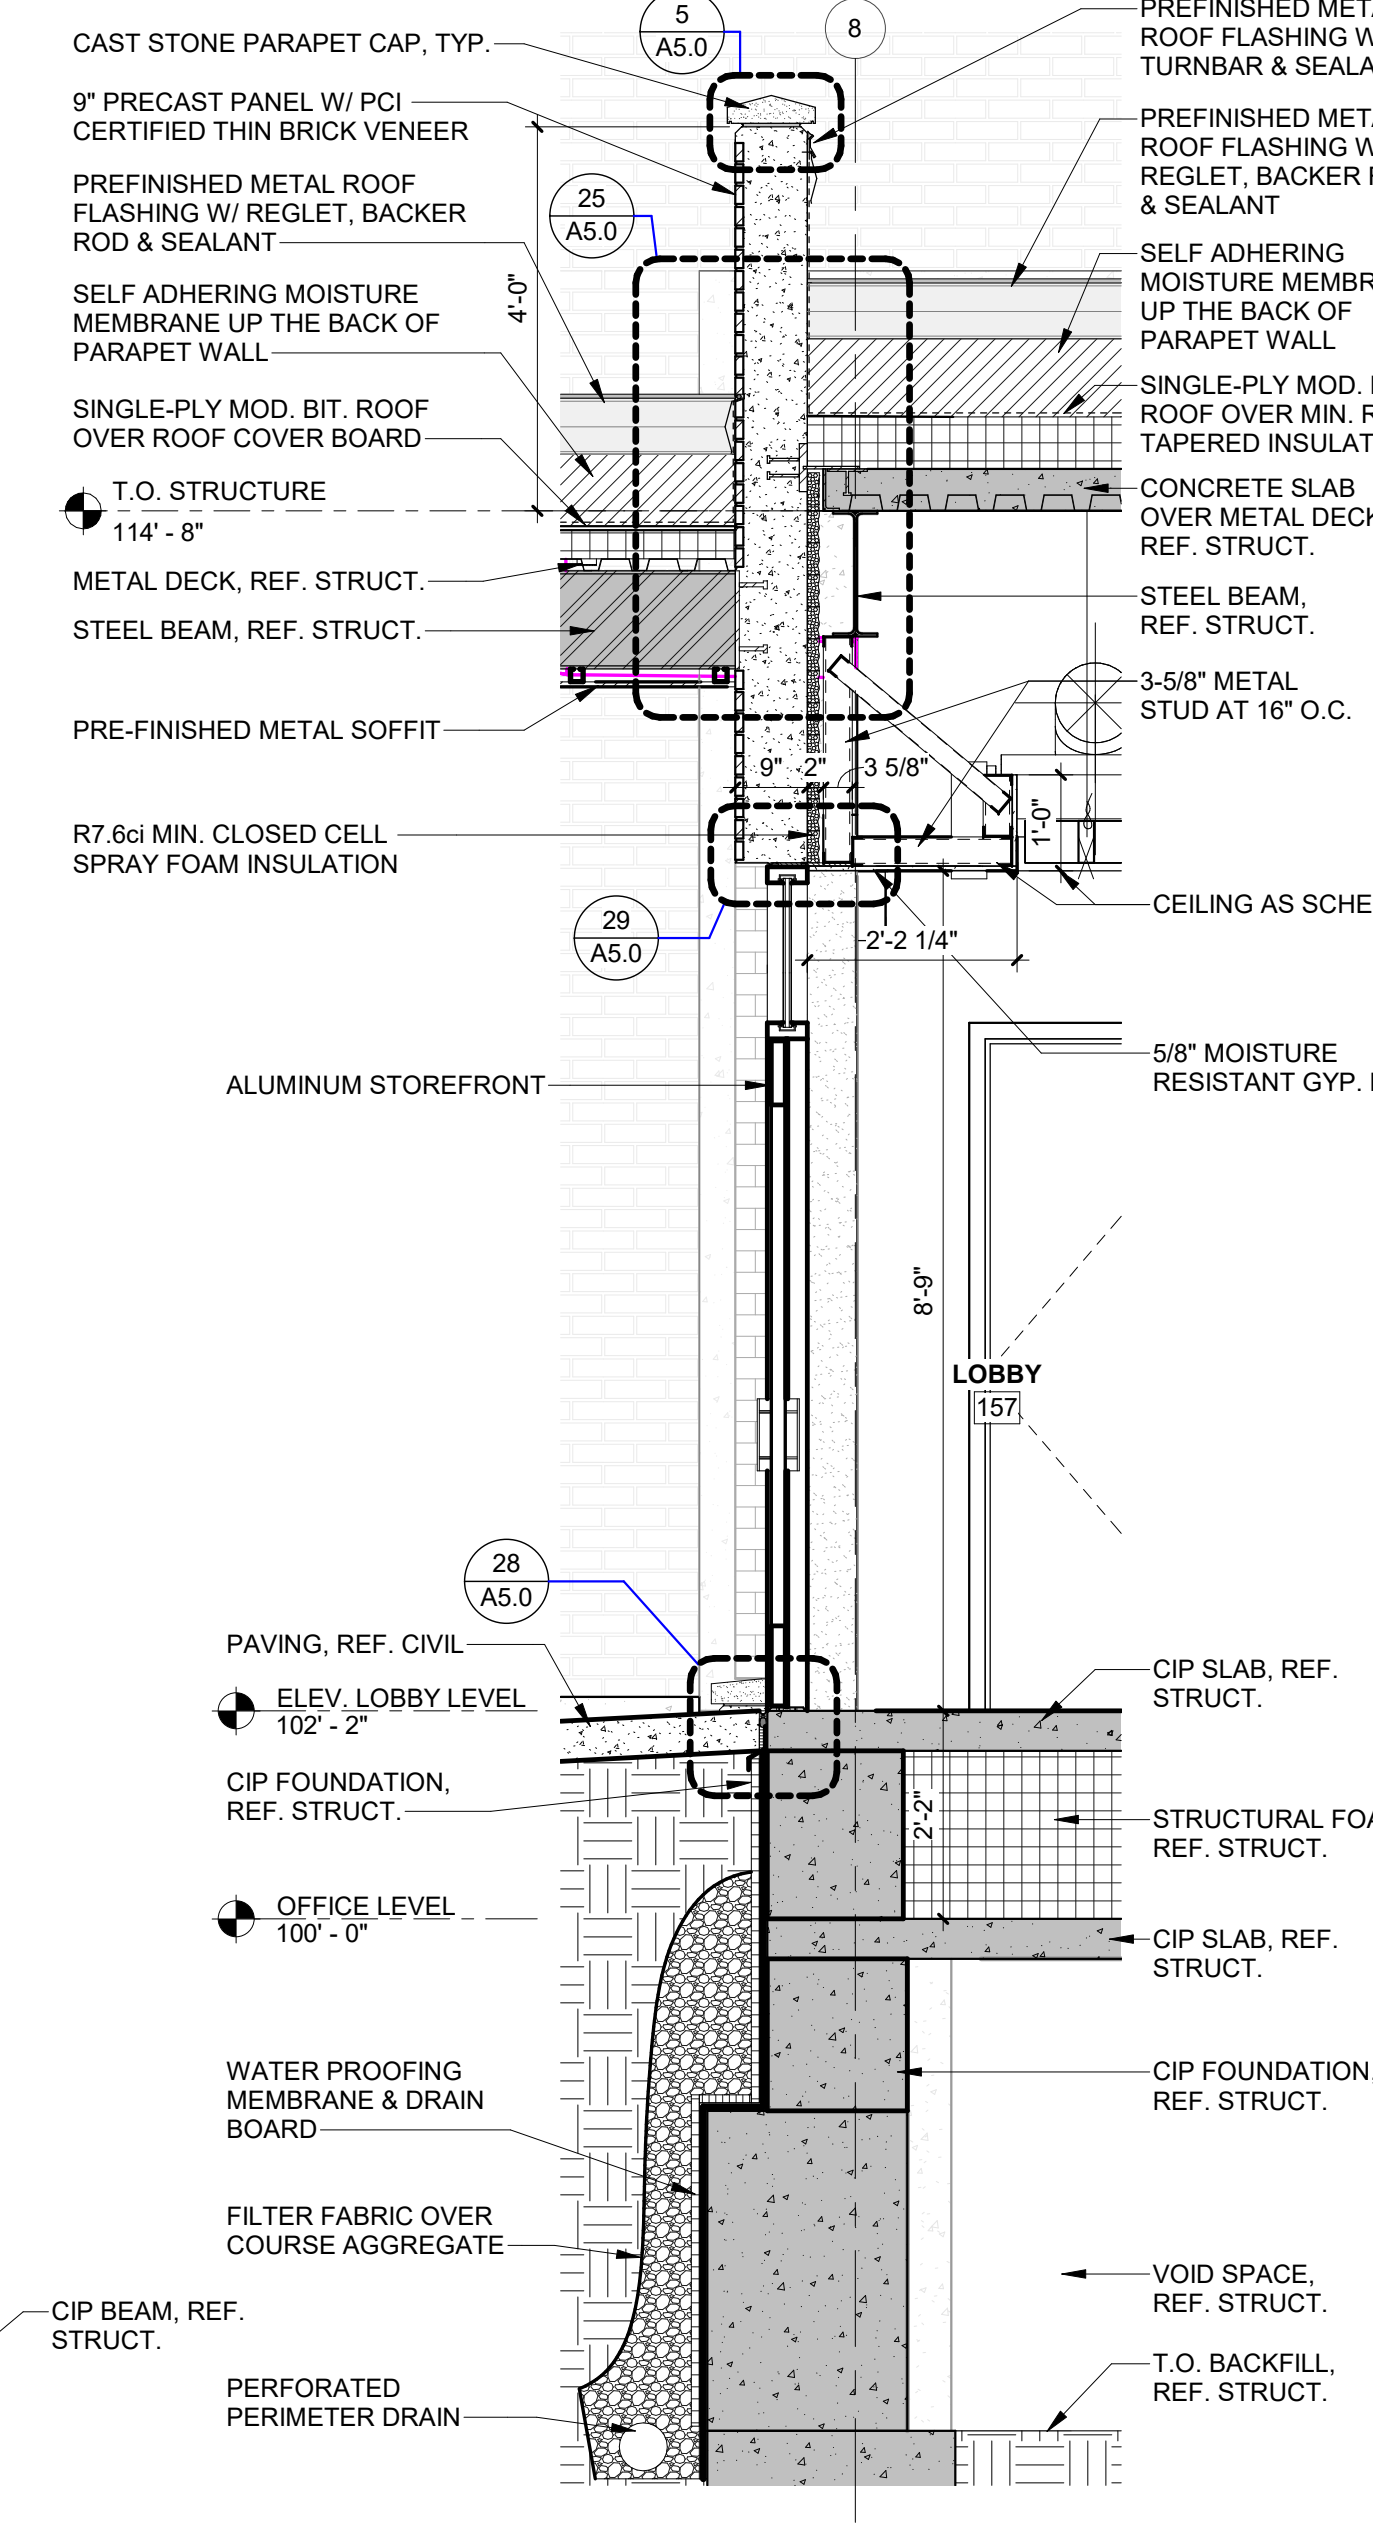


WALL SECTION 9
 SCALE: 1/2" = 1'-0"
 A4.3

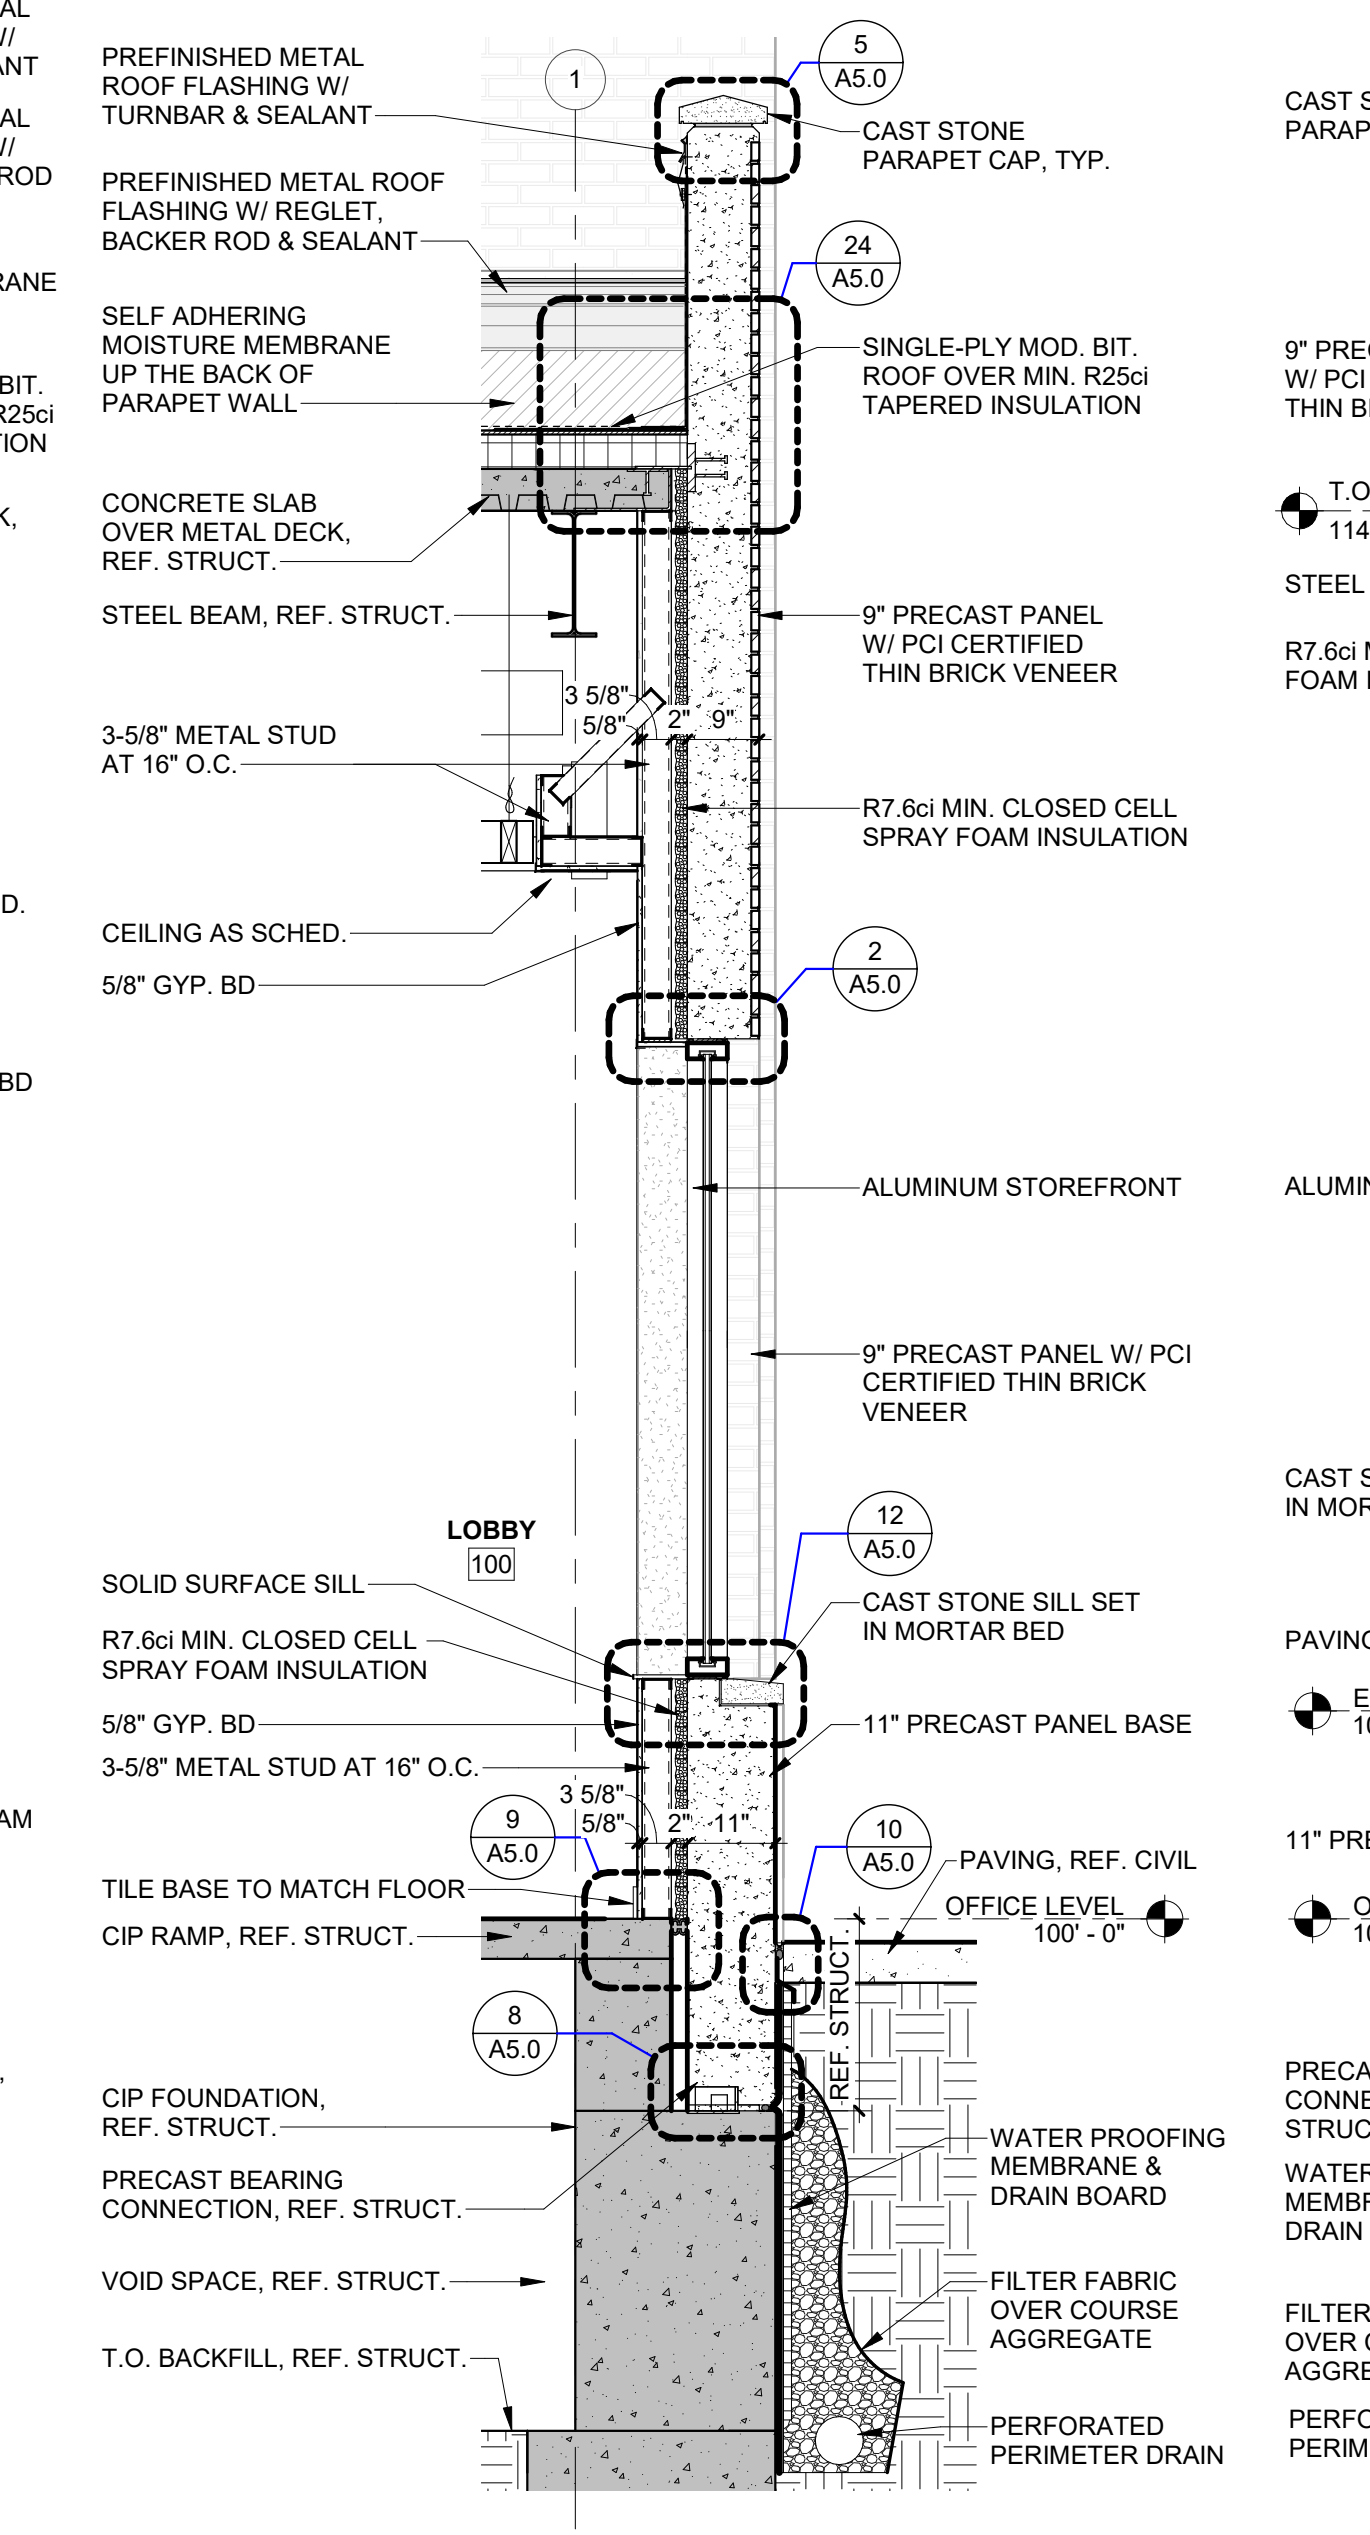


WALL SECTION 8
 SCALE: 1/2" = 1'-0"
 A4.3

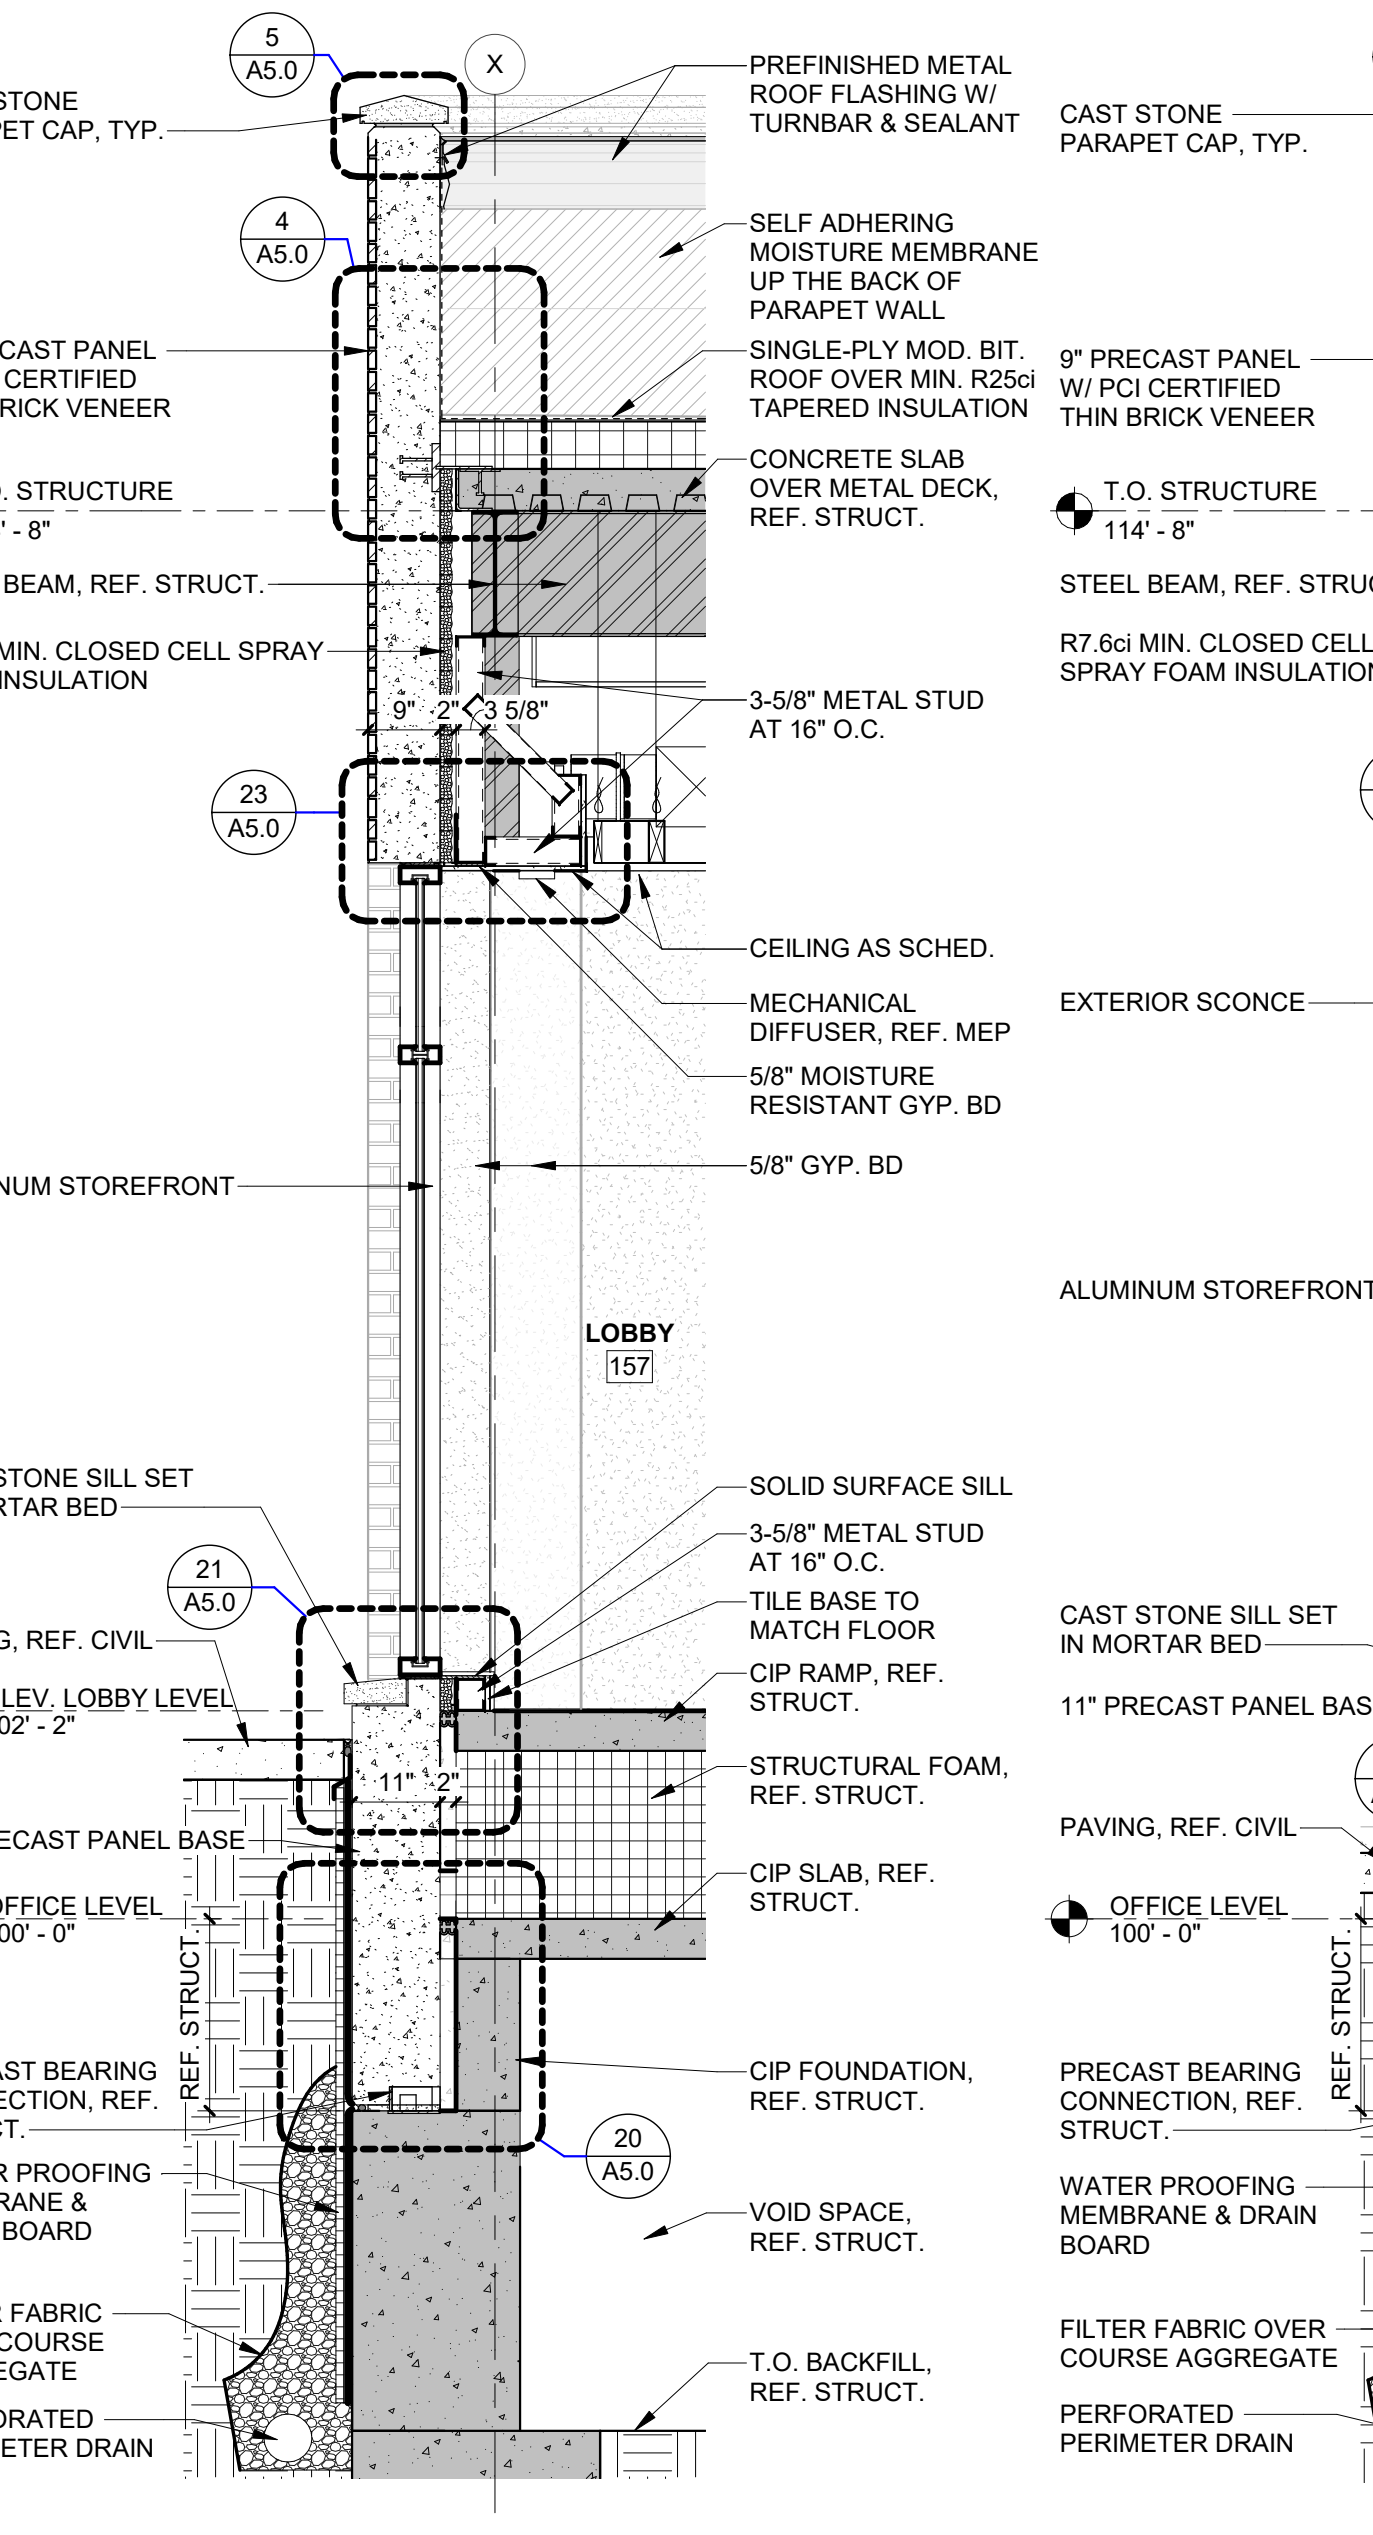


WALL SECTION 7
 SCALE: 1/2" = 1'-0"
 A4.3

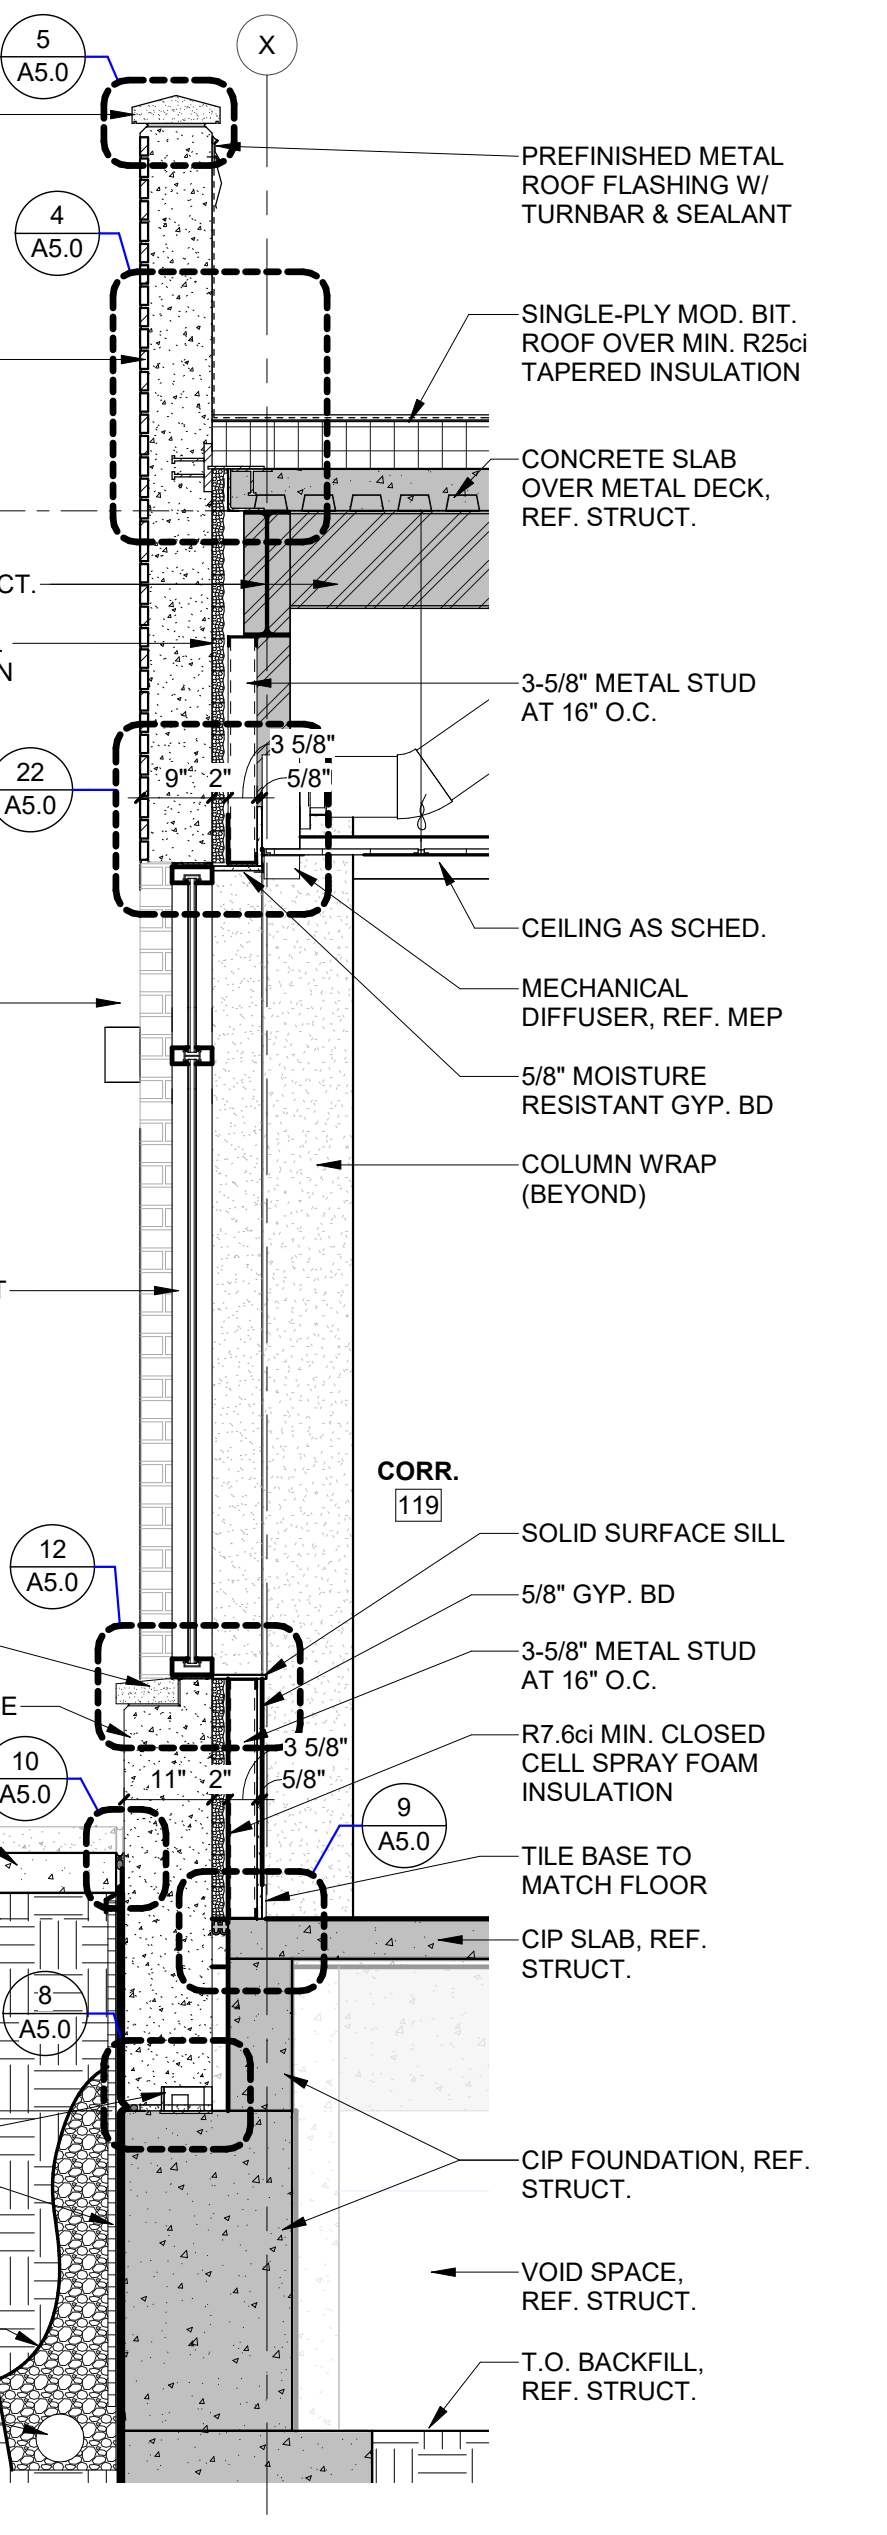


WALL SECTION 6
 SCALE: 1/2" = 1'-0"
 A4.3

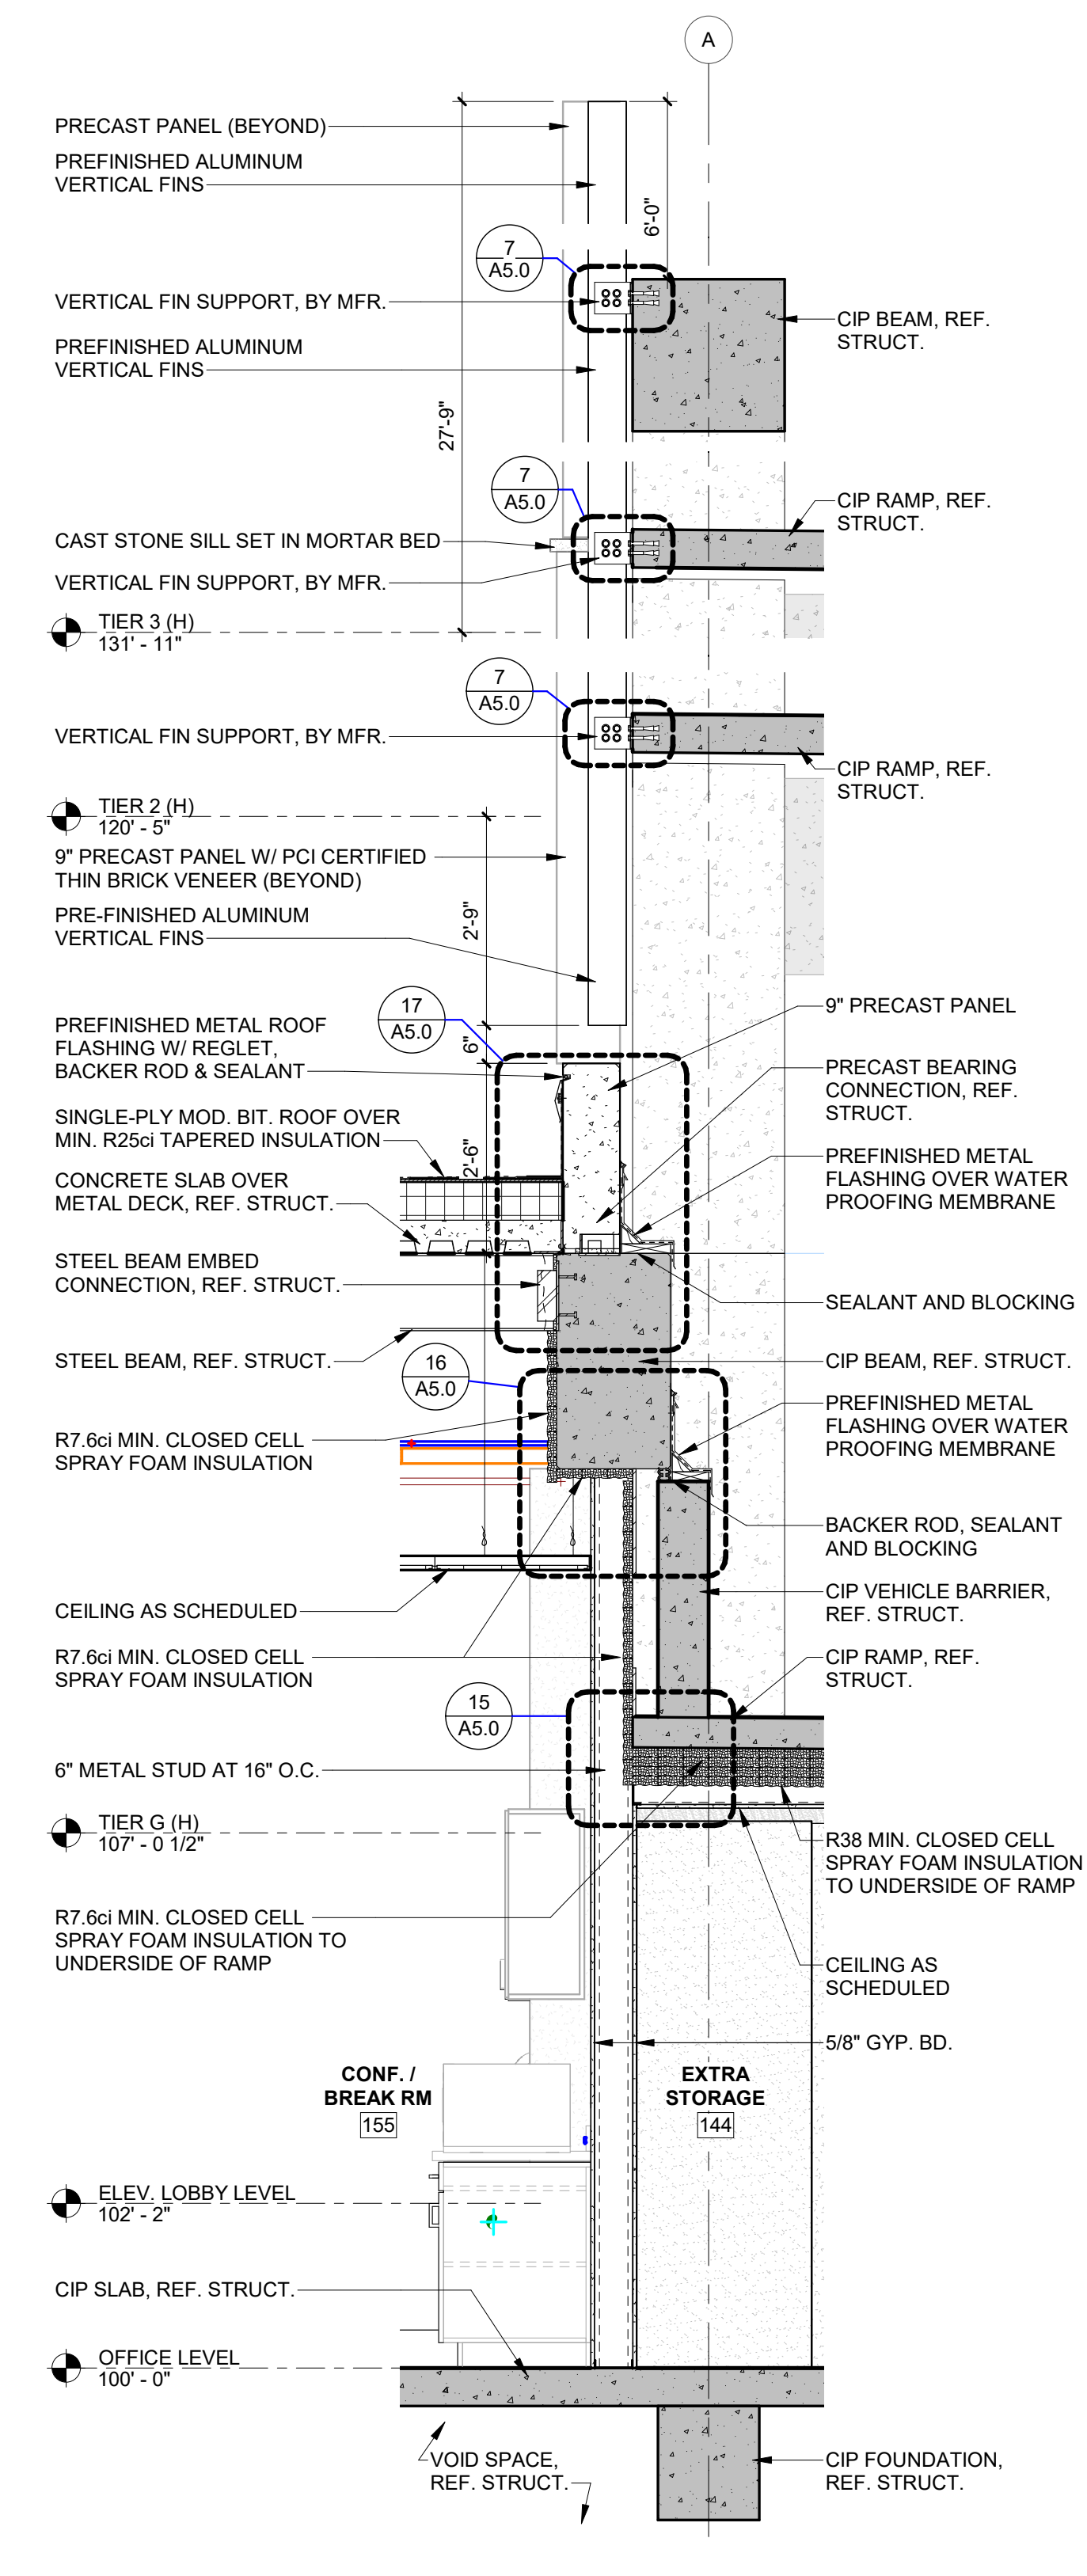


WALL SECTION 5
 SCALE: 1/2" = 1'-0"
 A4.3

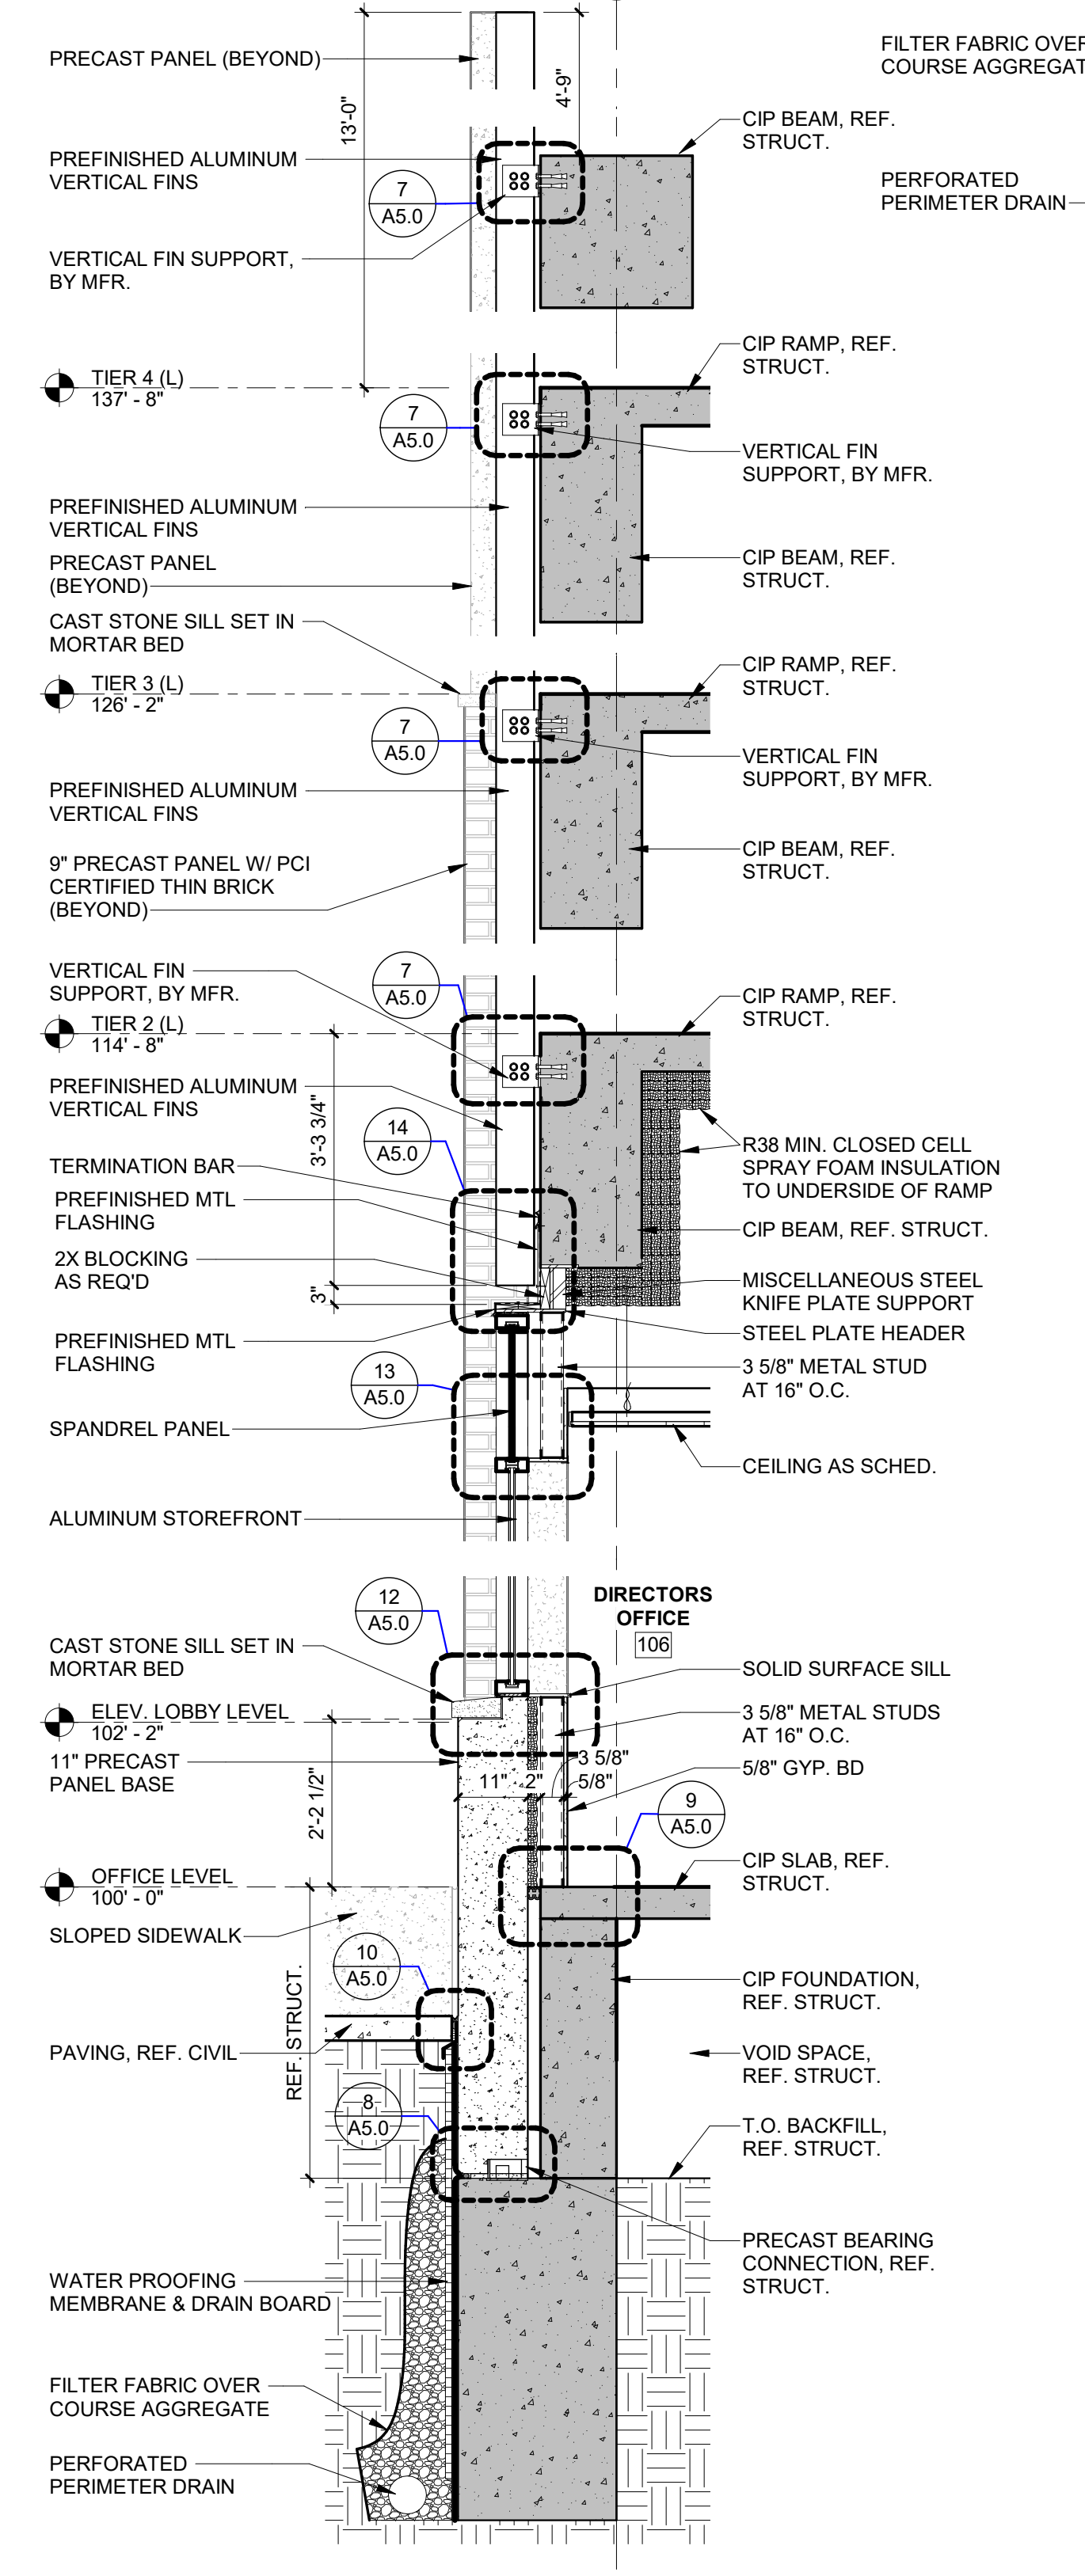


WALL SECTION 4
 SCALE: 1/2" = 1'-0"
 A4.3

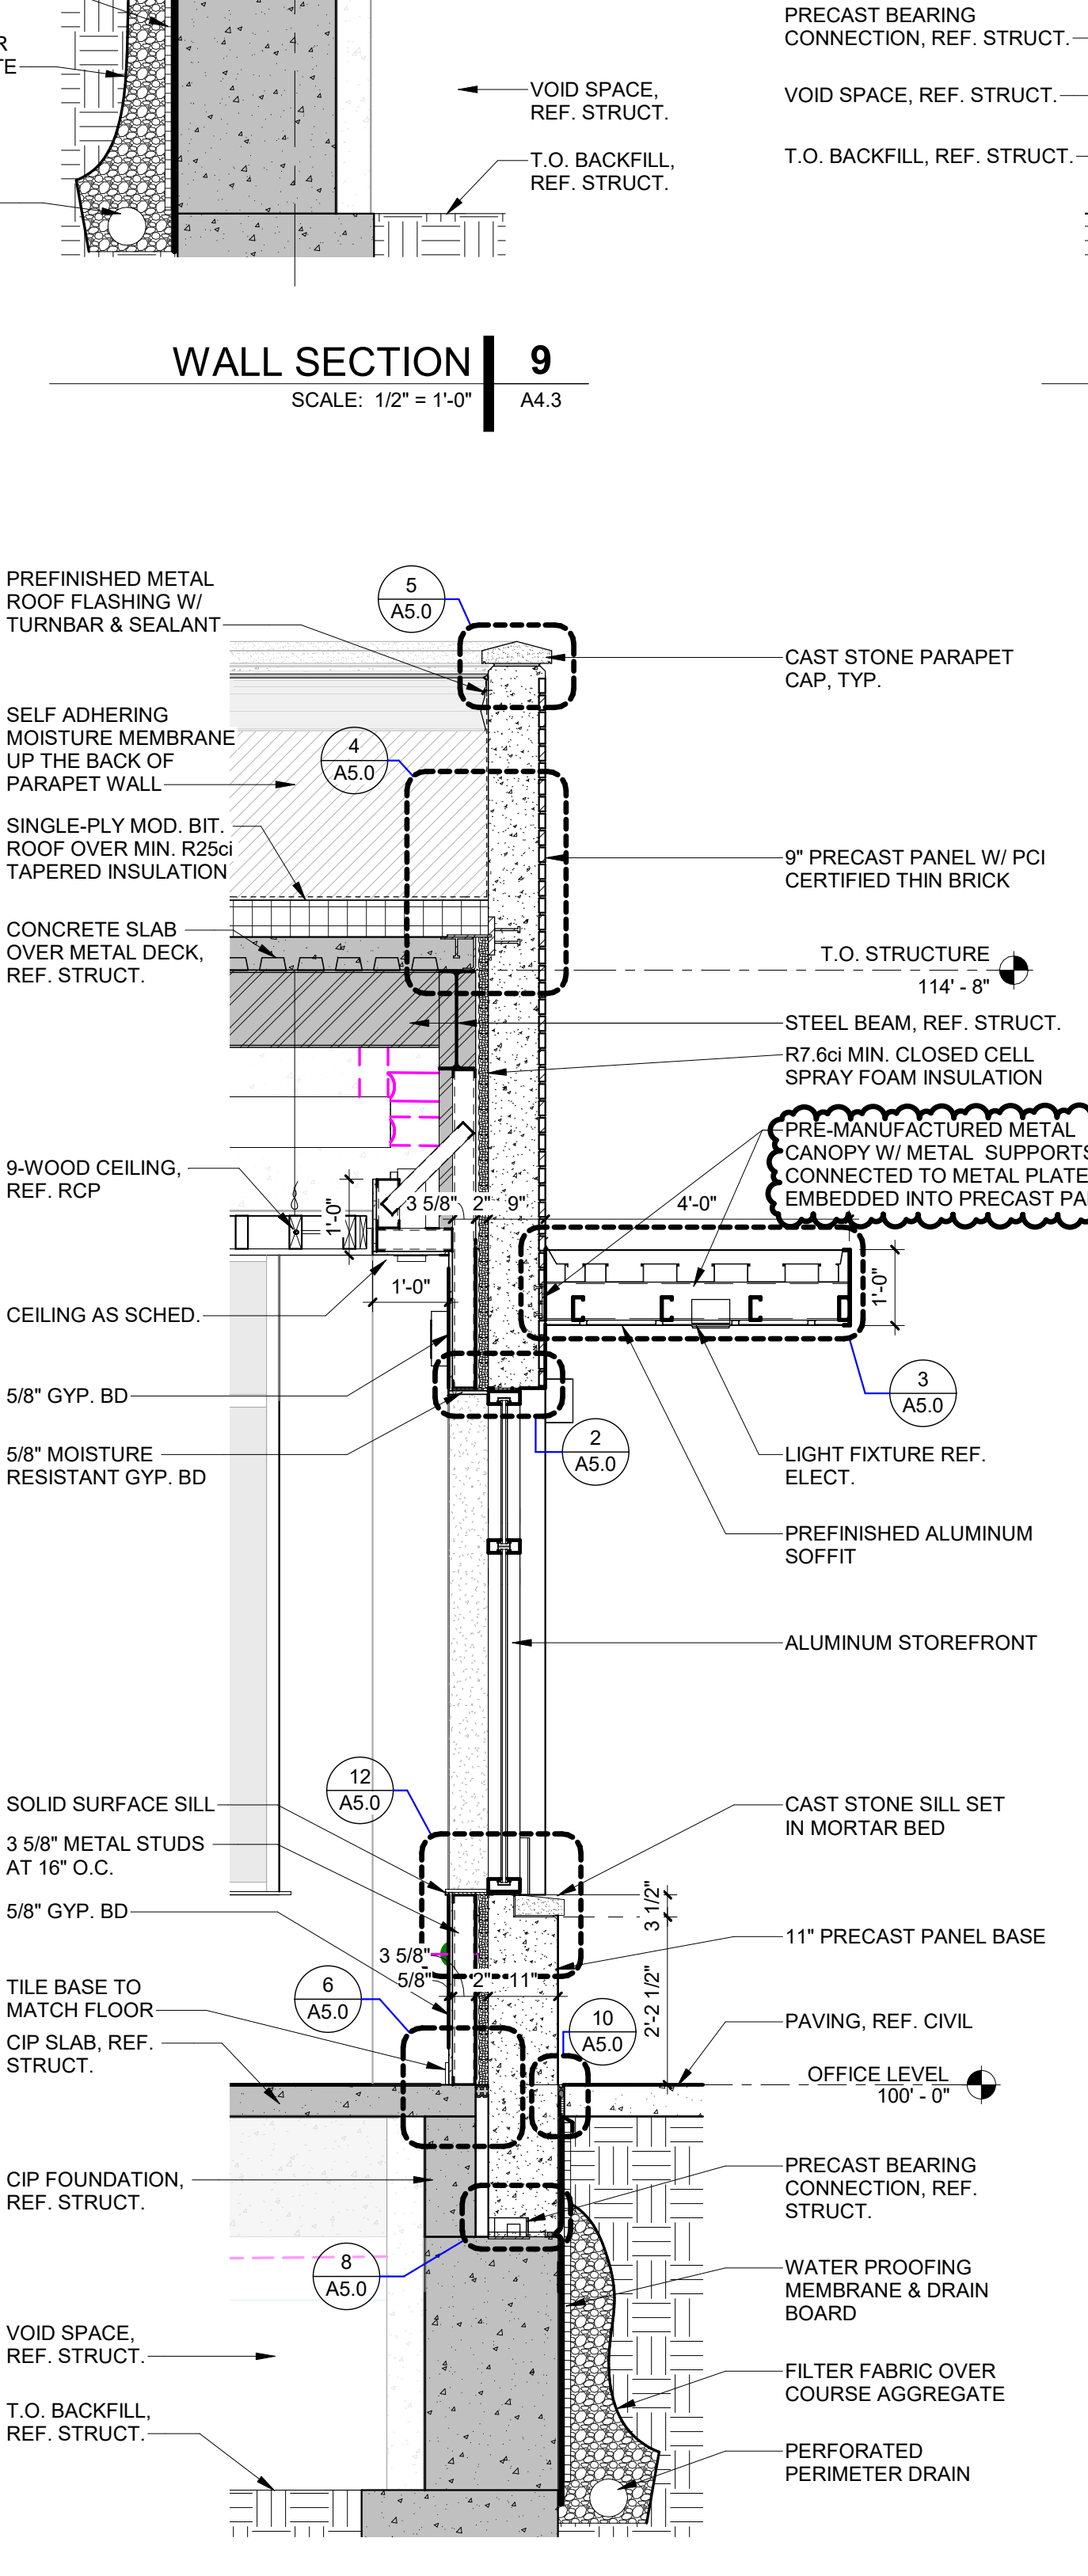

WALL SECTION 3
 SCALE: 1/2" = 1'-0"
 A4.3

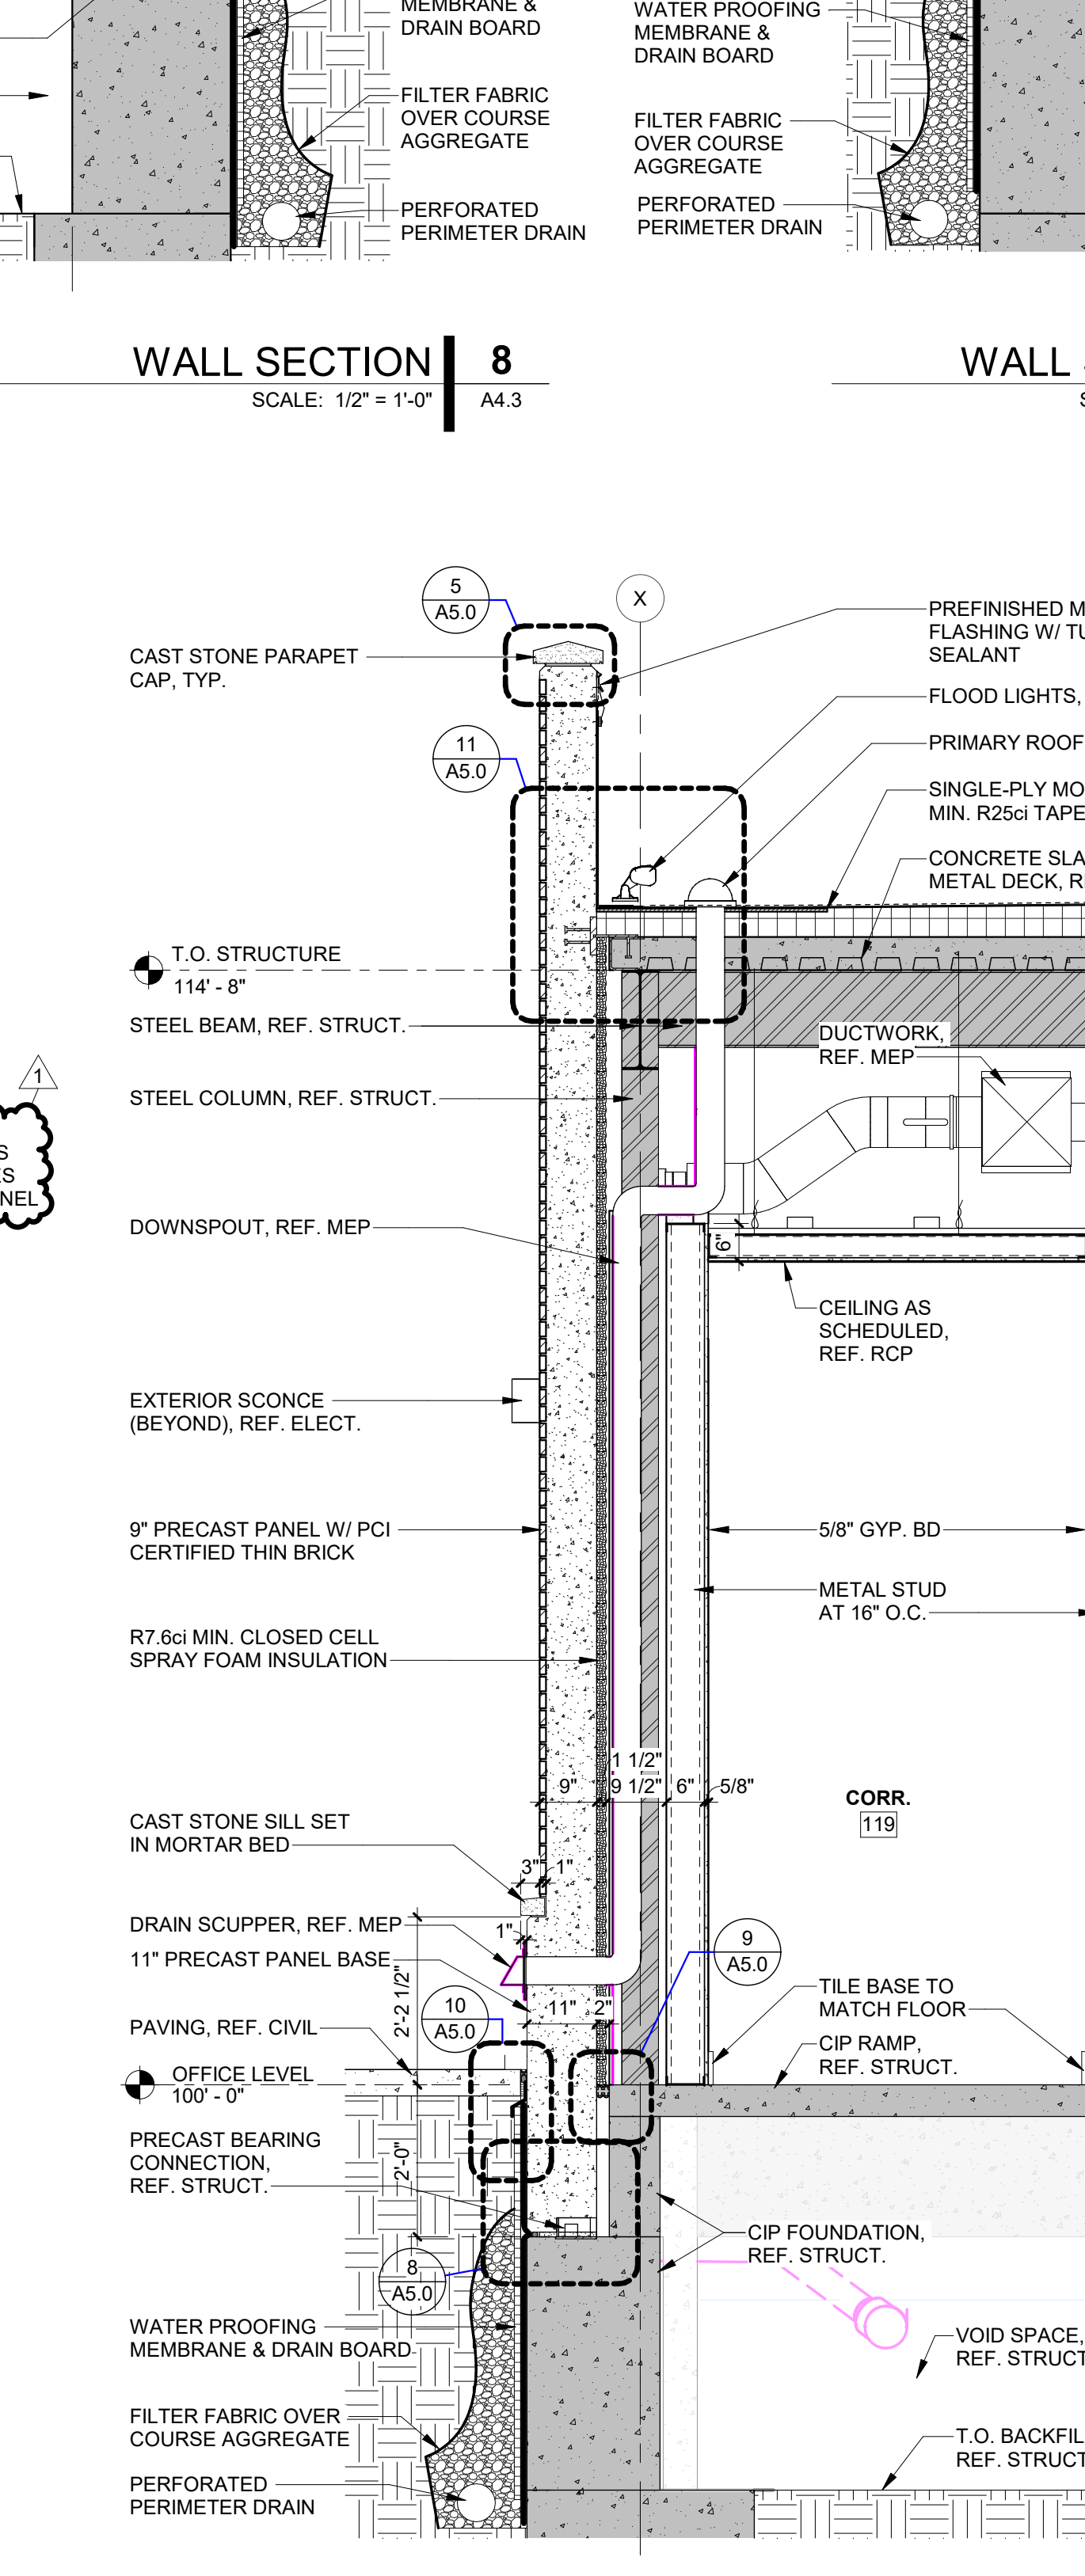

WALL SECTION 2
 SCALE: 1/2" = 1'-0"
 A4.3

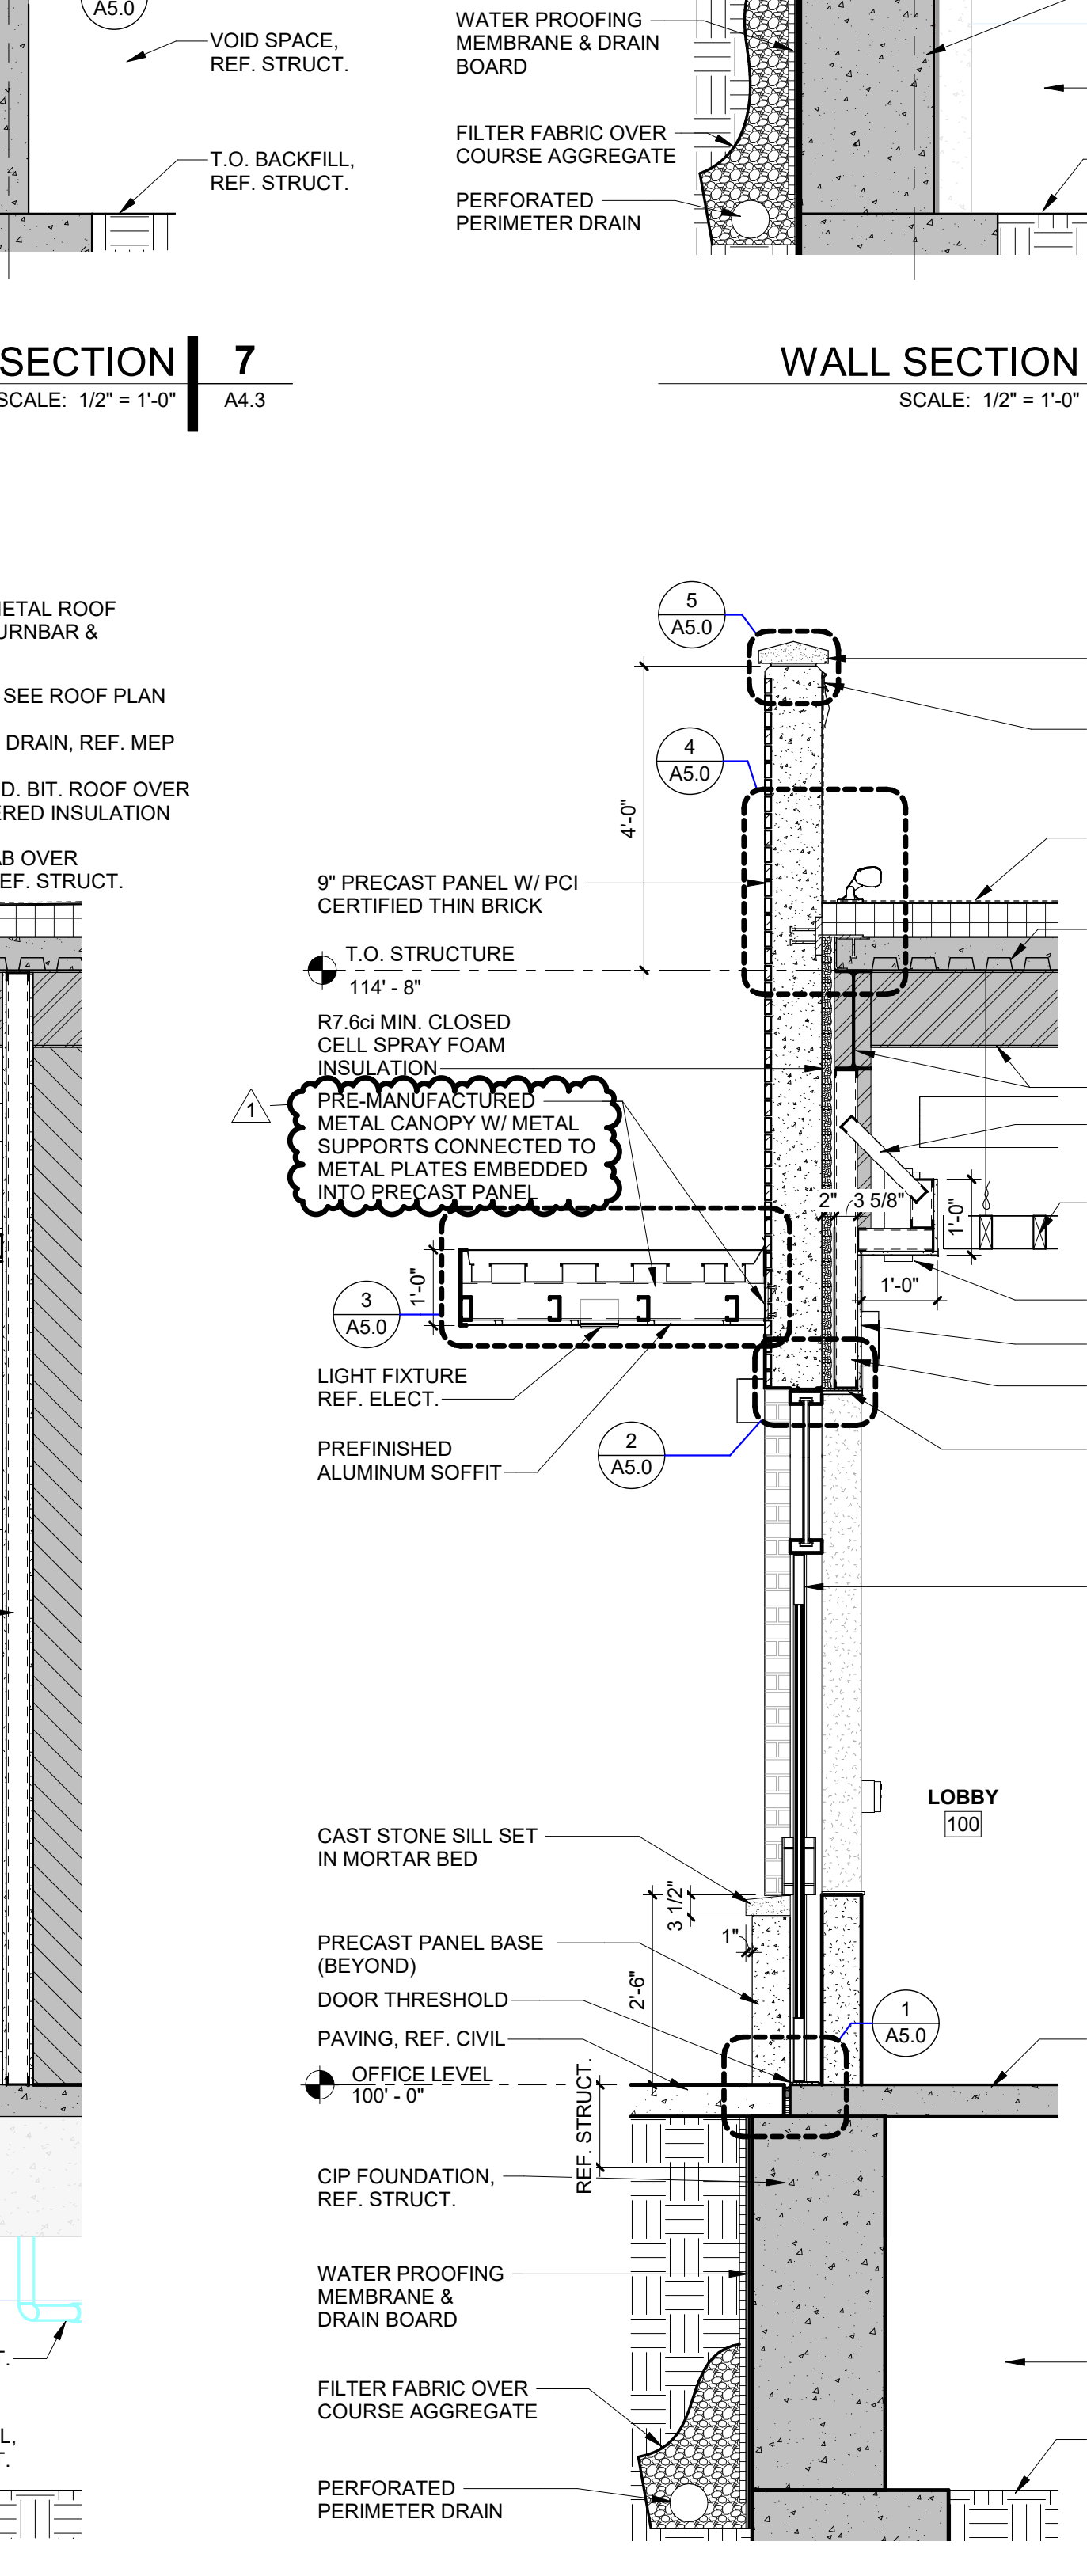

WALL SECTION 1
 SCALE: 1/2" = 1'-0"
 A4.3

A NEW FACILITY FOR
GREGG COUNTY - PARKING GARAGE & OFFICE
 100 E. METHAVIN ST.
 LONGVIEW, TX 75801



PROJECT NO.: 20011
 DATE: 03/03/2022

REVISION SCHEDULE	
Δ	Date
1	03/17/2022
ADDENDUM 04	

TIER 4	---
TIER 3	---
TIER 2	---
OFFICE/TIER G	---
SHEET NAME	SECTION DETAILS
SHEET NO.	

A5.0

SECTION DETAIL 1 SCALE: 1 1/2" = 1'-0" A5.0

SECTION DETAIL 2 SCALE: 1 1/2" = 1'-0" A5.0

SECTION DETAIL 3 SCALE: 1 1/2" = 1'-0" A5.0

SECTION DETAIL 4 SCALE: 1 1/2" = 1'-0" A5.0

SECTION DETAIL 5 SCALE: 1 1/2" = 1'-0" A5.0

SECTION DETAIL 6 SCALE: 1 1/2" = 1'-0" A5.0

SECTION DETAIL 7 SCALE: 1 1/2" = 1'-0" A5.0

SECTION DETAIL 8 SCALE: 1 1/2" = 1'-0" A5.0

SECTION DETAIL 9 SCALE: 1 1/2" = 1'-0" A5.0

SECTION DETAIL 10 SCALE: 1 1/2" = 1'-0" A5.0

SECTION DETAIL 11 SCALE: 1 1/2" = 1'-0" A5.0

SECTION DETAIL 12 SCALE: 1 1/2" = 1'-0" A5.0

SECTION DETAIL 13 SCALE: 3" = 1'-0" A5.0

SECTION DETAIL 14 SCALE: 3" = 1'-0" A5.0

SECTION DETAIL 15 SCALE: 1 1/2" = 1'-0" A5.0

SECTION DETAIL 16 SCALE: 1 1/2" = 1'-0" A5.0

SECTION DETAIL 17 SCALE: 1 1/2" = 1'-0" A5.0

SECTION DETAIL 18 SCALE: 1 1/2" = 1'-0" A5.0

SECTION DETAIL 19 SCALE: 1 1/2" = 1'-0" A5.0

SECTION DETAIL 20 SCALE: 1 1/2" = 1'-0" A5.0

SECTION DETAIL 21 SCALE: 1 1/2" = 1'-0" A5.0

SECTION DETAIL 22 SCALE: 1 1/2" = 1'-0" A5.0

SECTION DETAIL 23 SCALE: 1 1/2" = 1'-0" A5.0

SECTION DETAIL 24 SCALE: 1 1/2" = 1'-0" A5.0

SECTION DETAIL 25 SCALE: 1 1/2" = 1'-0" A5.0


SECTION DETAIL 26 SCALE: 1 1/2" = 1'-0" A5.0

SECTION DETAIL 27 SCALE: 1 1/2" = 1'-0" A5.0

SECTION DETAIL 28 SCALE: 1 1/2" = 1'-0" A5.0

SECTION DETAIL 29 SCALE: 1 1/2" = 1'-0" A5.0

A NEW FACILITY FOR
**GREGG COUNTY - PARKING
GARAGE & OFFICE**
100 E. METHUEN ST.
LONGVIEW, TX 75601

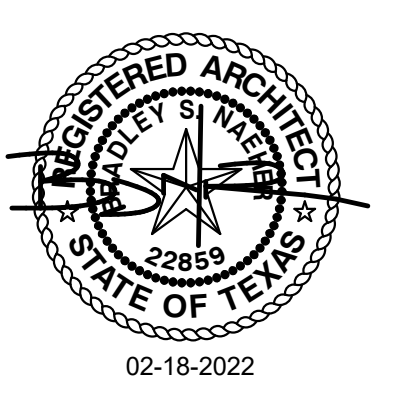











































PROJECT NO.: 20011
DATE: 03/03/2022

REVISION SCHEDULE	
A. Description	Date
1. ADDENDUM 04	03-17-2022


TIER 4	_____
TIER 3	_____
TIER 2	_____
OFFICE/TIER 0	_____
SHEET NAME	
PLAN DETAILS	
SHEET NO.	

A5.5

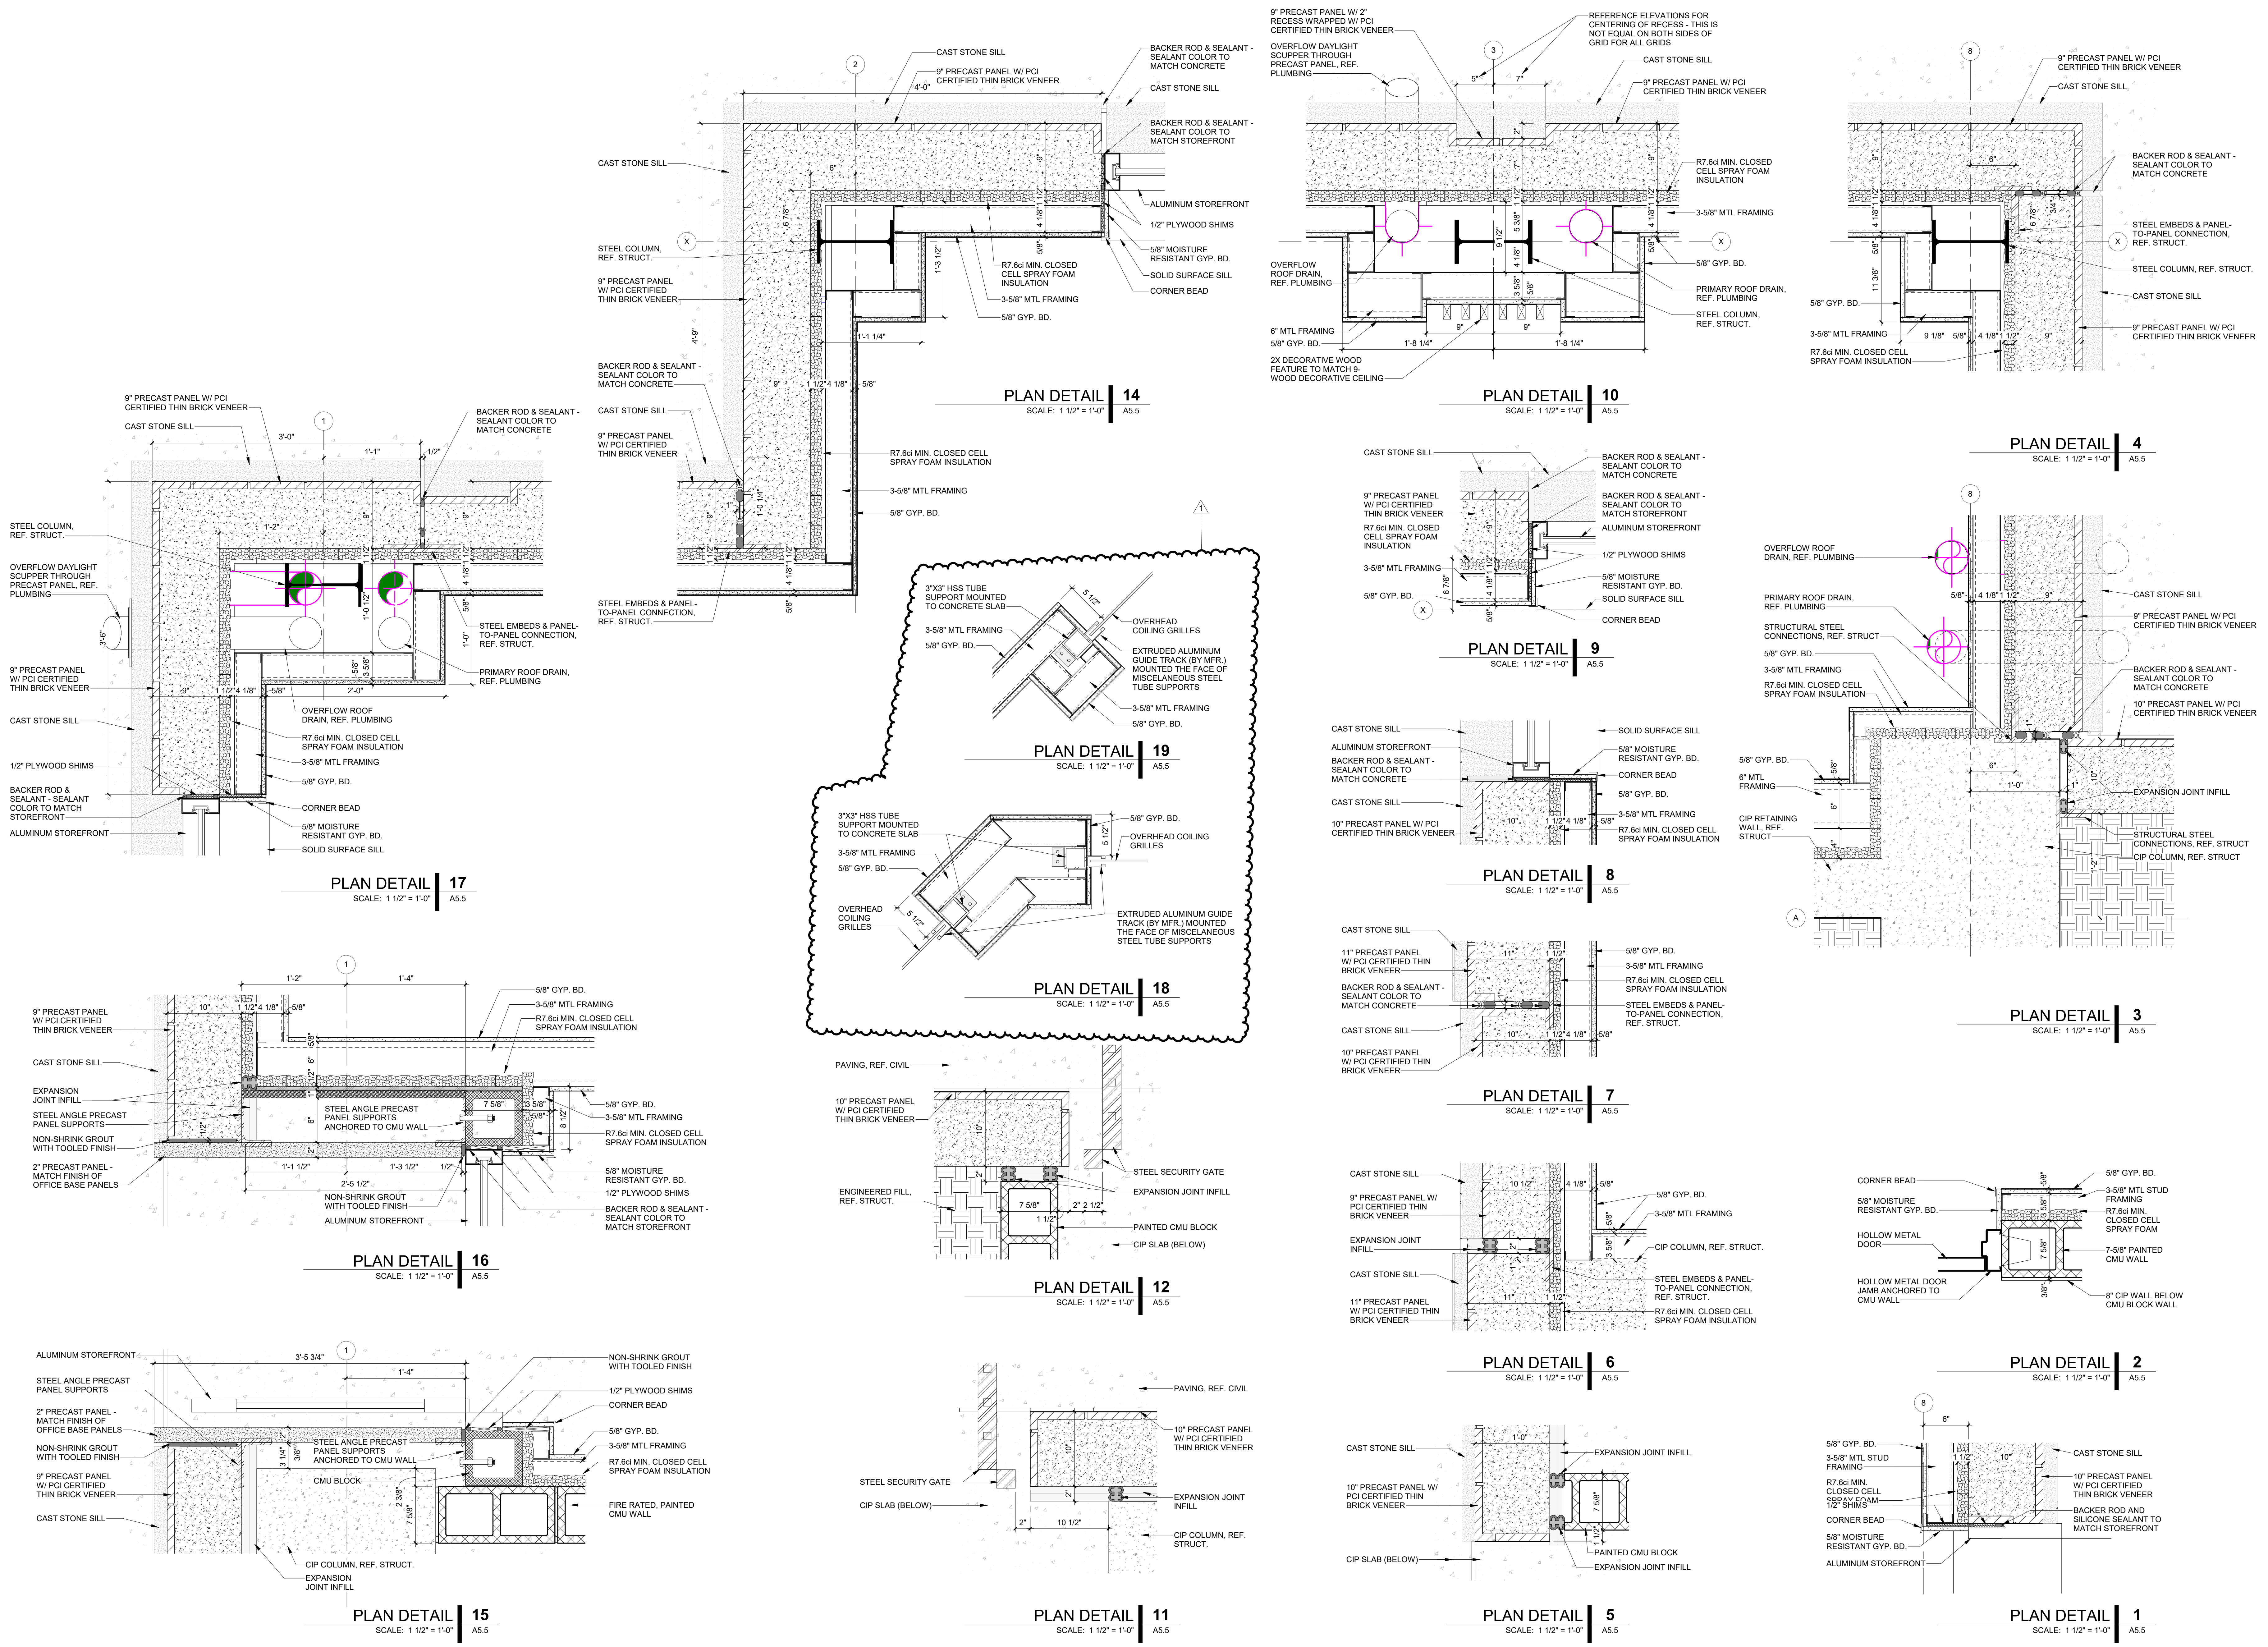

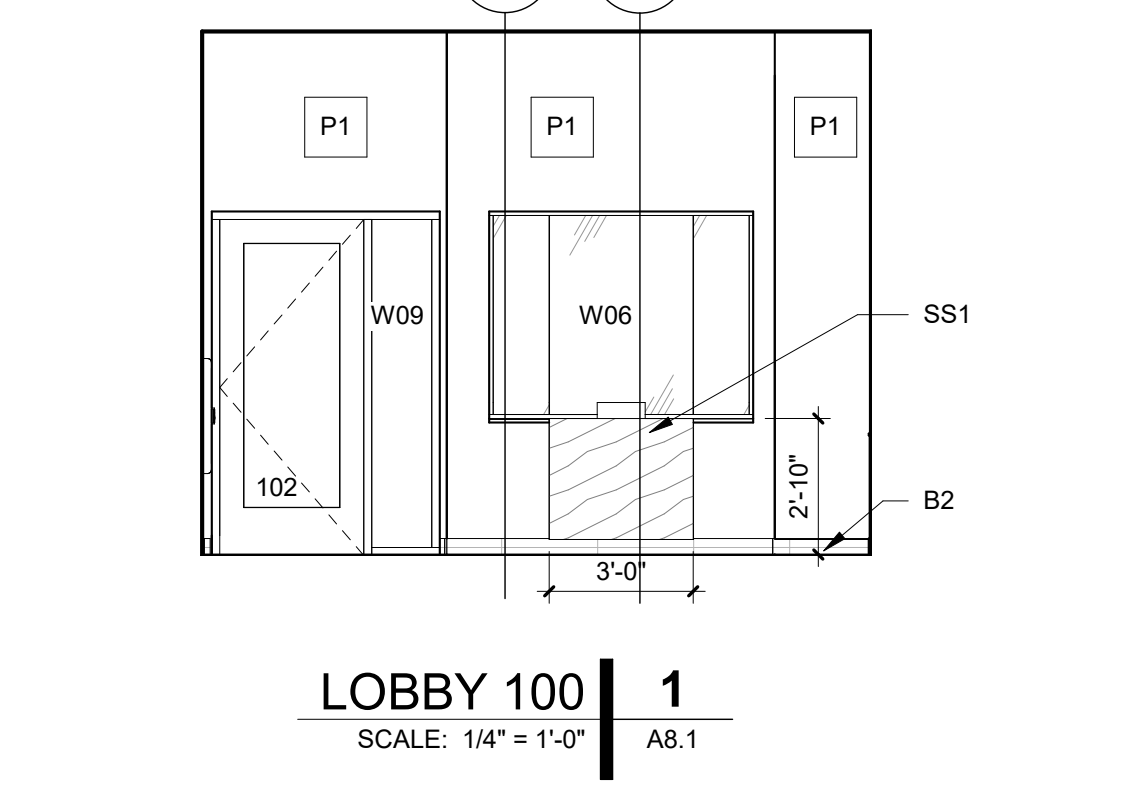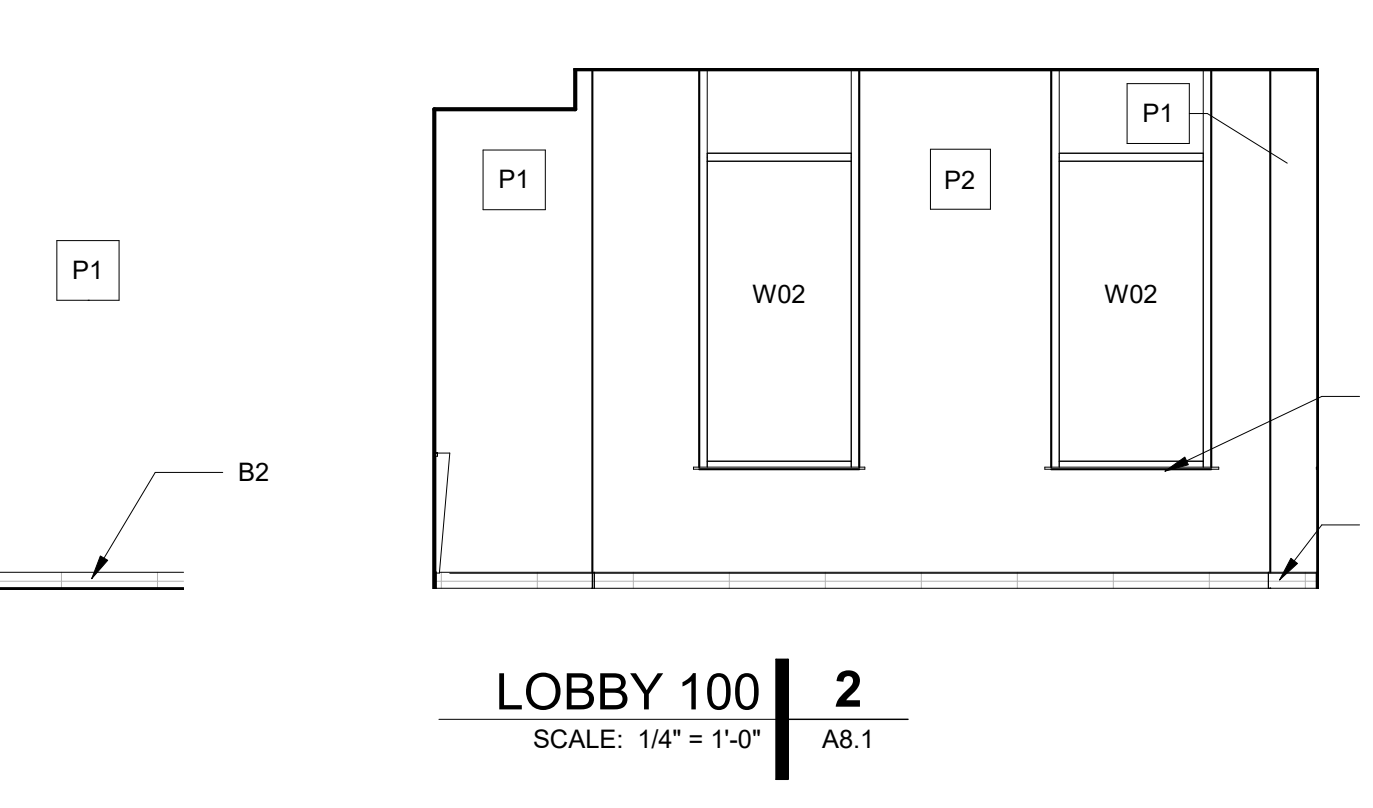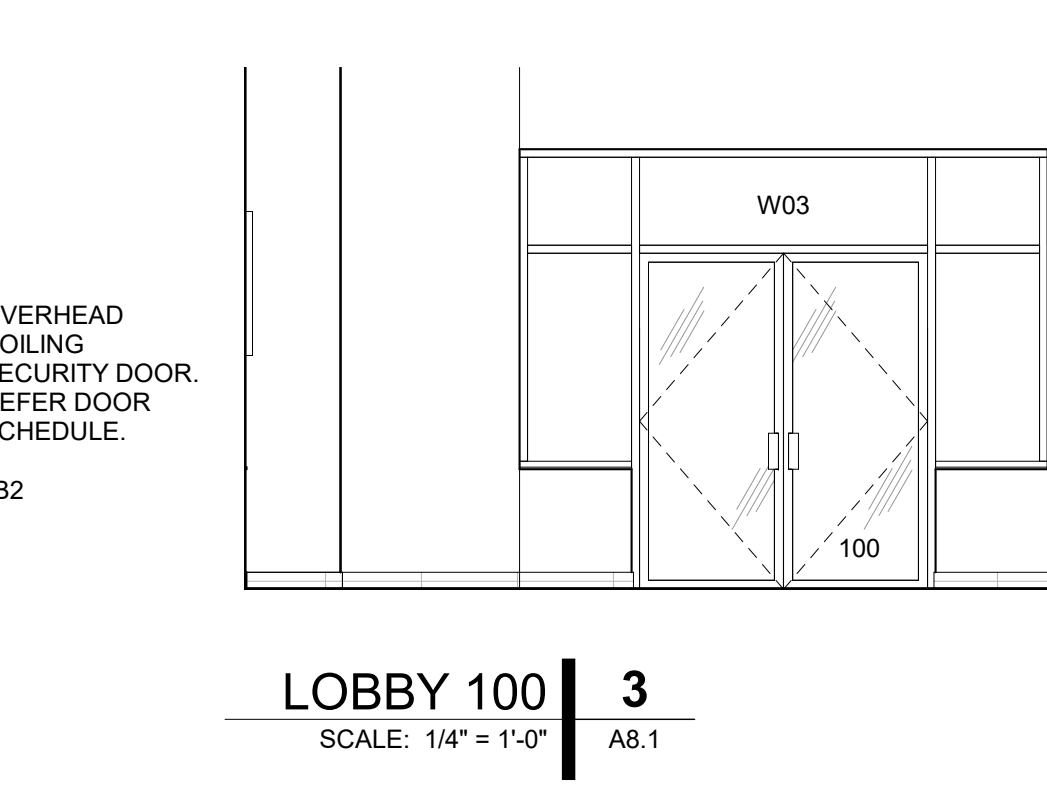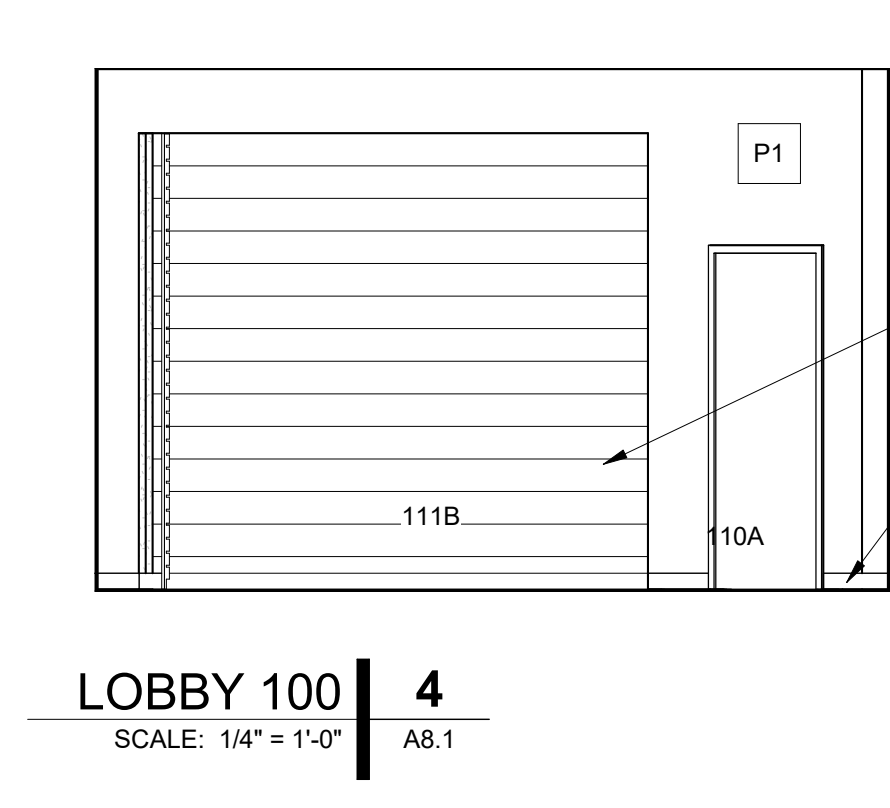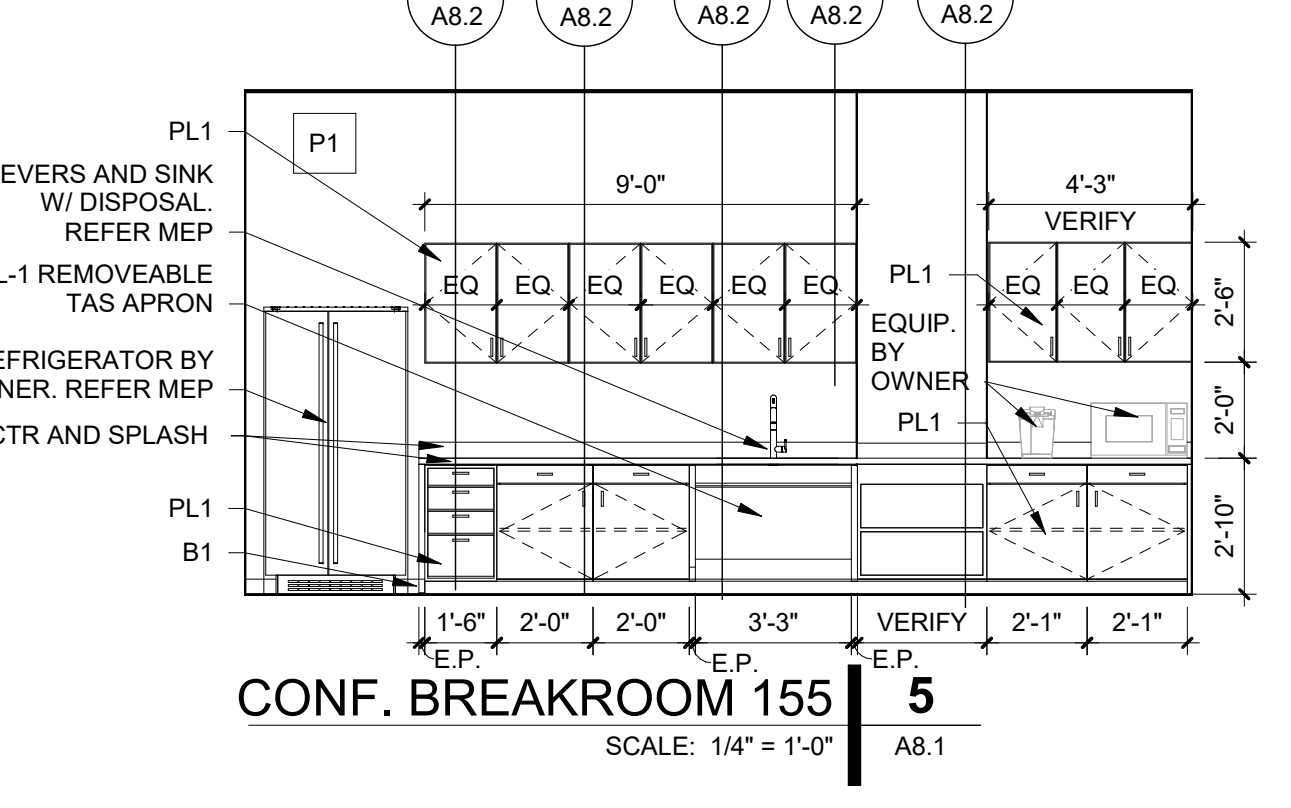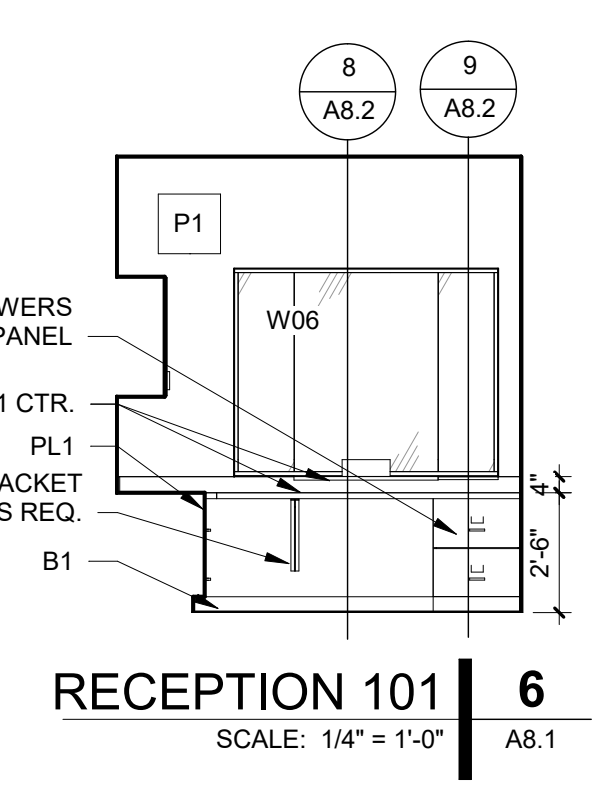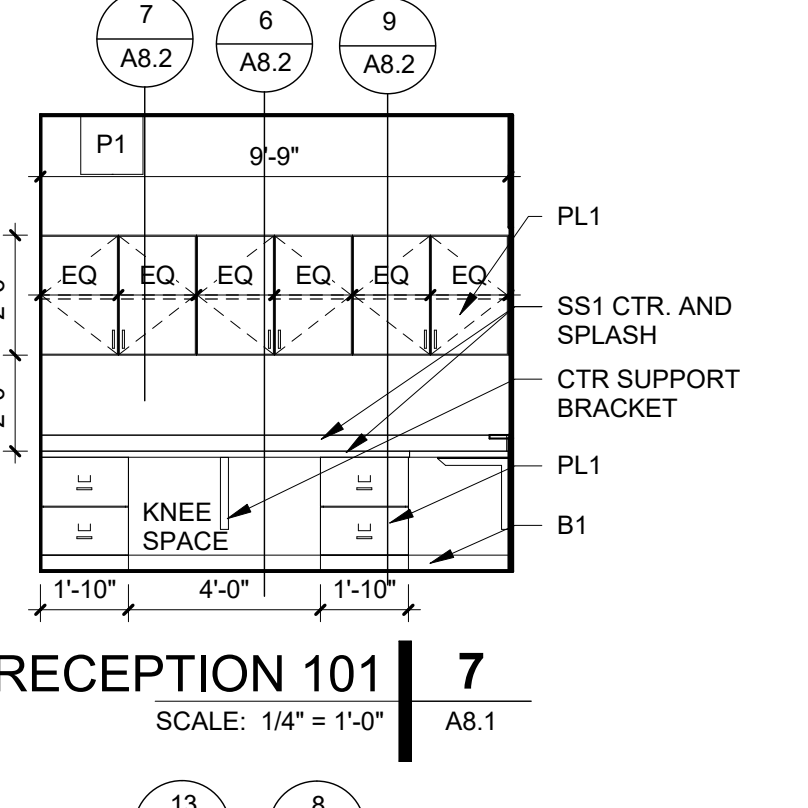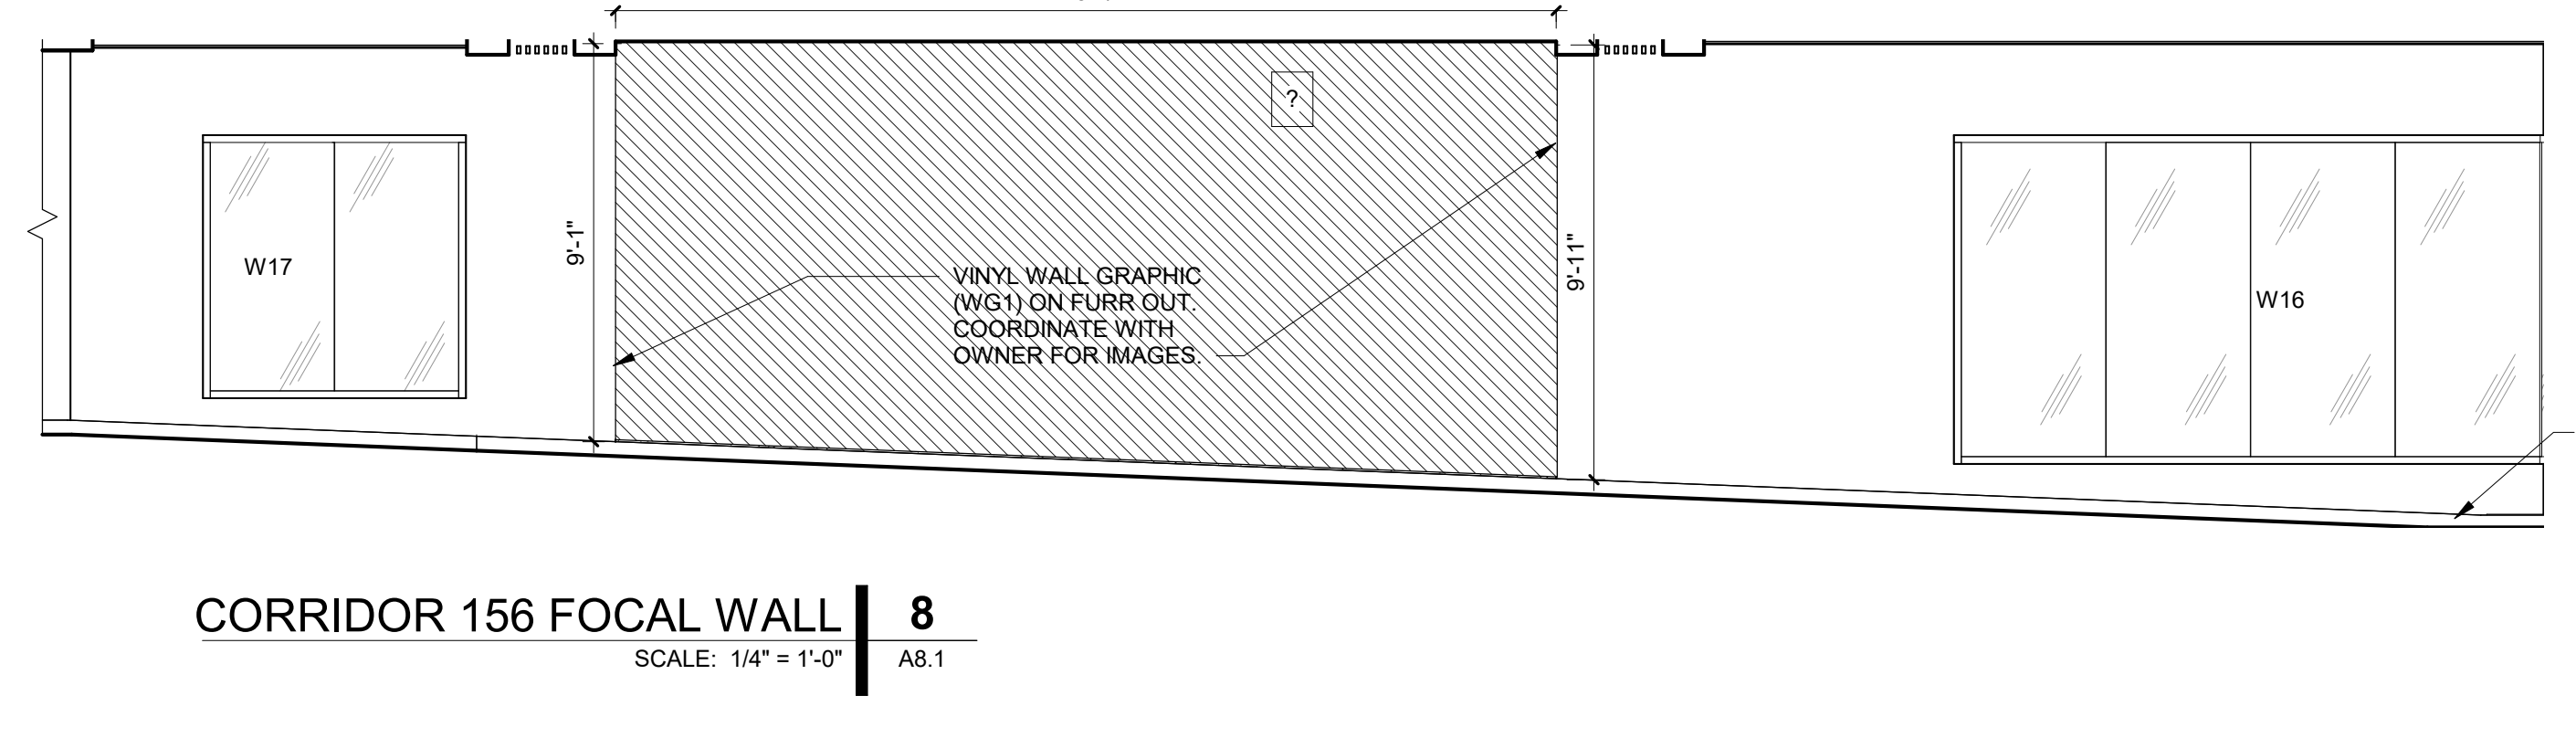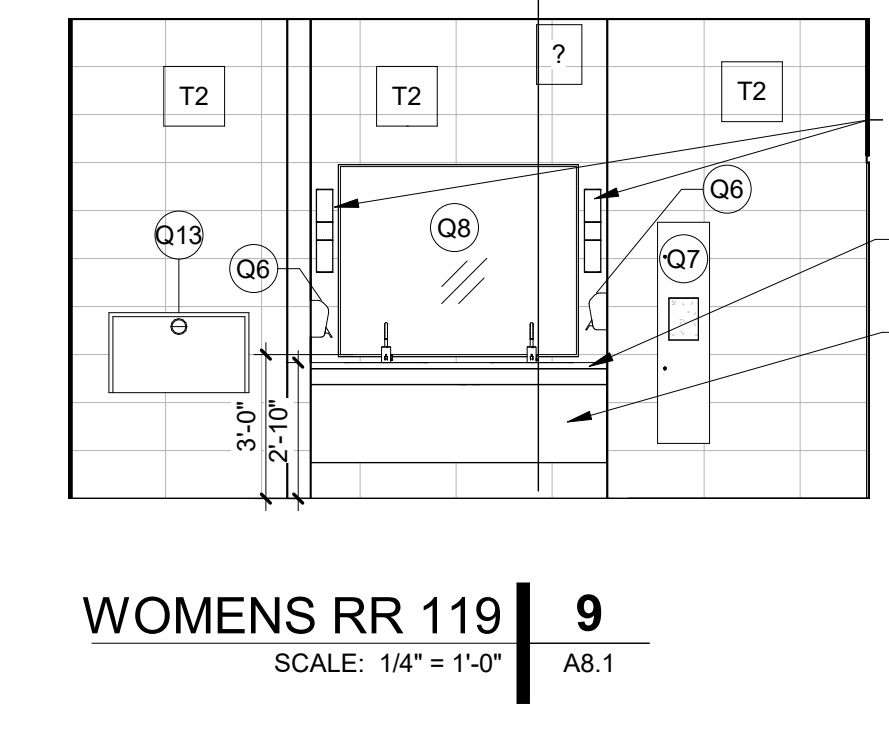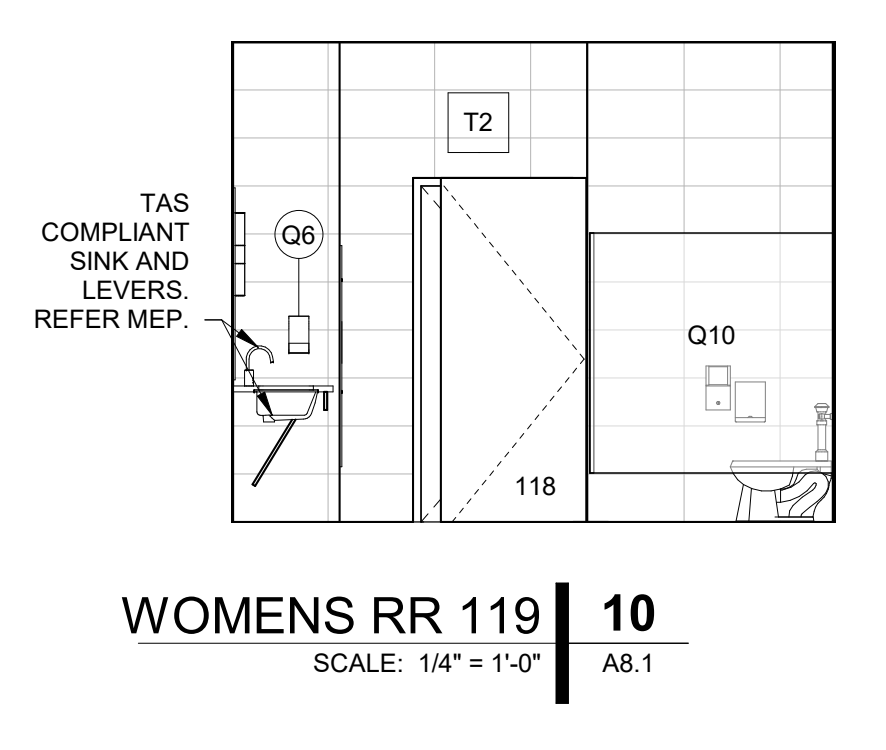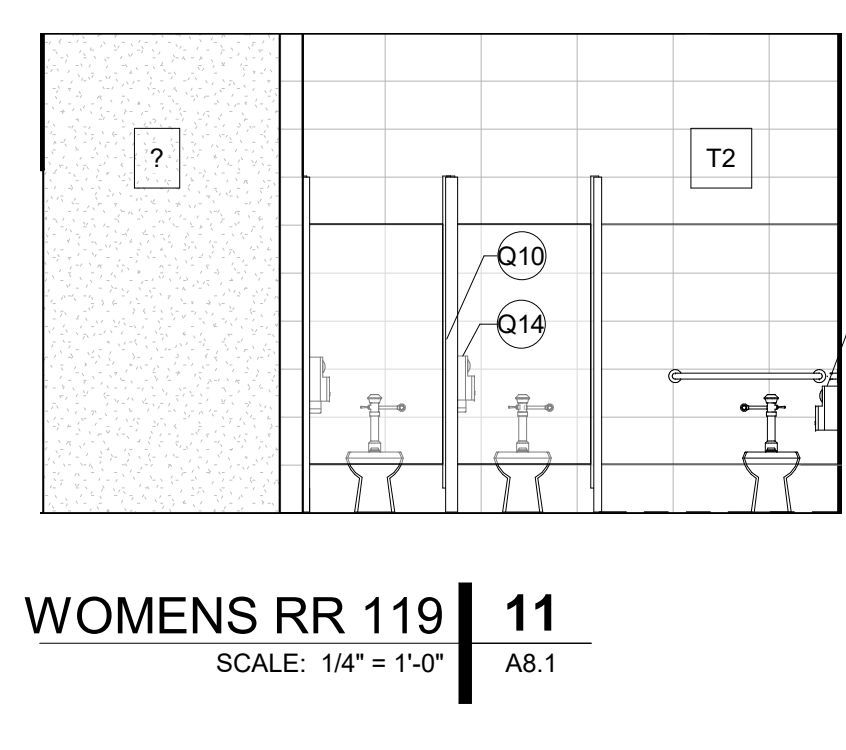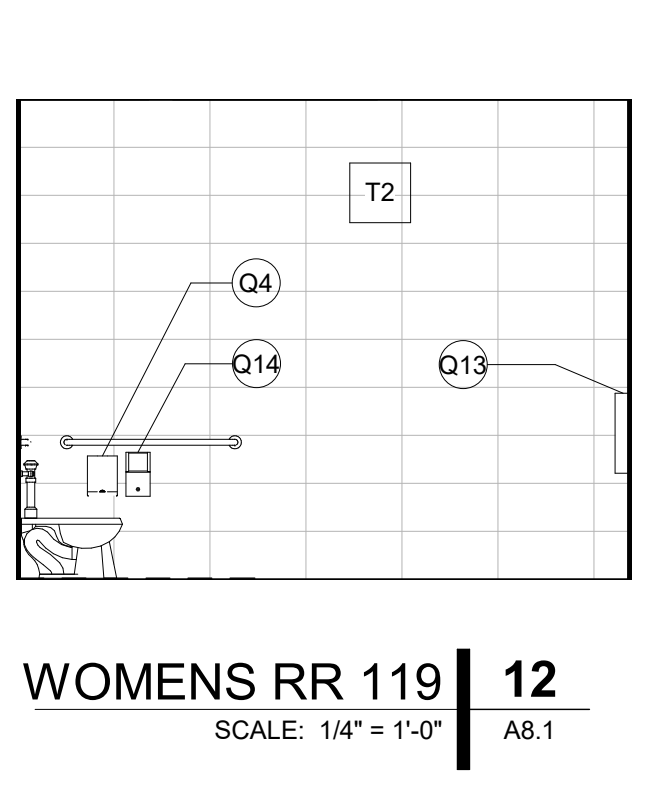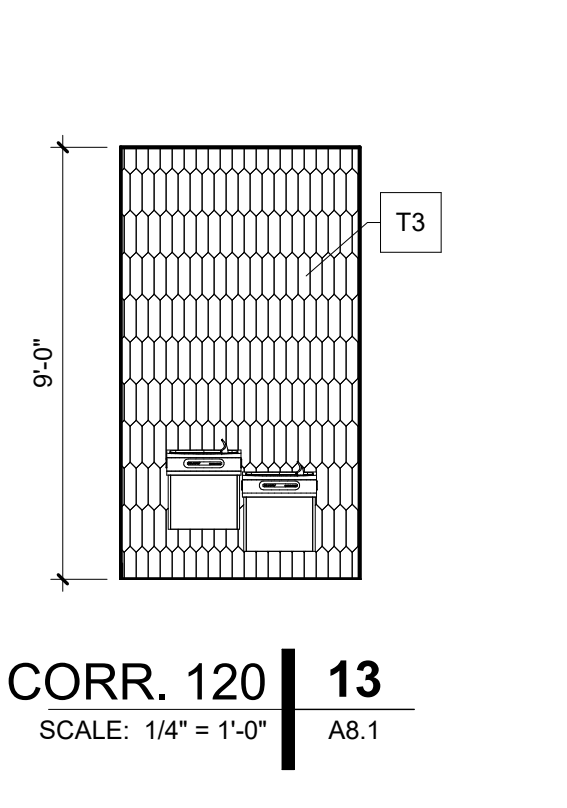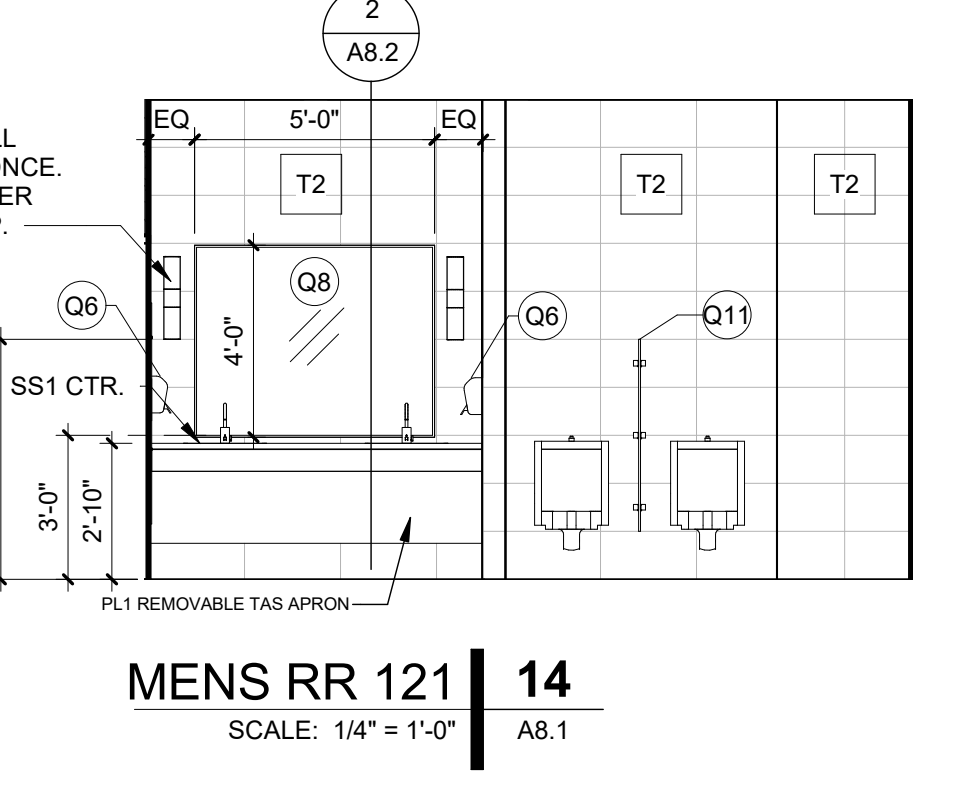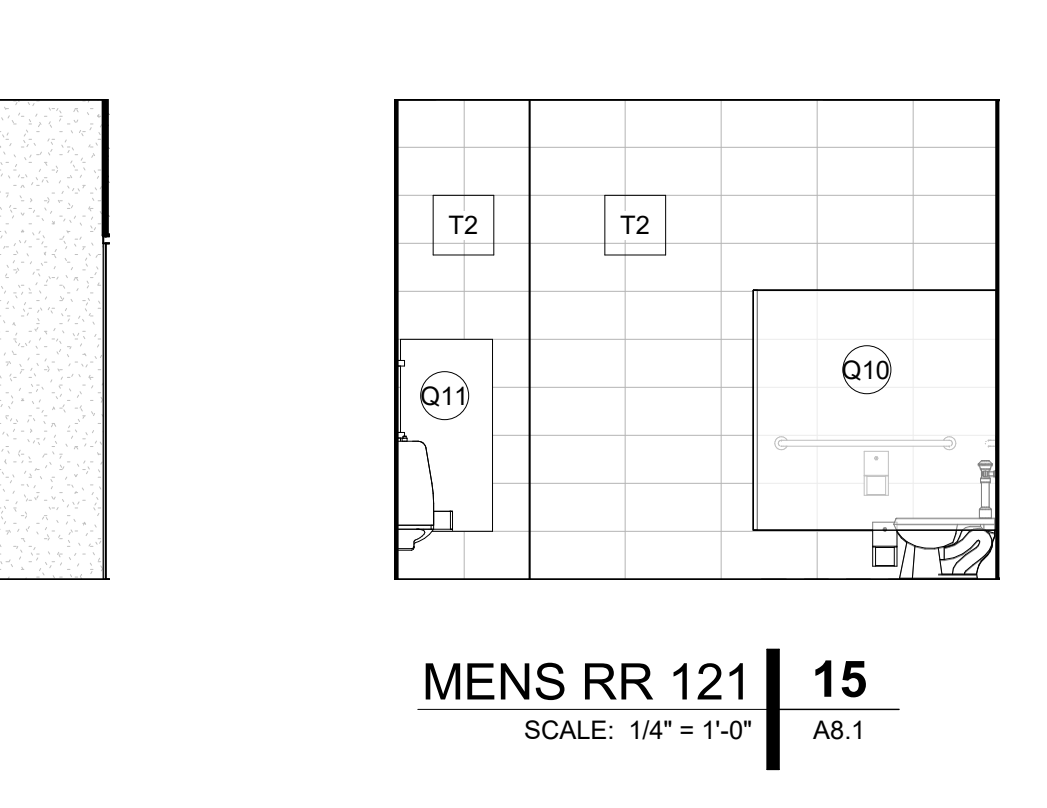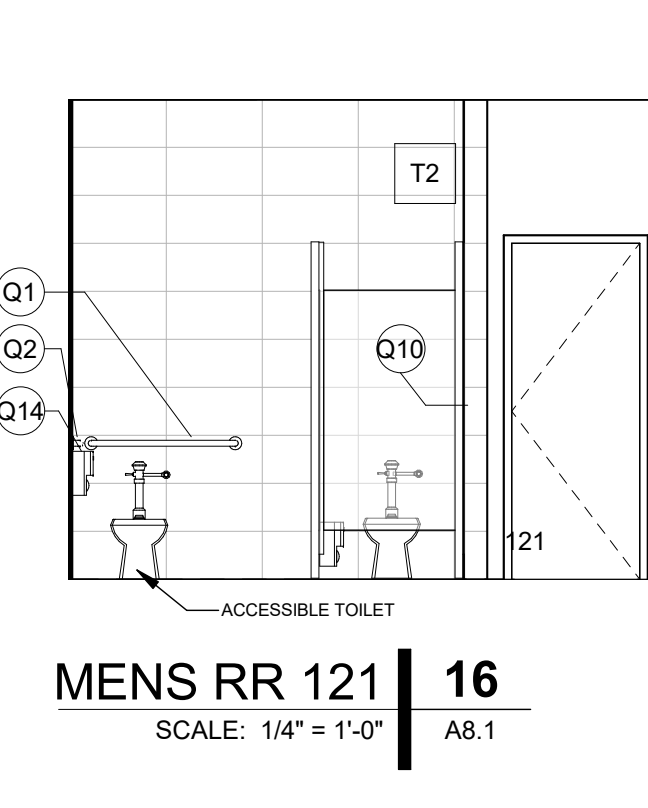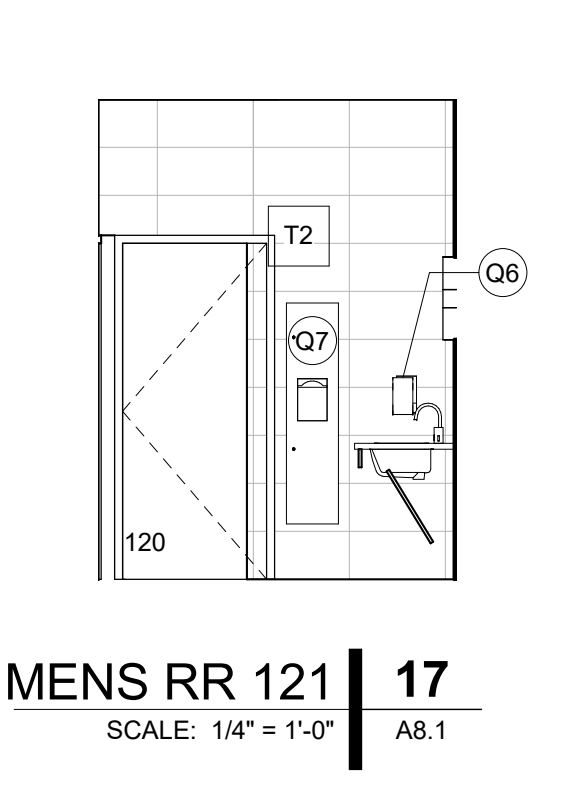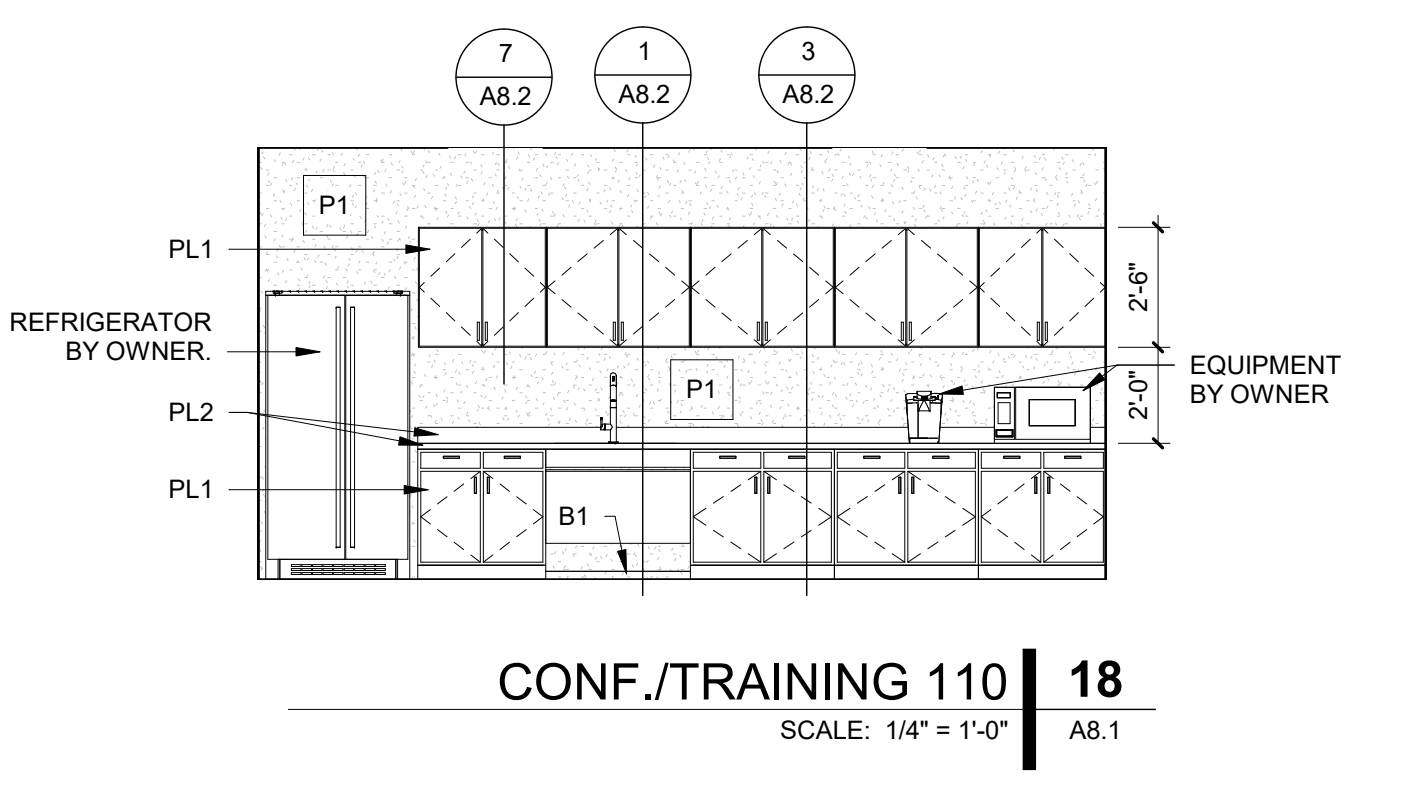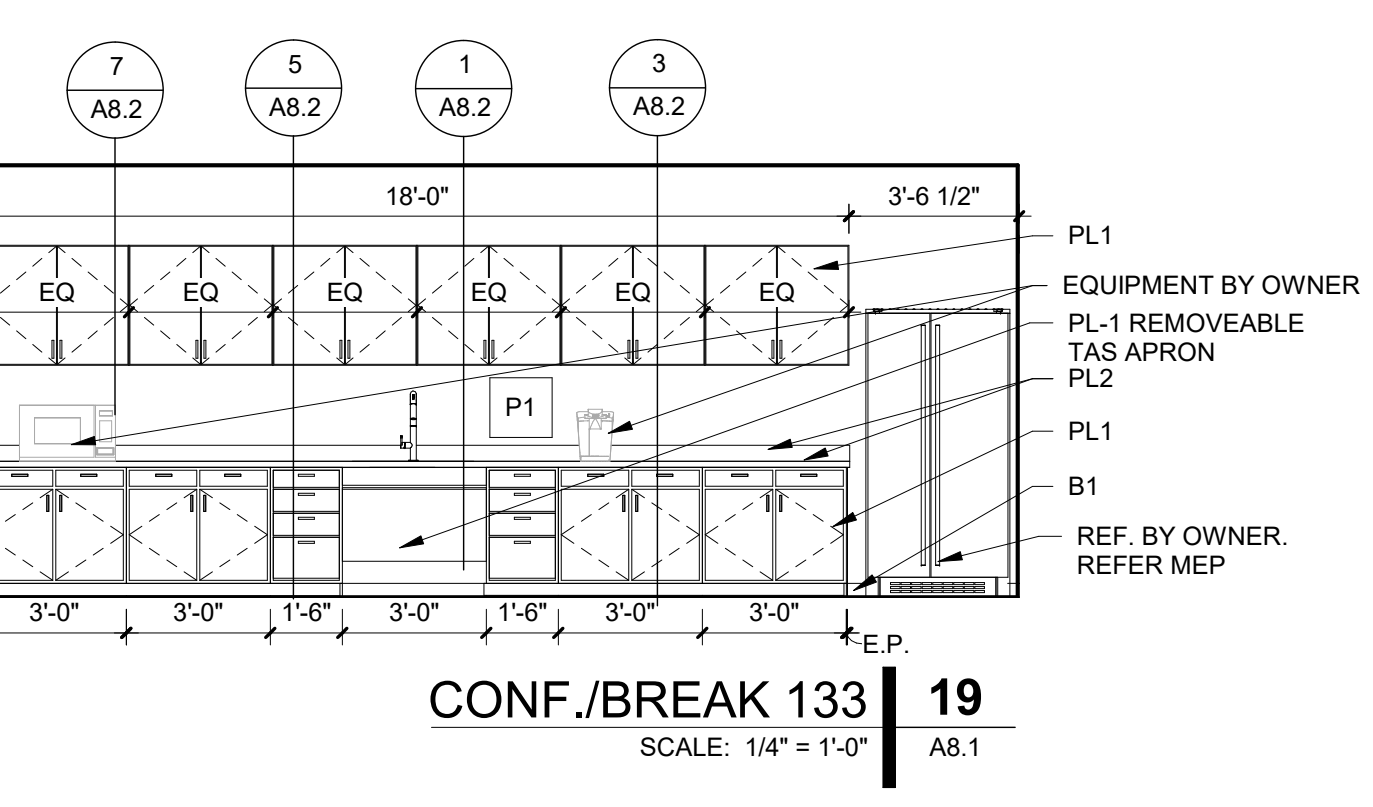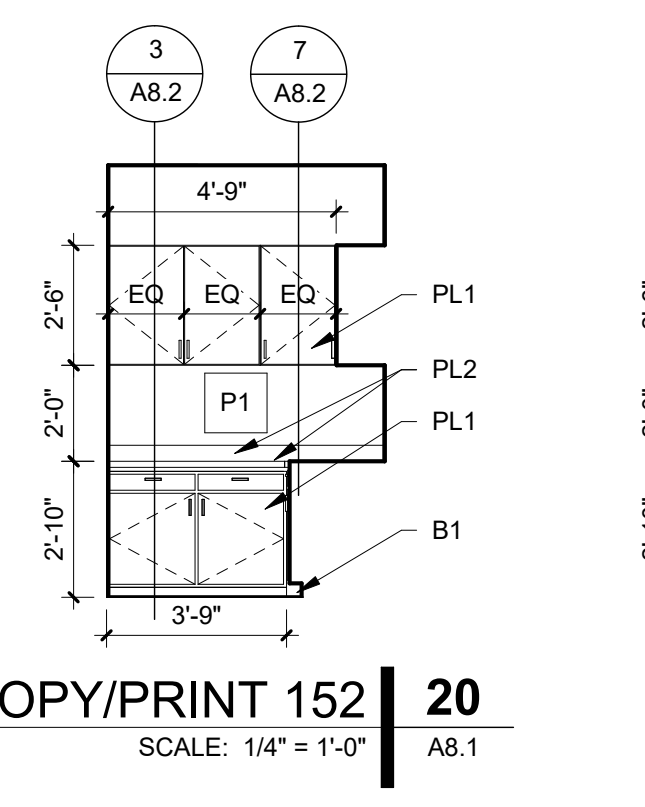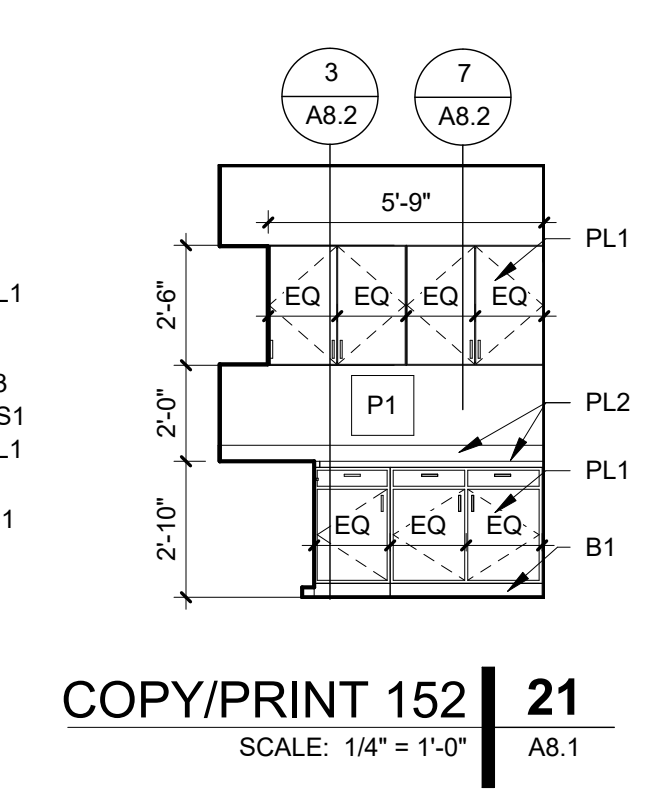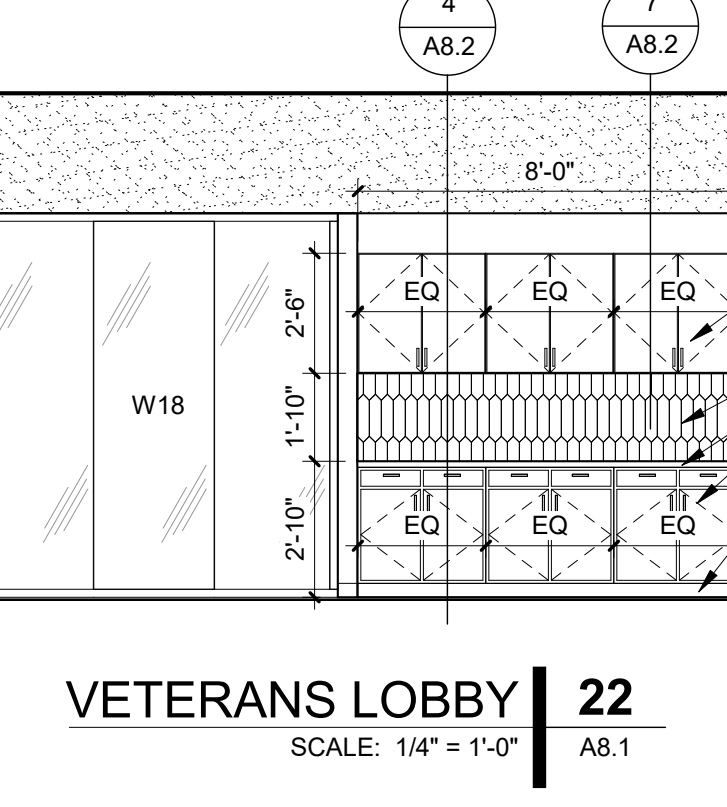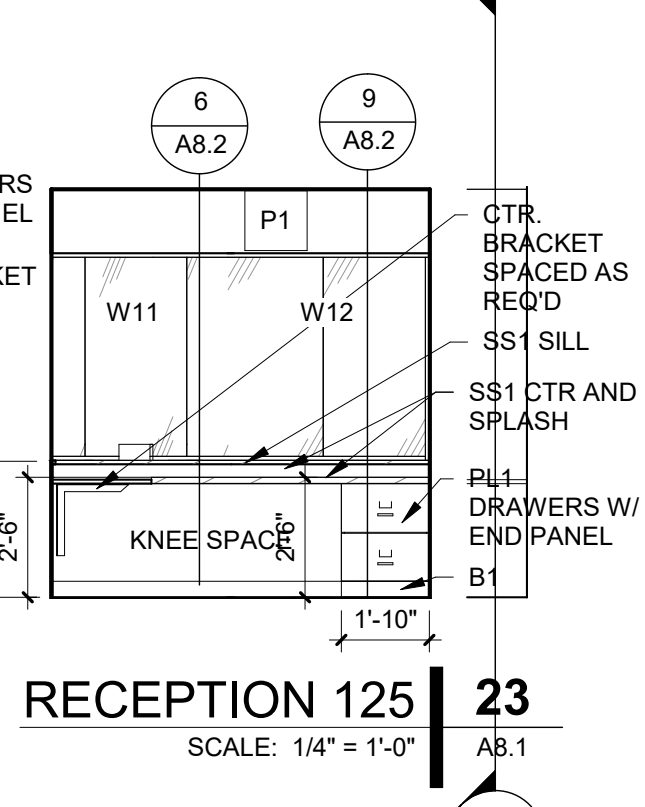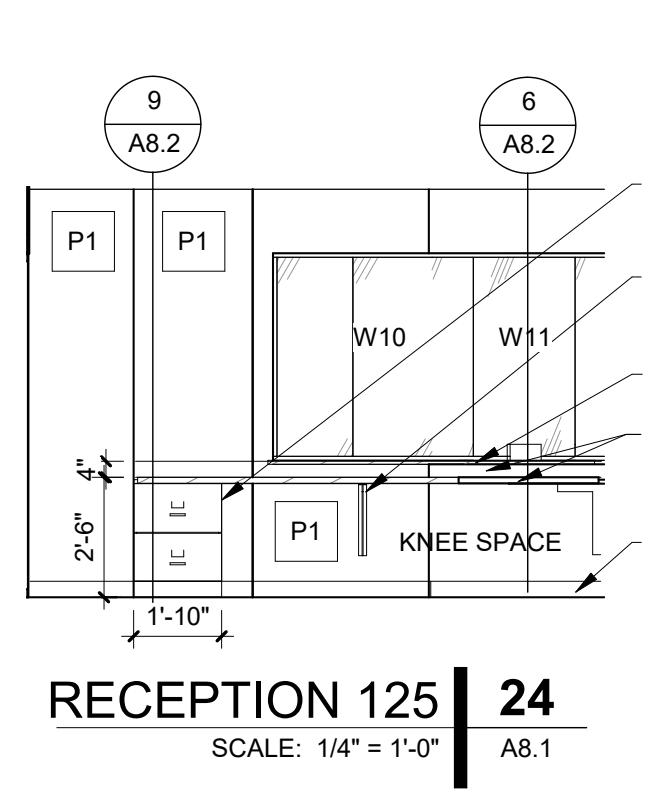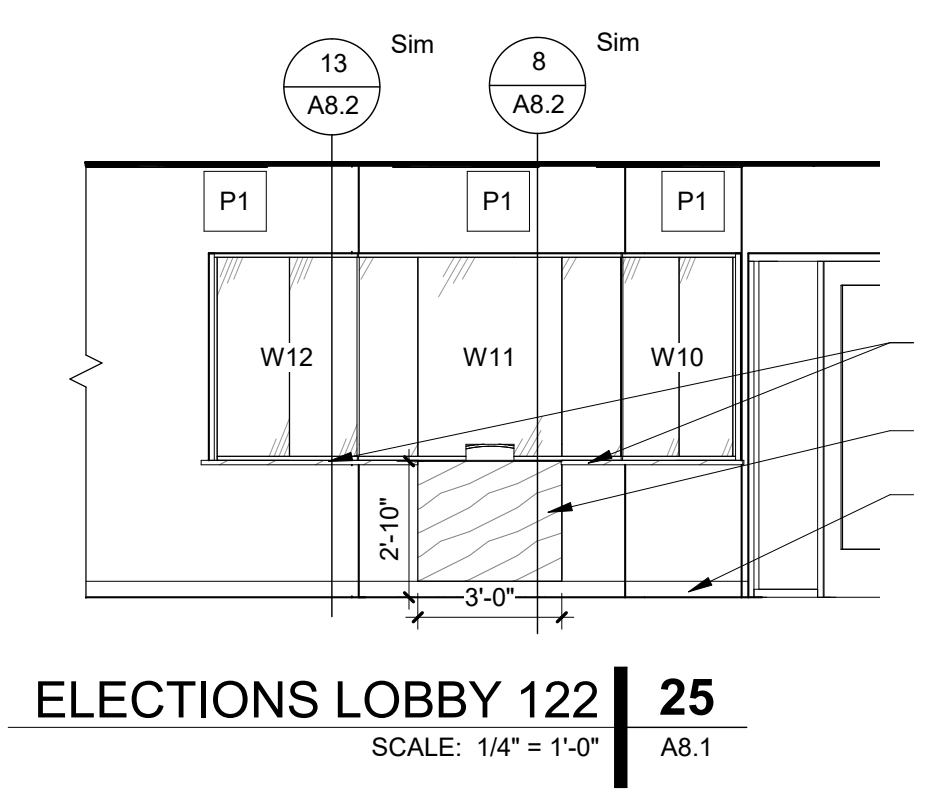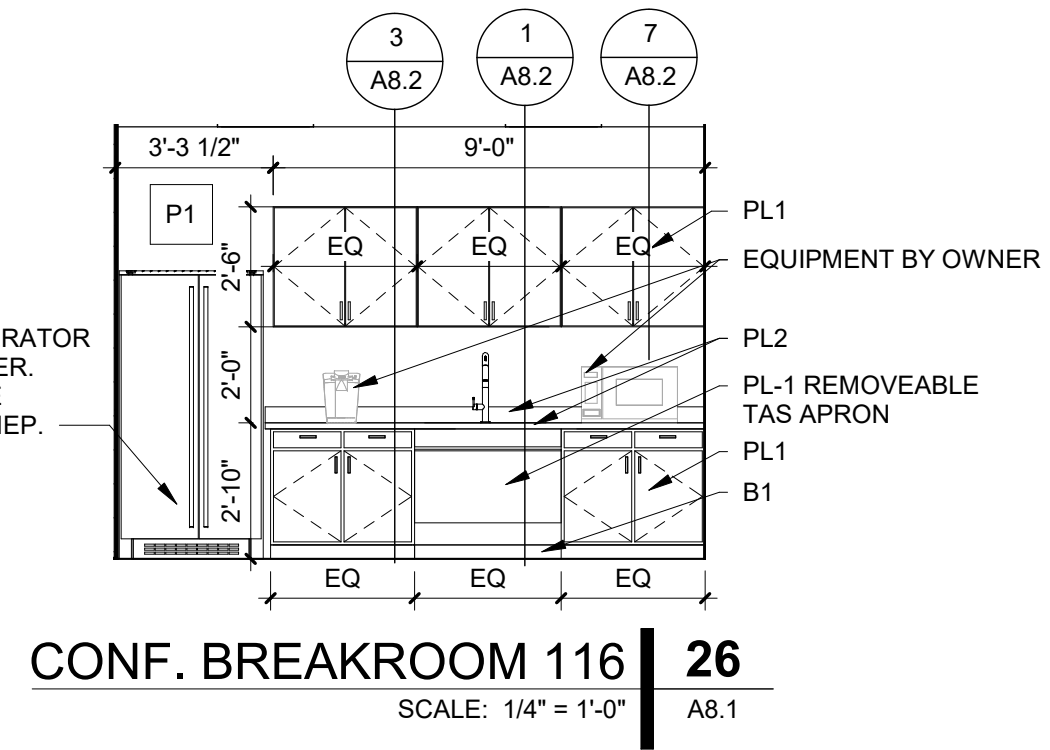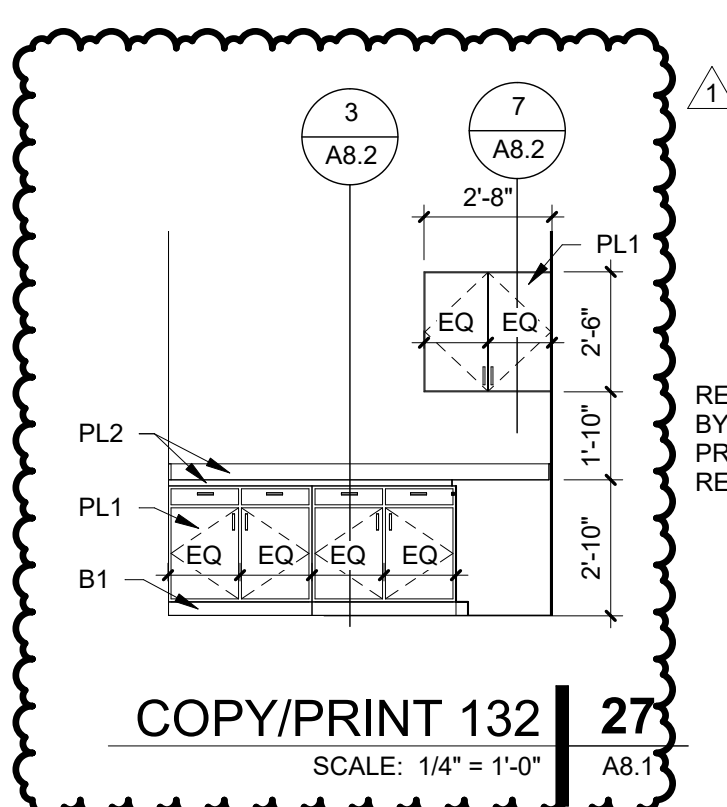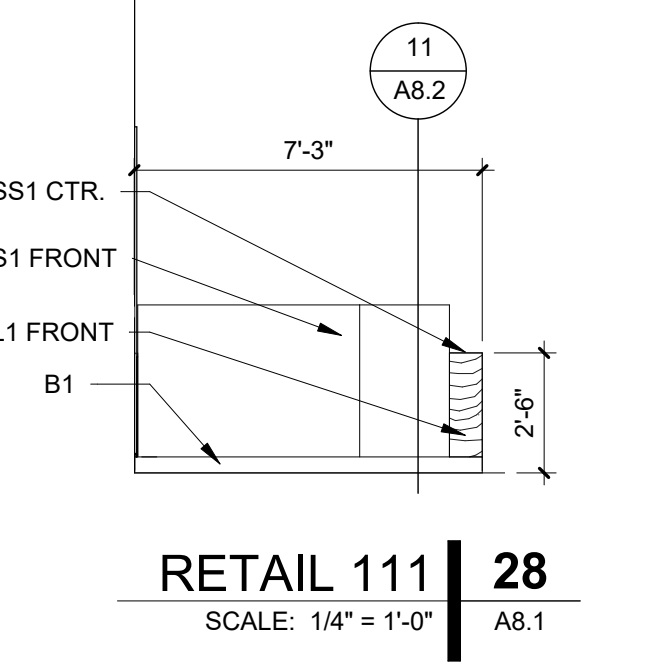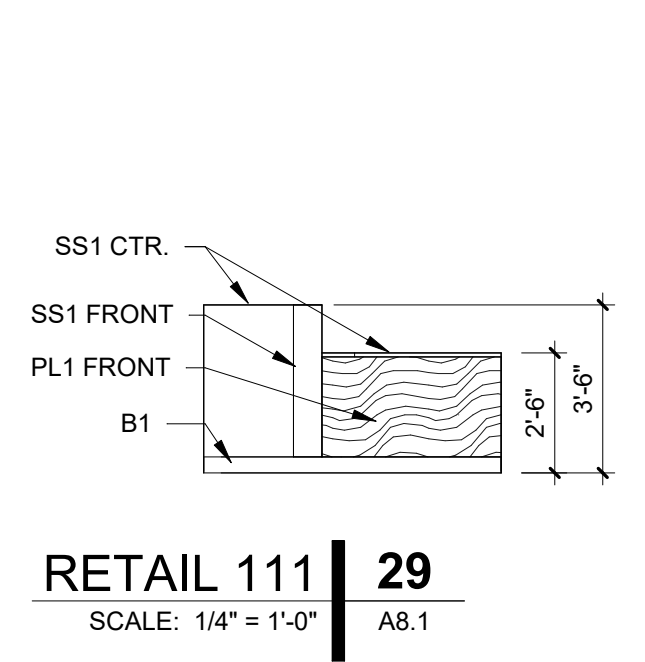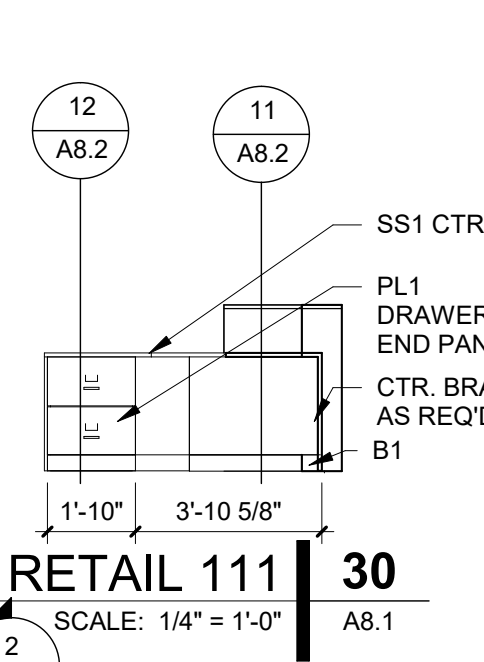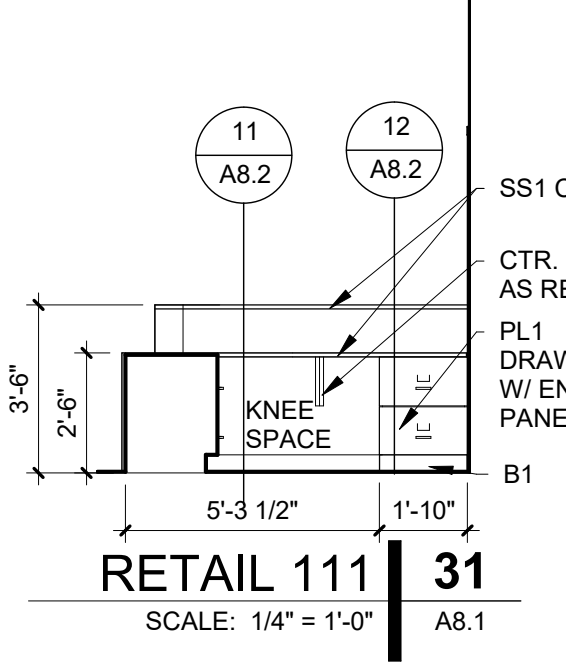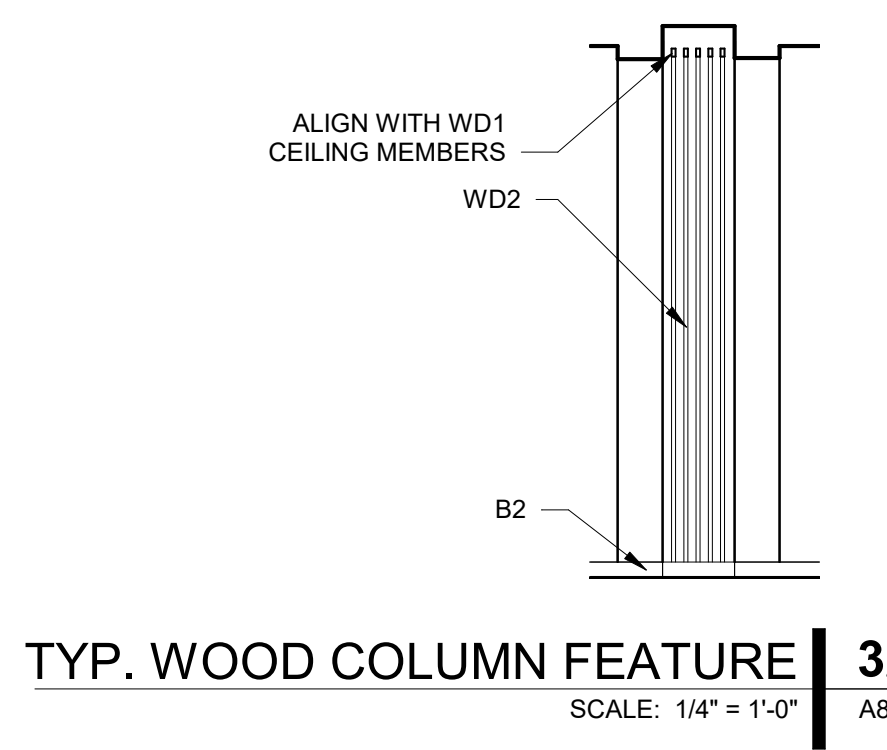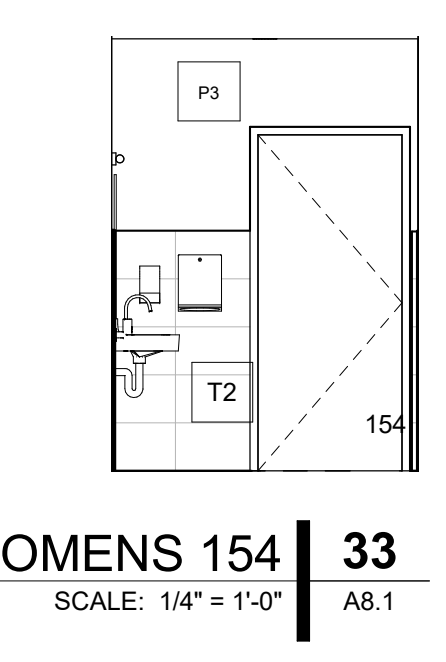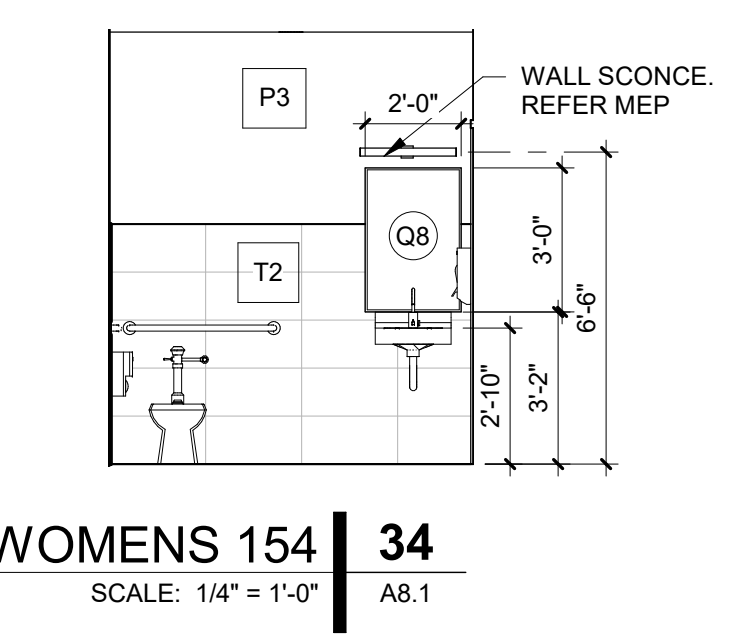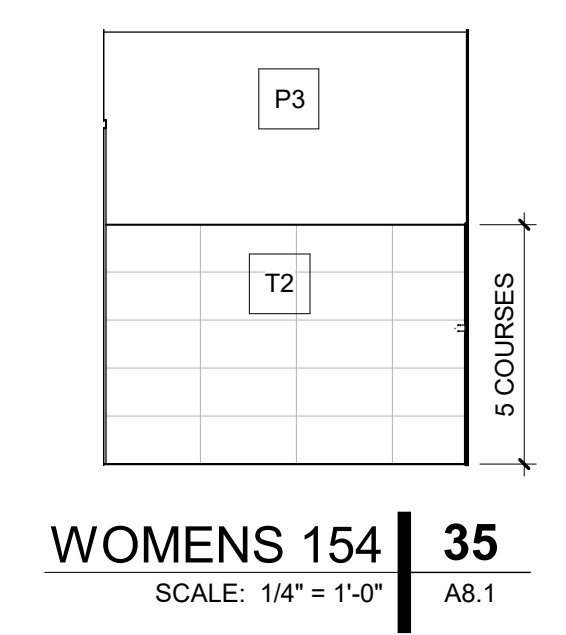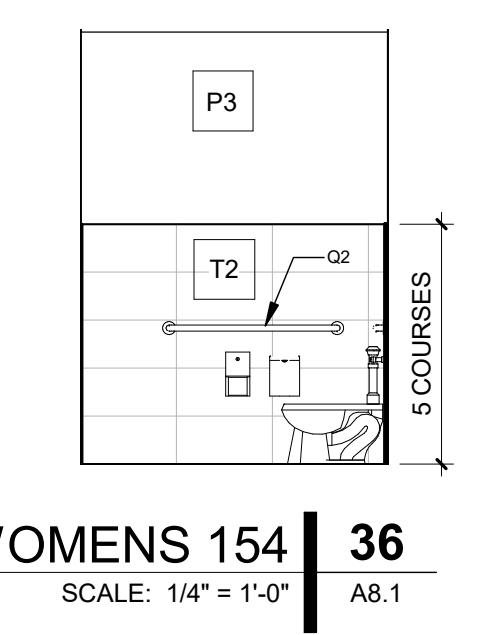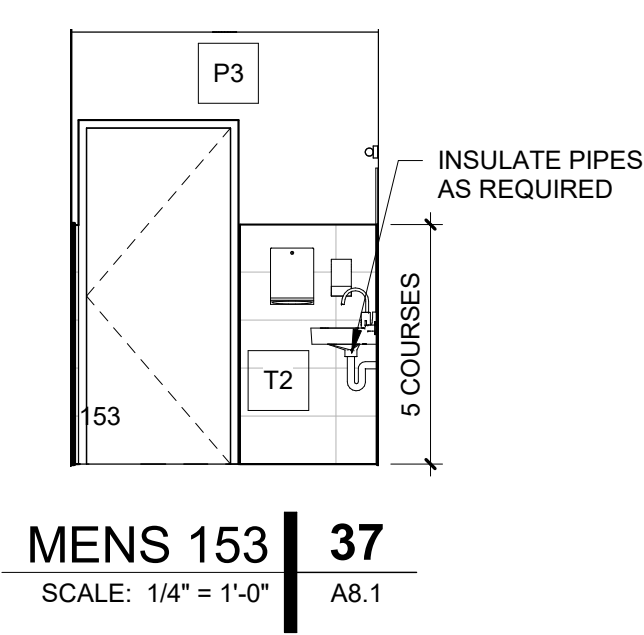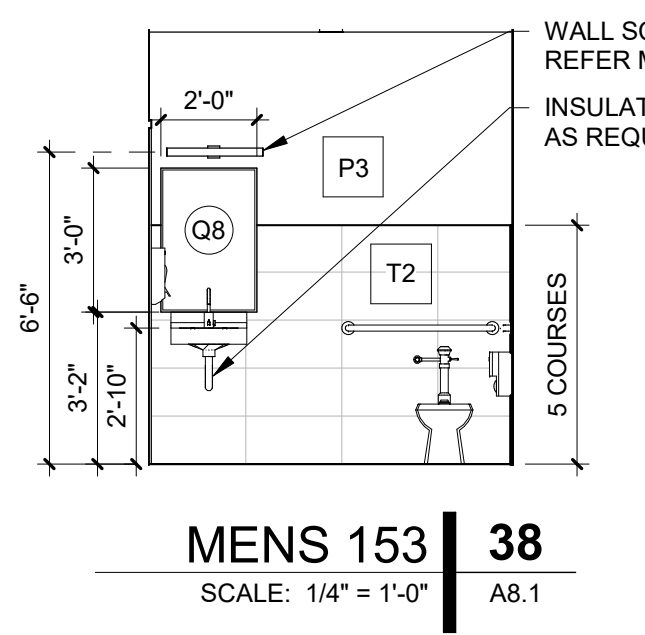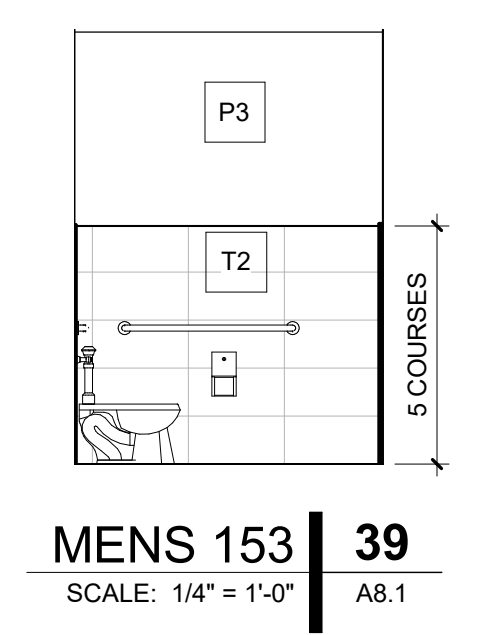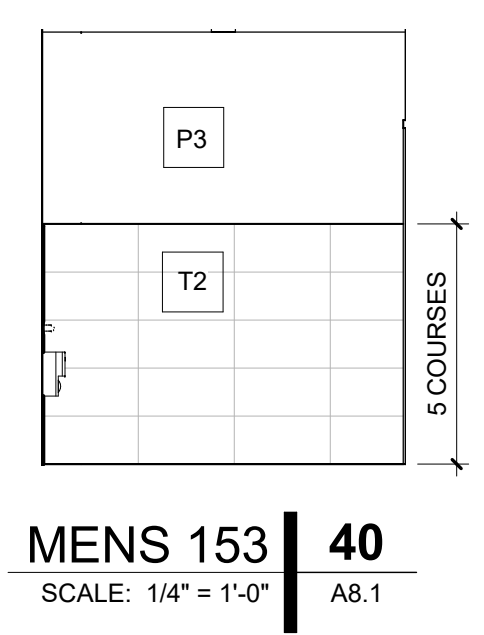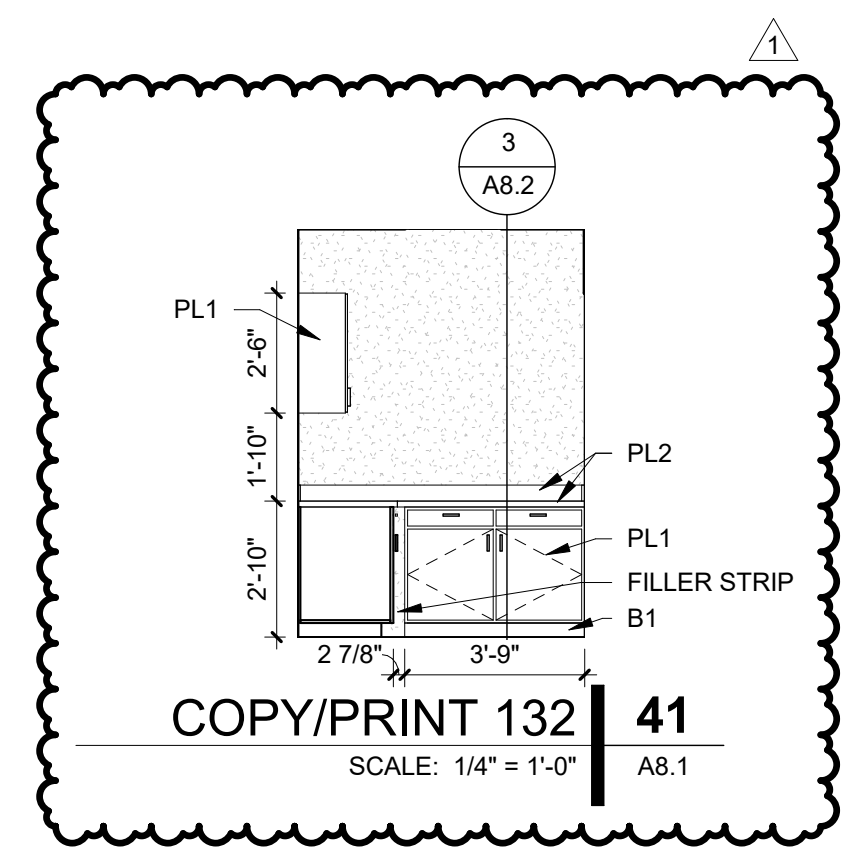

A NEW FACILITY FOR
**GREGG COUNTY - PARKING
GARAGE & OFFICE**
100 E. METHUEN ST.
LONGVIEW, TX 75601

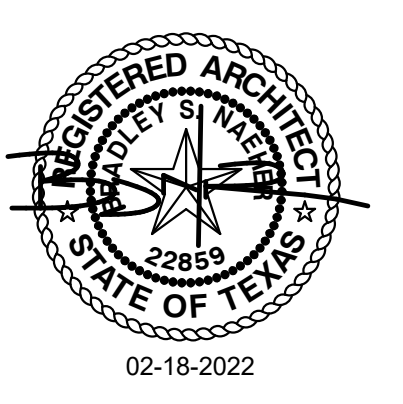

PROJECT NO.: 20011
DATE: 03/03/2022

REVISION SCHEDULE		
Δ	Description	Date
1	ADDENDUM 04	03-17-2022

SHEET NAME

INTERIOR ELEVATIONS

SHEET NO.

A8.1